


Work done during 1924 shown in Red.
 Work done previous to 1924 shown in Black.
 Raises and Winzes
 Chutes
 Manways
 Slides

LEGEND

- No 1 LEVEL
- No 2 LEVEL
- No 3 LEVEL
- No 4 LEVEL
- No 5 LEVEL
- No 6 LEVEL
- No 7 LEVEL
- No 8 LEVEL
- No 9 LEVEL
- No 10 LEVEL
- No 11 LEVEL
- No 12 LEVEL
- No 13 LEVEL
- No 14 LEVEL
- No 15 LEVEL
- No 16 LEVEL

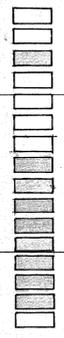

MAGNET SILVER MINING CO^y N. L.
PLAN OF UNDERGROUND WORKINGS


Scale 40 Feet to 1 Inch

FOR YEAR ENDING DECEMBER 1925⁴

GENERAL MANAGER
R. F. ...

MINE SURVEYOR
Edgar Brutchell

Surveyed with 5" Transit

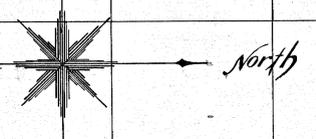

RC