

4078


2075
91 M
40 ac.

3705
87 M
20 ac.

MAGNET S. M. Co.

No 2. LEVEL

SCALE 25 FT. TO 1 IN.

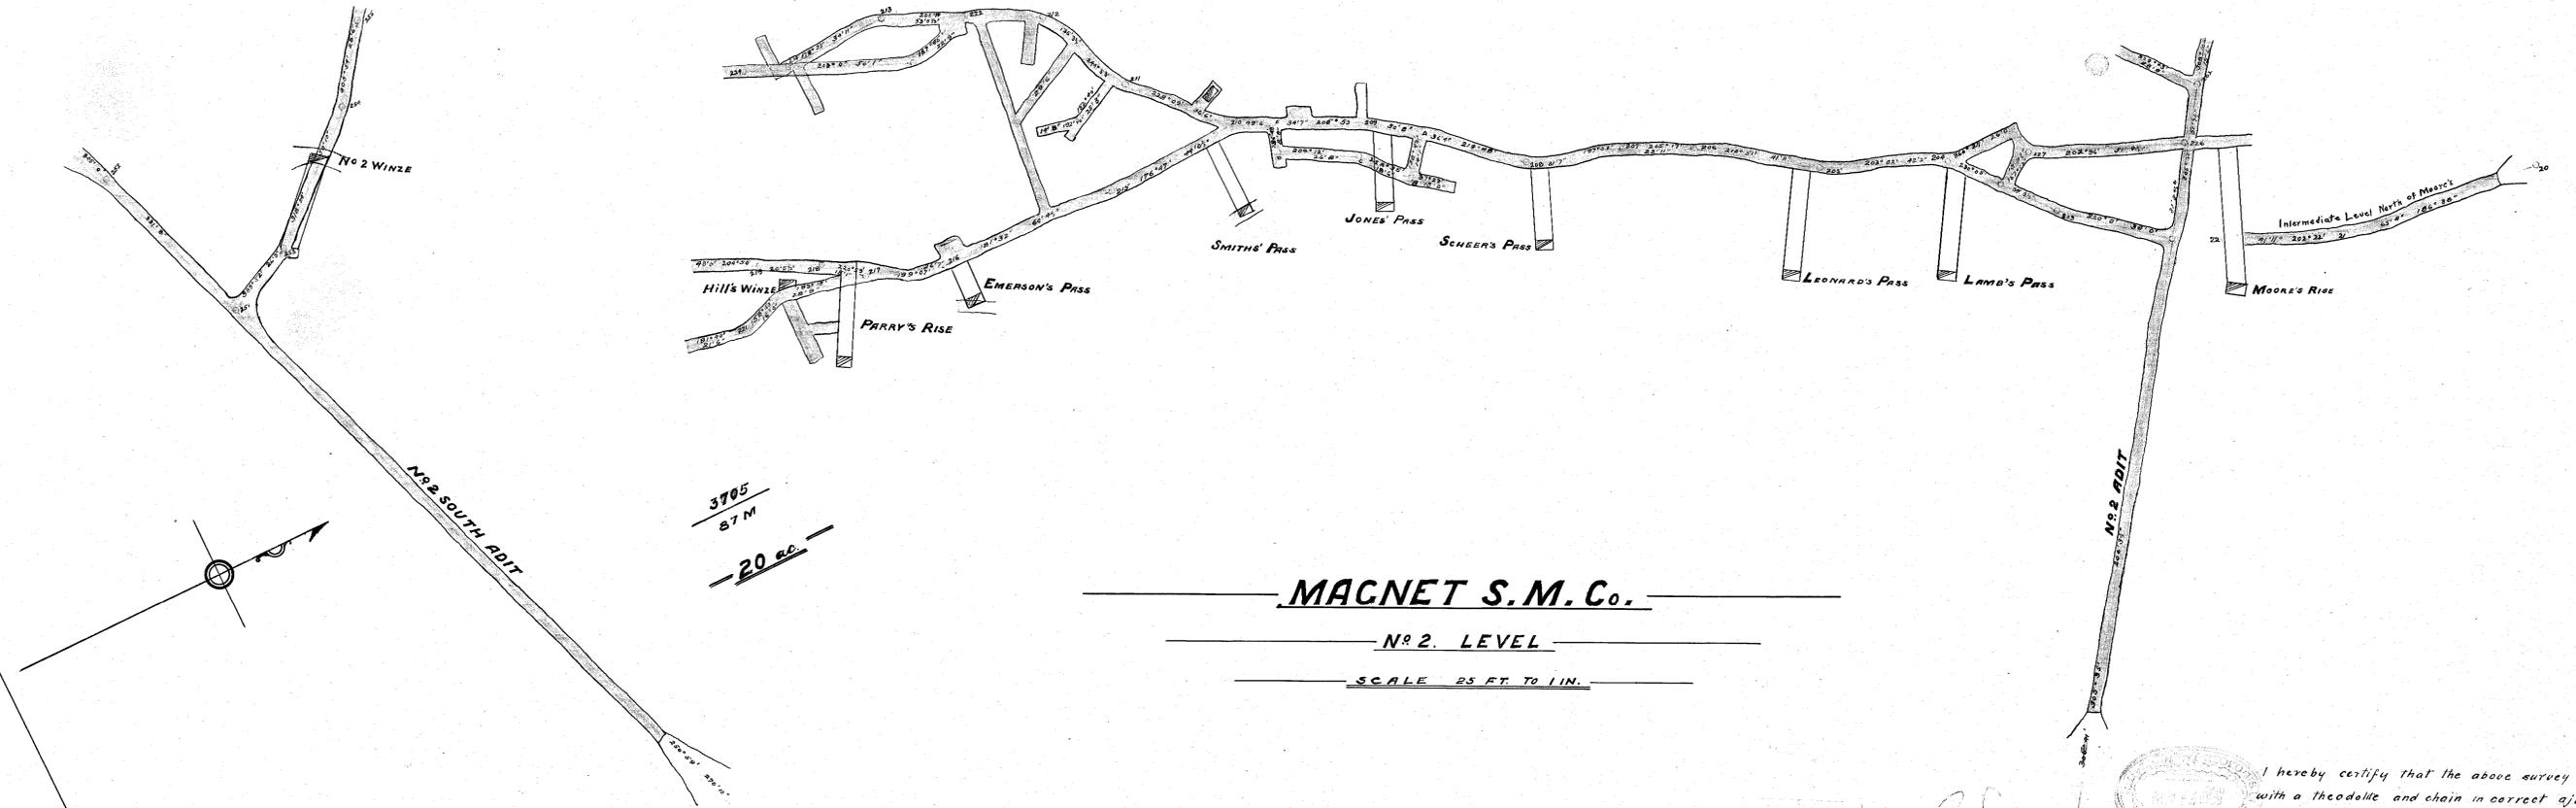

40-13

RC



I hereby certify that the above survey has been made with a theodolite and chain in correct adjustment, and is correct for the purposes of the Mining Act.

T. J. de B. [Signature], General Manager
 T. J. de B. [Signature]