
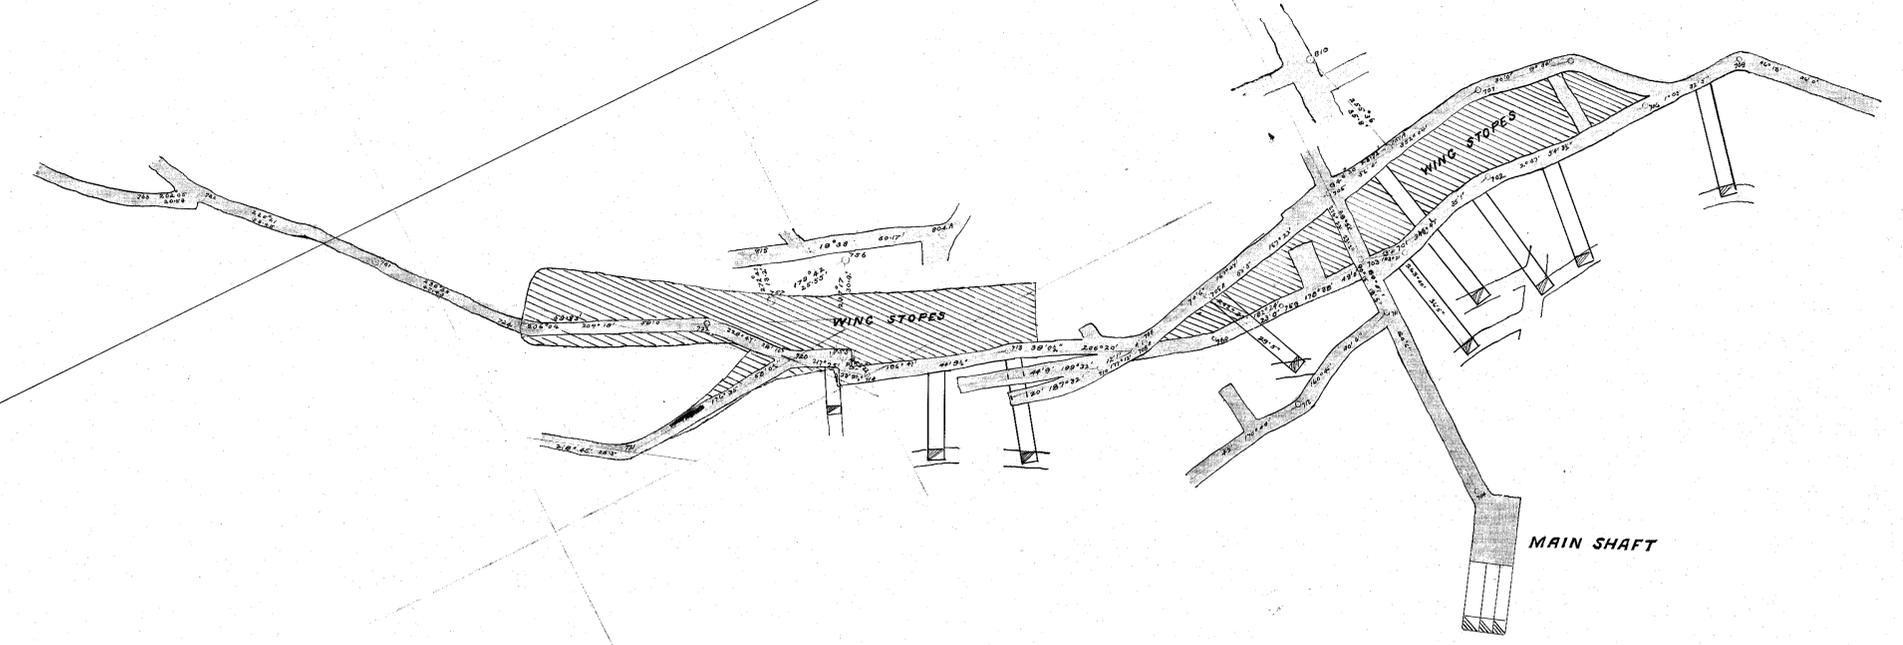


2075
91 M
40 ac.

3705
87 M
20 ac.

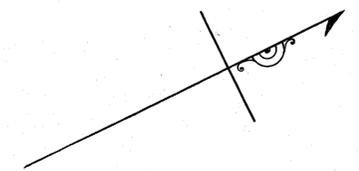

MACNET S. M. Co.

No. 7 LEVEL

SCALE 25 FT. TO IN.

I hereby certify that the above survey was made with a Sin. theodolite and steel tape in correct adjustment, and is correct for the purposes of the Mining Act.



Geo. McPeak Certified Mine Manager
General Manager
Jany 1900
E. J. de Lantier 1910
E. J. de Lantier 1911
E. J. de Lantier 1912

40-19

5 cm