


2075
81 M
40 ac

3705
87 M
20 ac

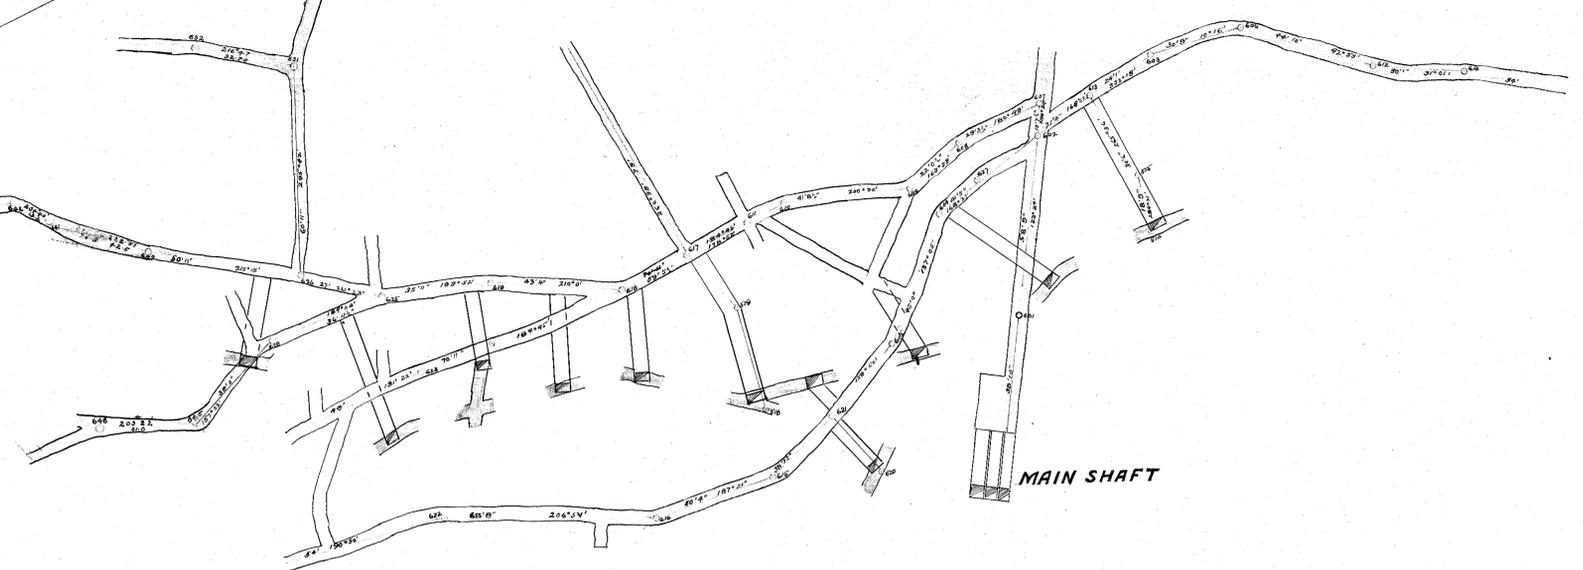

MAGNET S.M. Co.

No. 6 LEVEL

SCALE 25 FT. TO 1 IN.

I hereby certify that the above survey was made with a theodolite and chain in correct adjustment and is correct for the purposes of the Mining Act.

T. L. de Rouville, 1910, General Manager
T. L. de Rouville, 1911, "
T. L. de Rouville, 1912, "
T. L. de Rouville, 1913, "



40-20

5 m