


40-21

5 cm

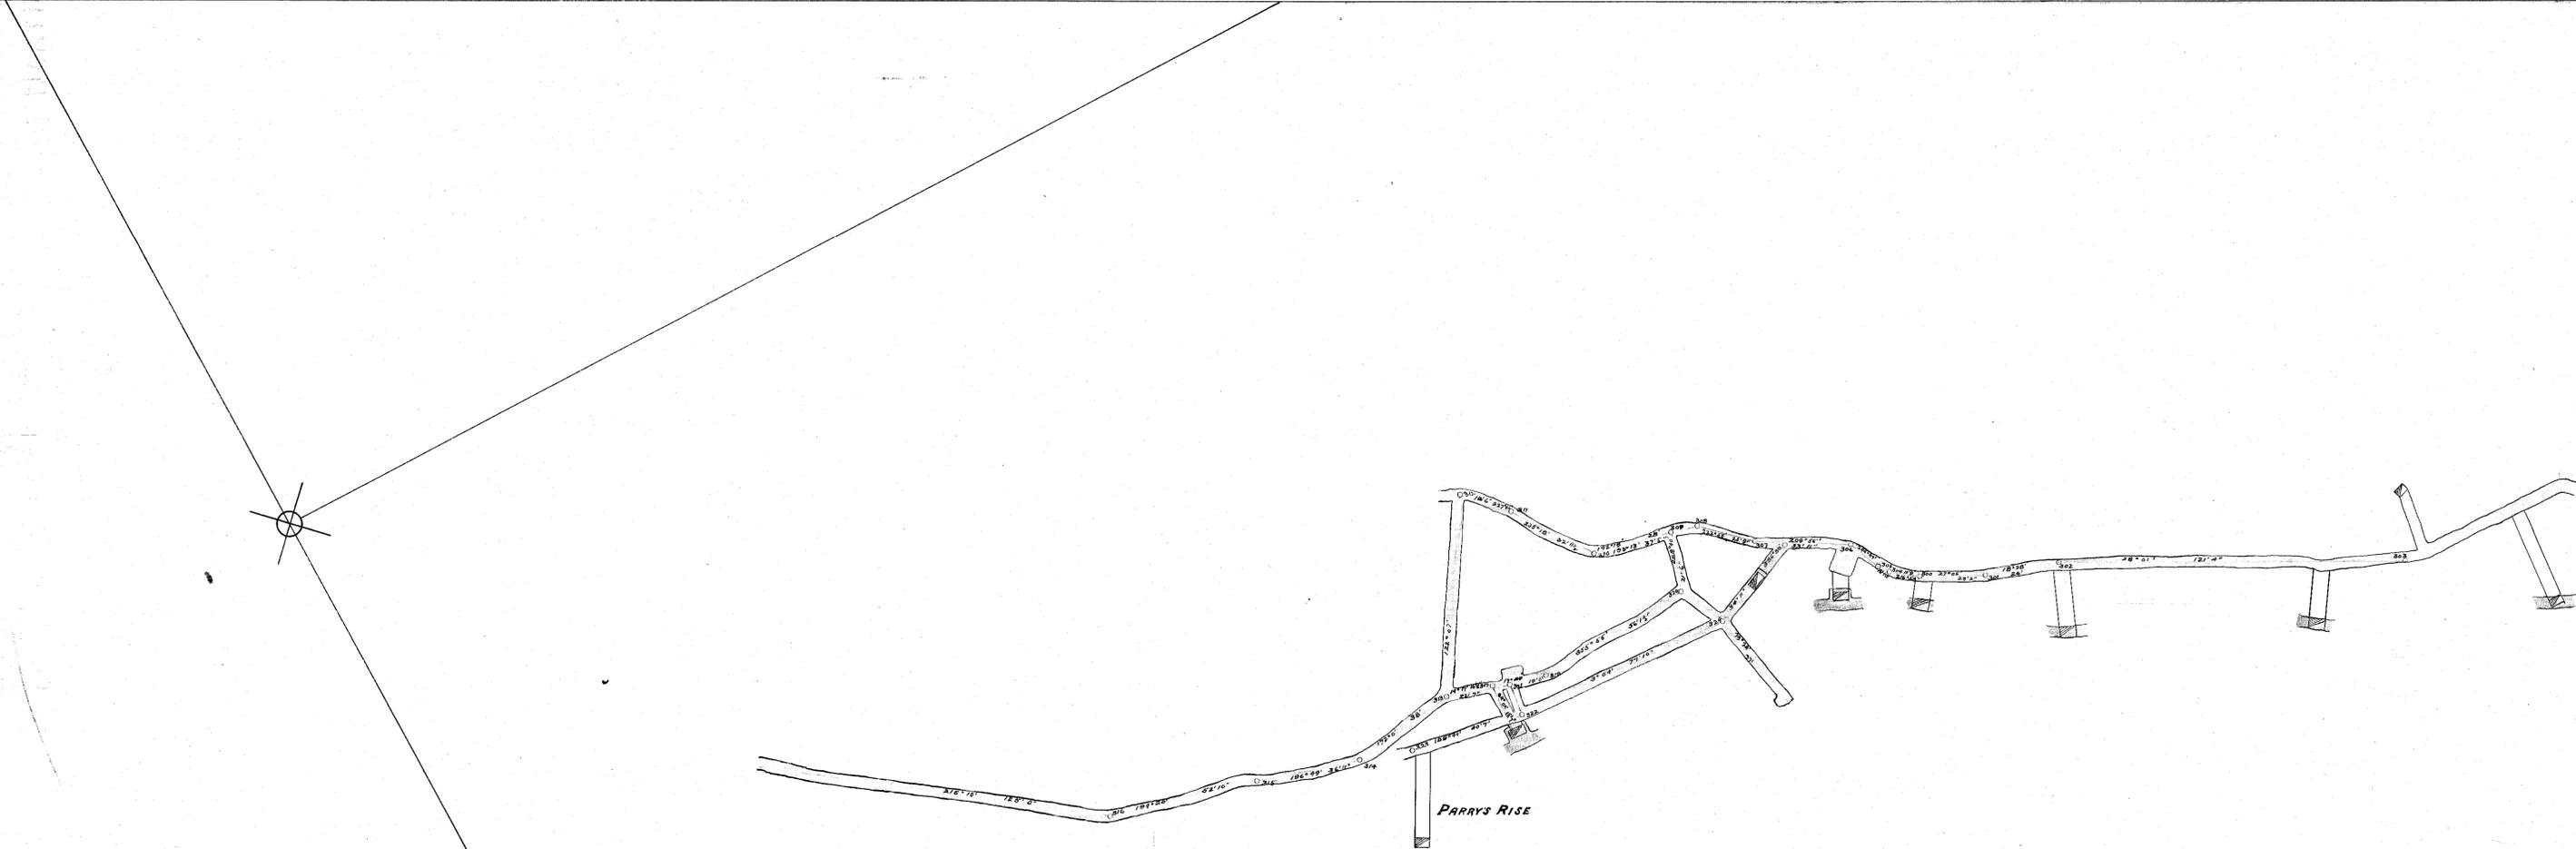

$\frac{2075}{91 M}$   
 40 AC.

$\frac{3705}{87 M}$   
 20 AC.

**MAGNET S. M. Co.**

**N<sup>o</sup> 3 LEVEL**

SCALE 25 FT. TO 1 IN.

I hereby certify that the above survey was made with a theodolite and chain and is correct for the purposes of the Mining Act.

T. J. de Lantier, General Manager  
 T. J. de Lantier, 1910  
 T. J. de Lantier, 1911  
 T. J. de Lantier, 1912



RC