


70-07

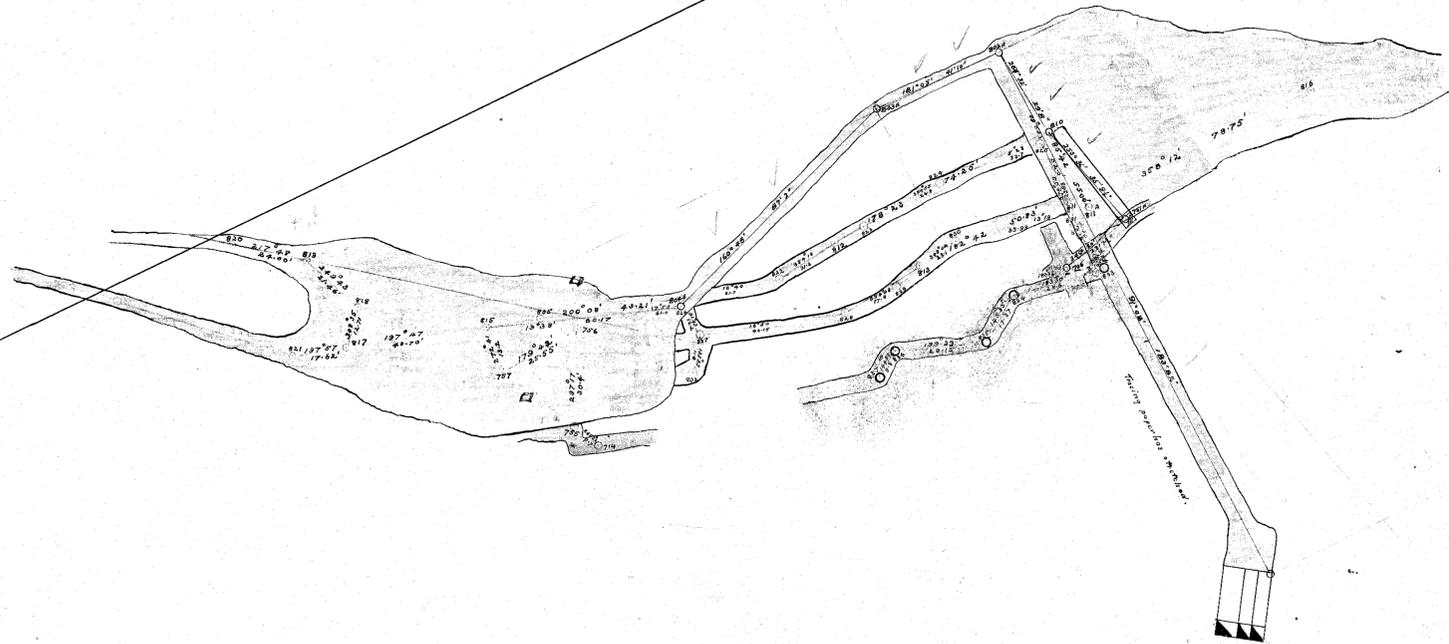

2075
91M
40 ac.

3705
87M
20 ac.

MAGNET S. M. Co.

N^o 8 LEVEL

SCALE 25 FT. TO 1 IN.

RC



I hereby certify that the above survey was made with a 5" theodolite and steel tape in correct adjustment, and is correct for the purposes of the Mining Act.

J. H. Blake Certified Mine Manager.

E. J. de Rouville General Manager
 Jany 1909
E. J. de Rouville 1911
E. J. de Rouville 1914

40-22

5 cm