
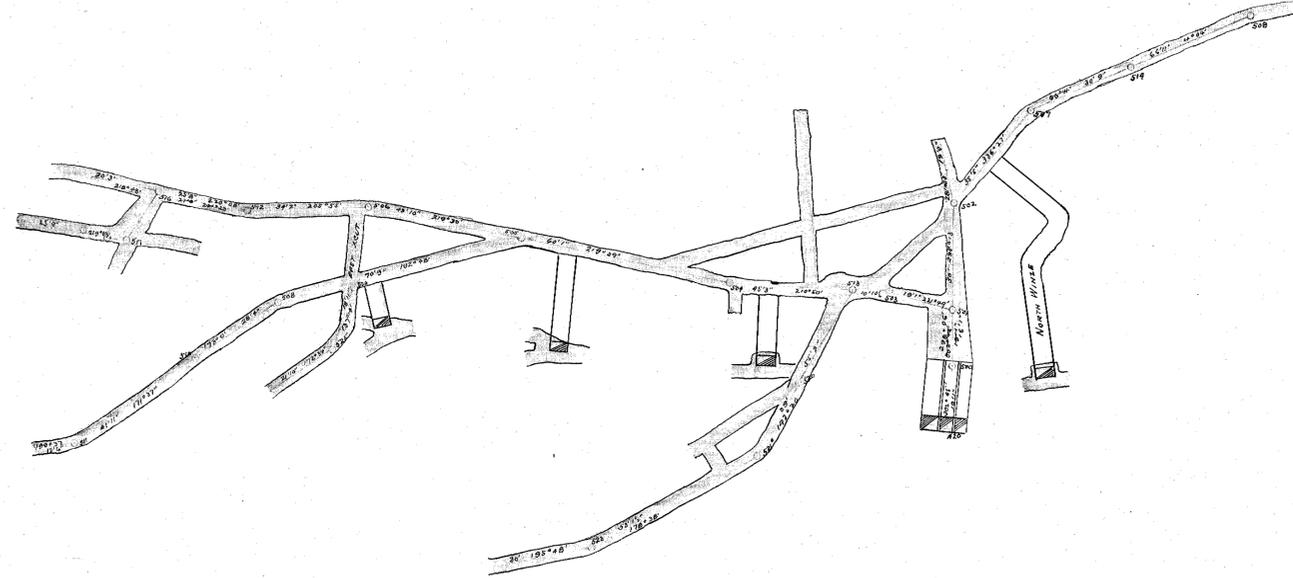


5 cm

2075
81 M
40 ac.

3705
87 M
20 ac.

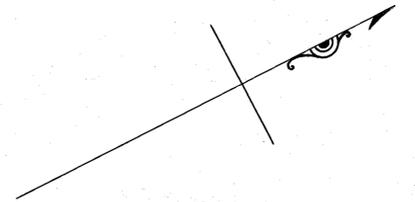

MACNET S.M.Co.

Nº 5 LEVEL

SCALE 25 FT. TO 1 IN.

RC



I hereby certify that the above survey was made with a theodolite and chain, in correct adjustment and is correct for the purposes of the Mining Act

E. A. de Roussier,	General Manager
E. A. de Roussier 1910	"
E. A. de Roussier 1911	"
E. A. de Roussier 1912	"

40-23