


40-25

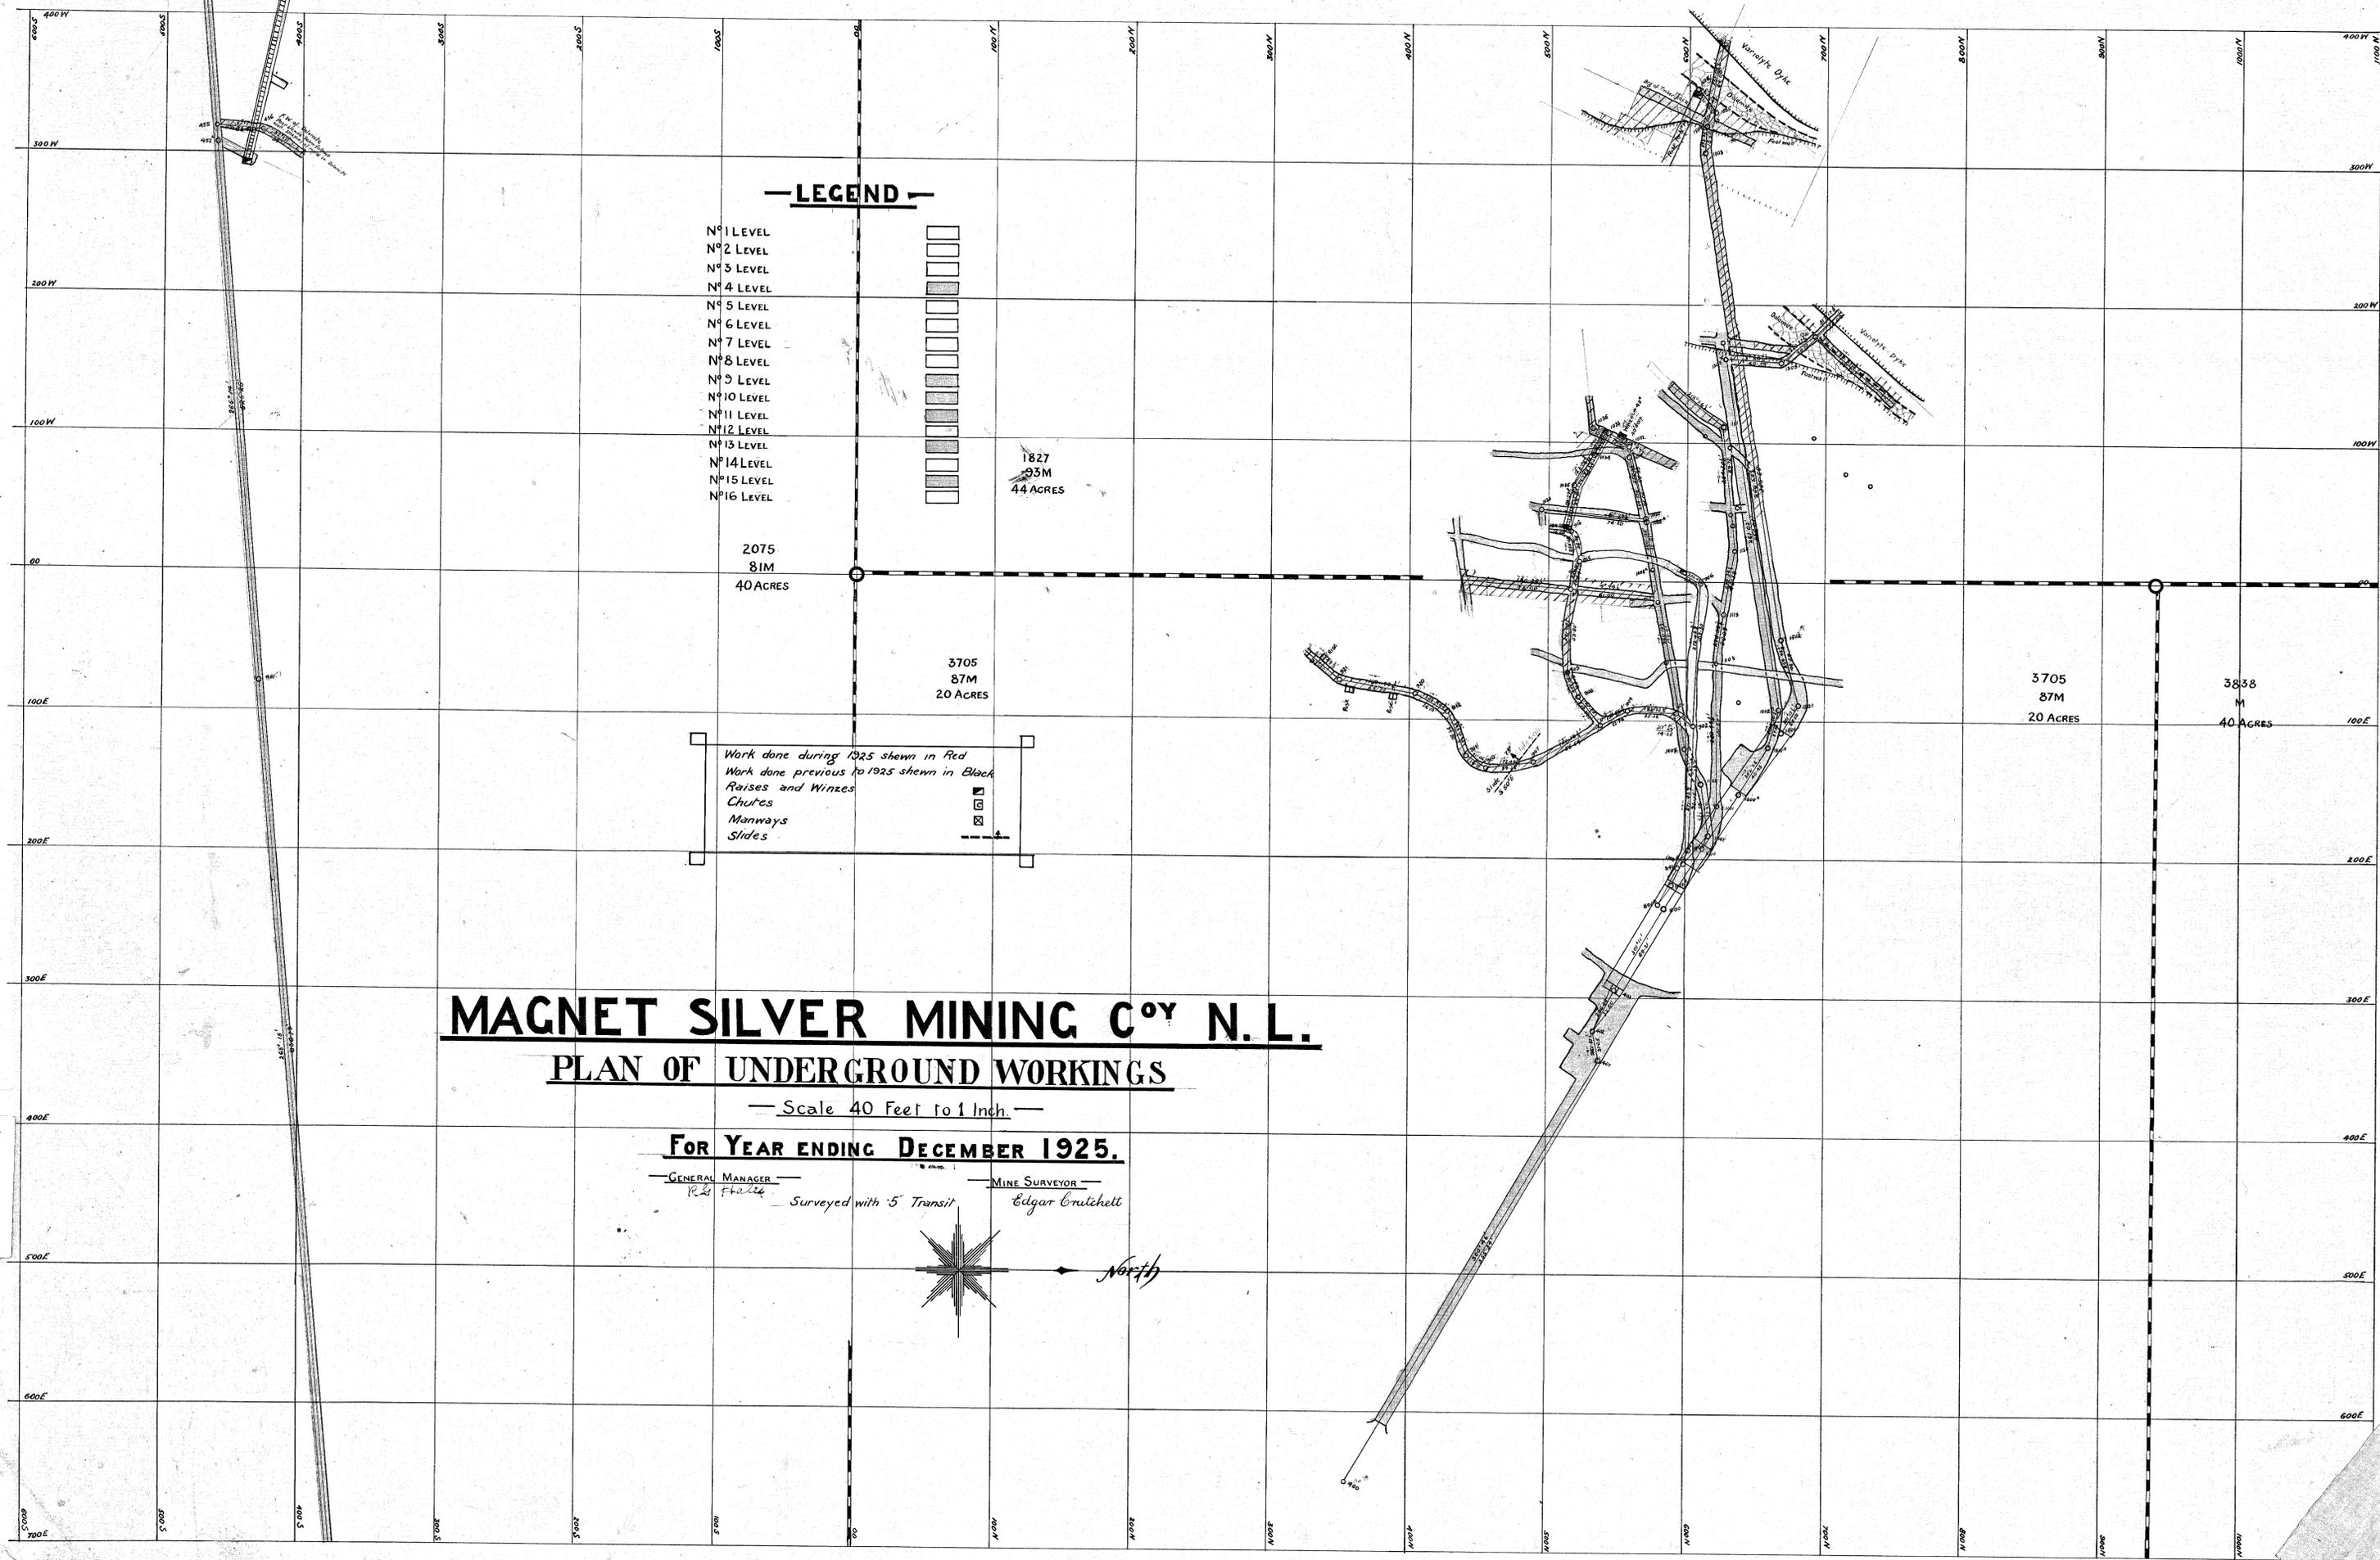

**— LEGEND —**

- N° 1 LEVEL
- N° 2 LEVEL
- N° 3 LEVEL
- N° 4 LEVEL
- N° 5 LEVEL
- N° 6 LEVEL
- N° 7 LEVEL
- N° 8 LEVEL
- N° 9 LEVEL
- N° 10 LEVEL
- N° 11 LEVEL
- N° 12 LEVEL
- N° 13 LEVEL
- N° 14 LEVEL
- N° 15 LEVEL
- N° 16 LEVEL

2075  
81M  
40 ACRES

1827  
93M  
44 ACRES

3705  
87M  
20 ACRES

3705  
87M  
20 ACRES

3838  
M  
40 ACRES

Work done during 1925 shown in Red  
 Work done previous to 1925 shown in Black  
 Raises and Winzes  
 Chutes  
 Manways  
 Slides

**MAGNET SILVER MINING CO. N. L.**  
**PLAN OF UNDERGROUND WORKINGS**

— Scale 40 Feet to 1 Inch. —

**FOR YEAR ENDING DECEMBER 1925.**

— GENERAL MANAGER — *R. L. Faller*  
 — MINE SURVEYOR — *Edgar Crutchett*  
*Surveyed with '5' Transit*

