


40-26

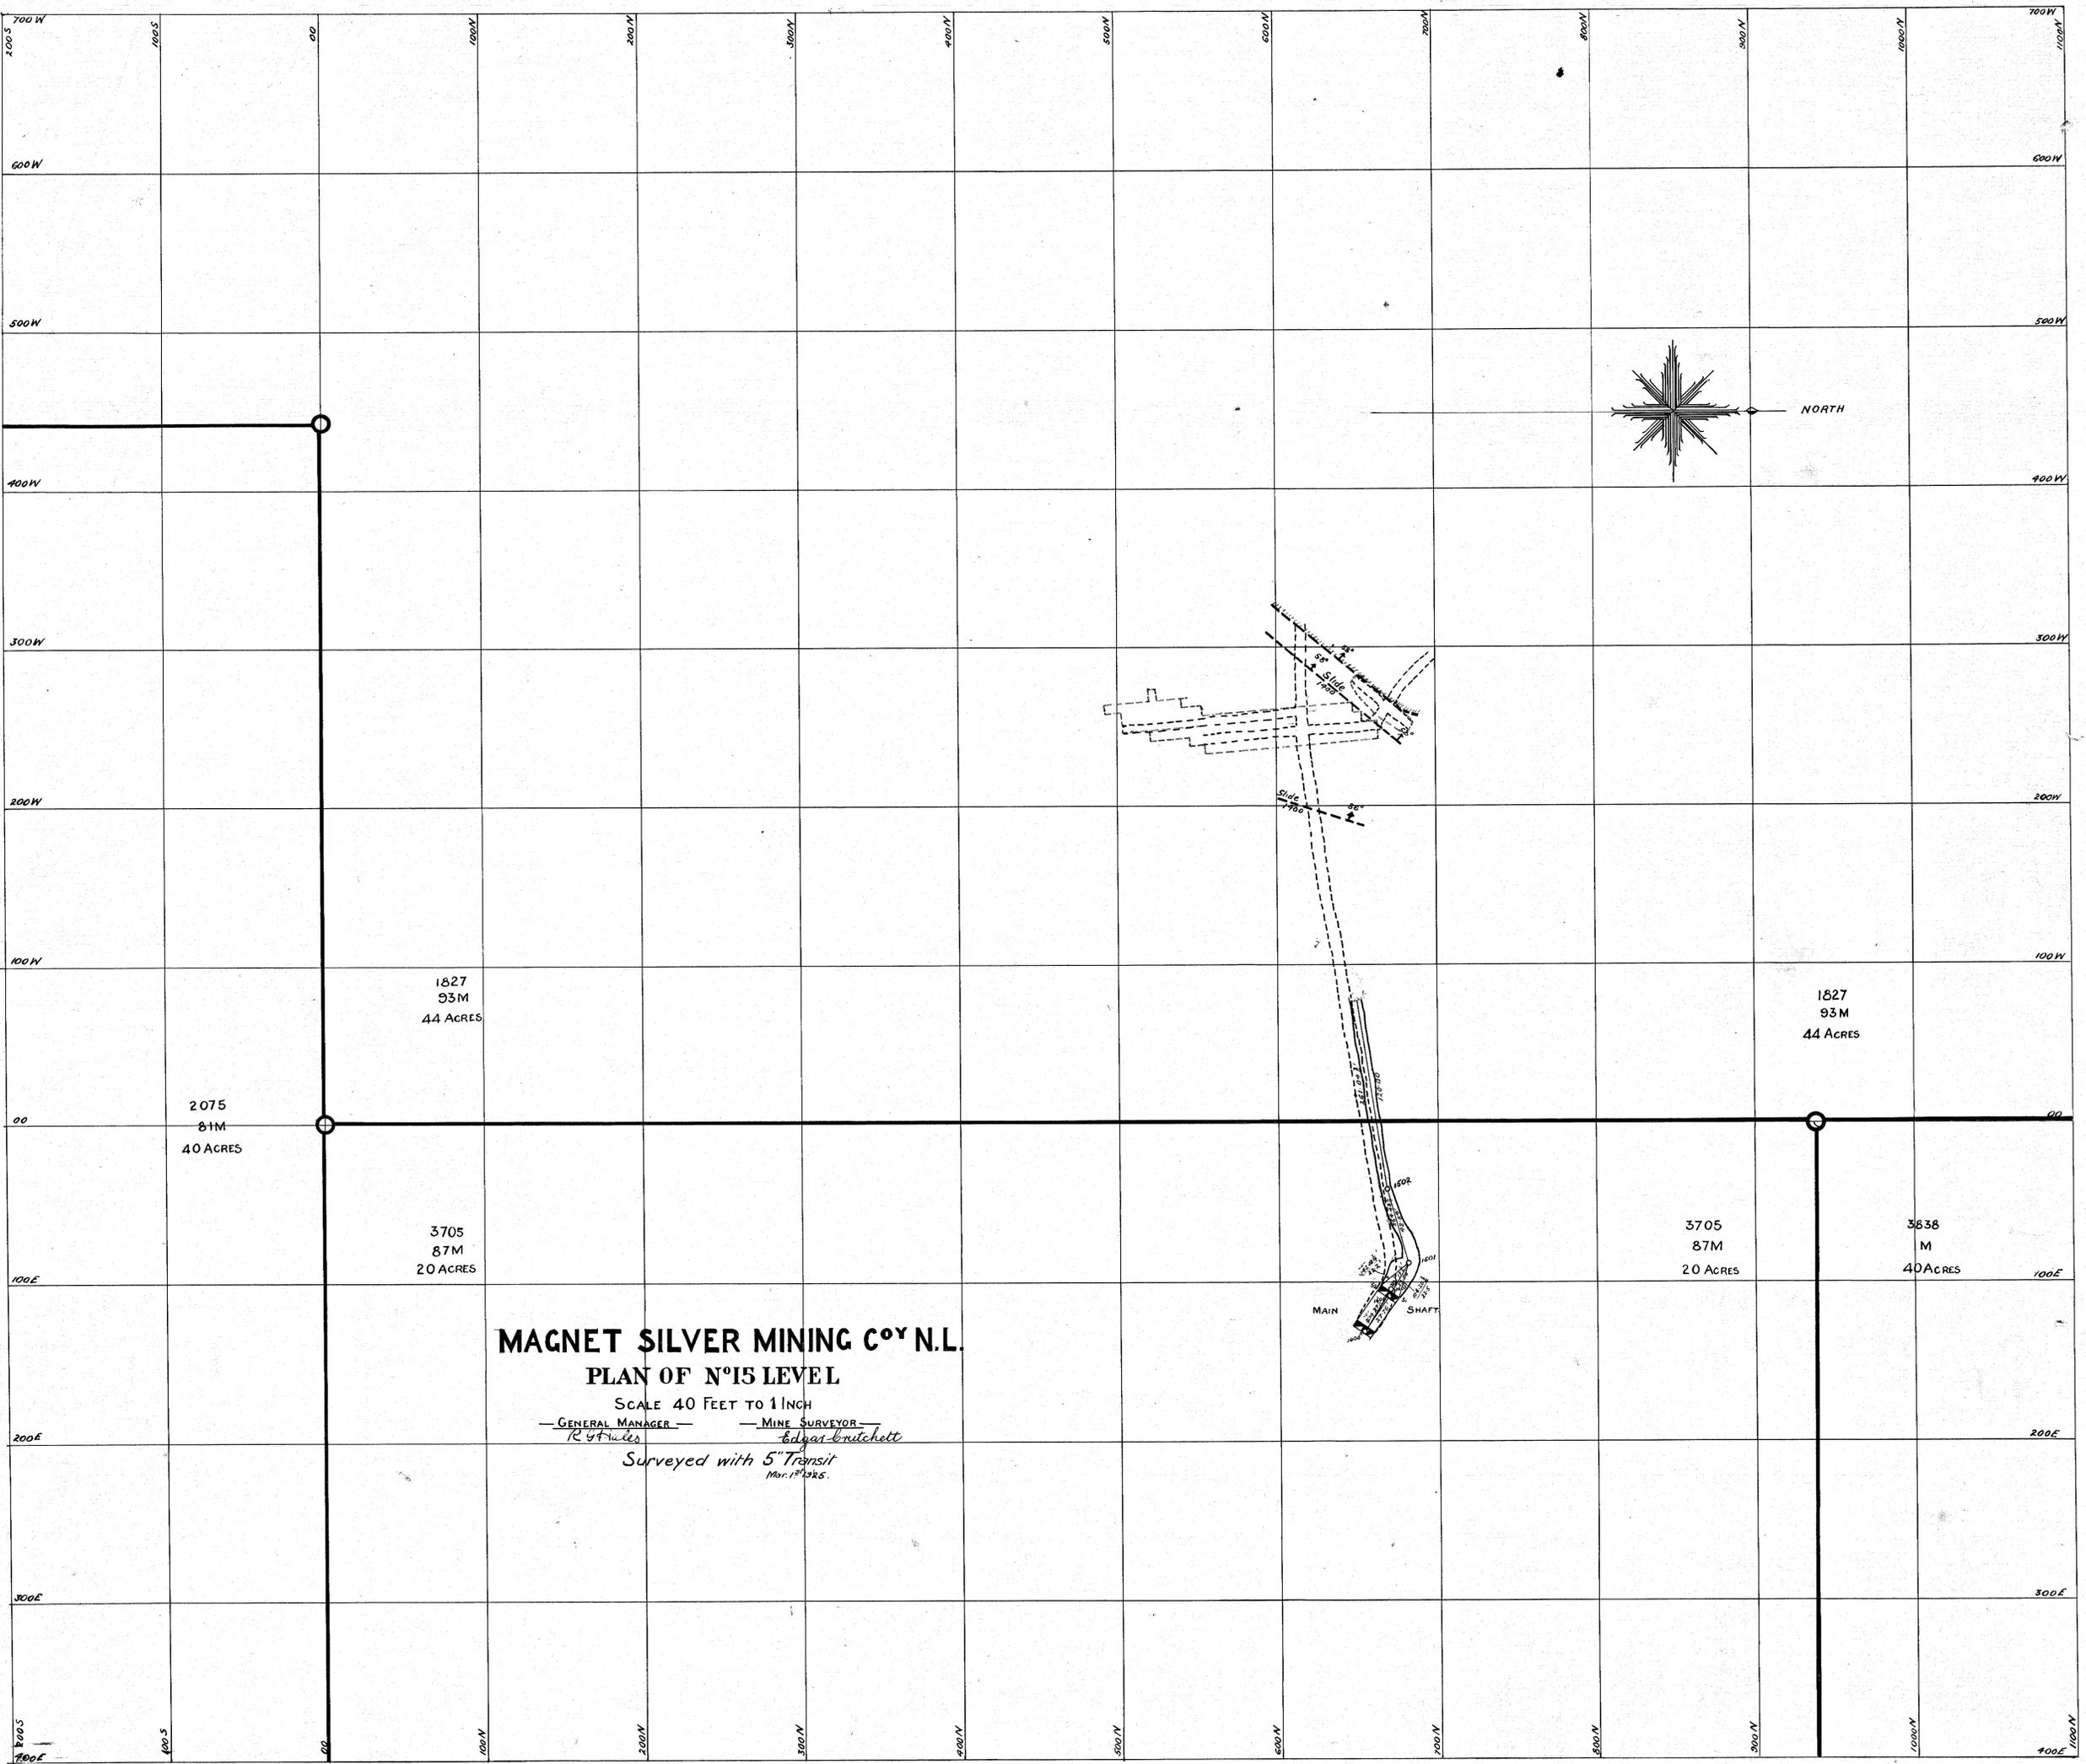

**MAGNET SILVER MINING CO. N.L.**

**PLAN OF N°15 LEVEL**

SCALE 40 FEET TO 1 INCH

— GENERAL MANAGER — — MINE SURVEYOR —  
*R. H. Jones* *Edgar Knitchett*

Surveyed with 5" Transit  
 Mar. 12/1905.

5 cm