

MAGNET SILVER MINING COY N.L.
LONGITUDINAL SECTION OF WORKINGS


Scale 40 Feet to 1 Inch

NOTE: Section taken along North and South Section Lines
Hanging Wall Slopes shown thus
Footwall Slopes shown thus
East Lobe Slopes shown thus
Work done for Year ending December 1925 shown in Red



GENERAL MANAGER

MINE SURVEYOR
Edgar Brutchett

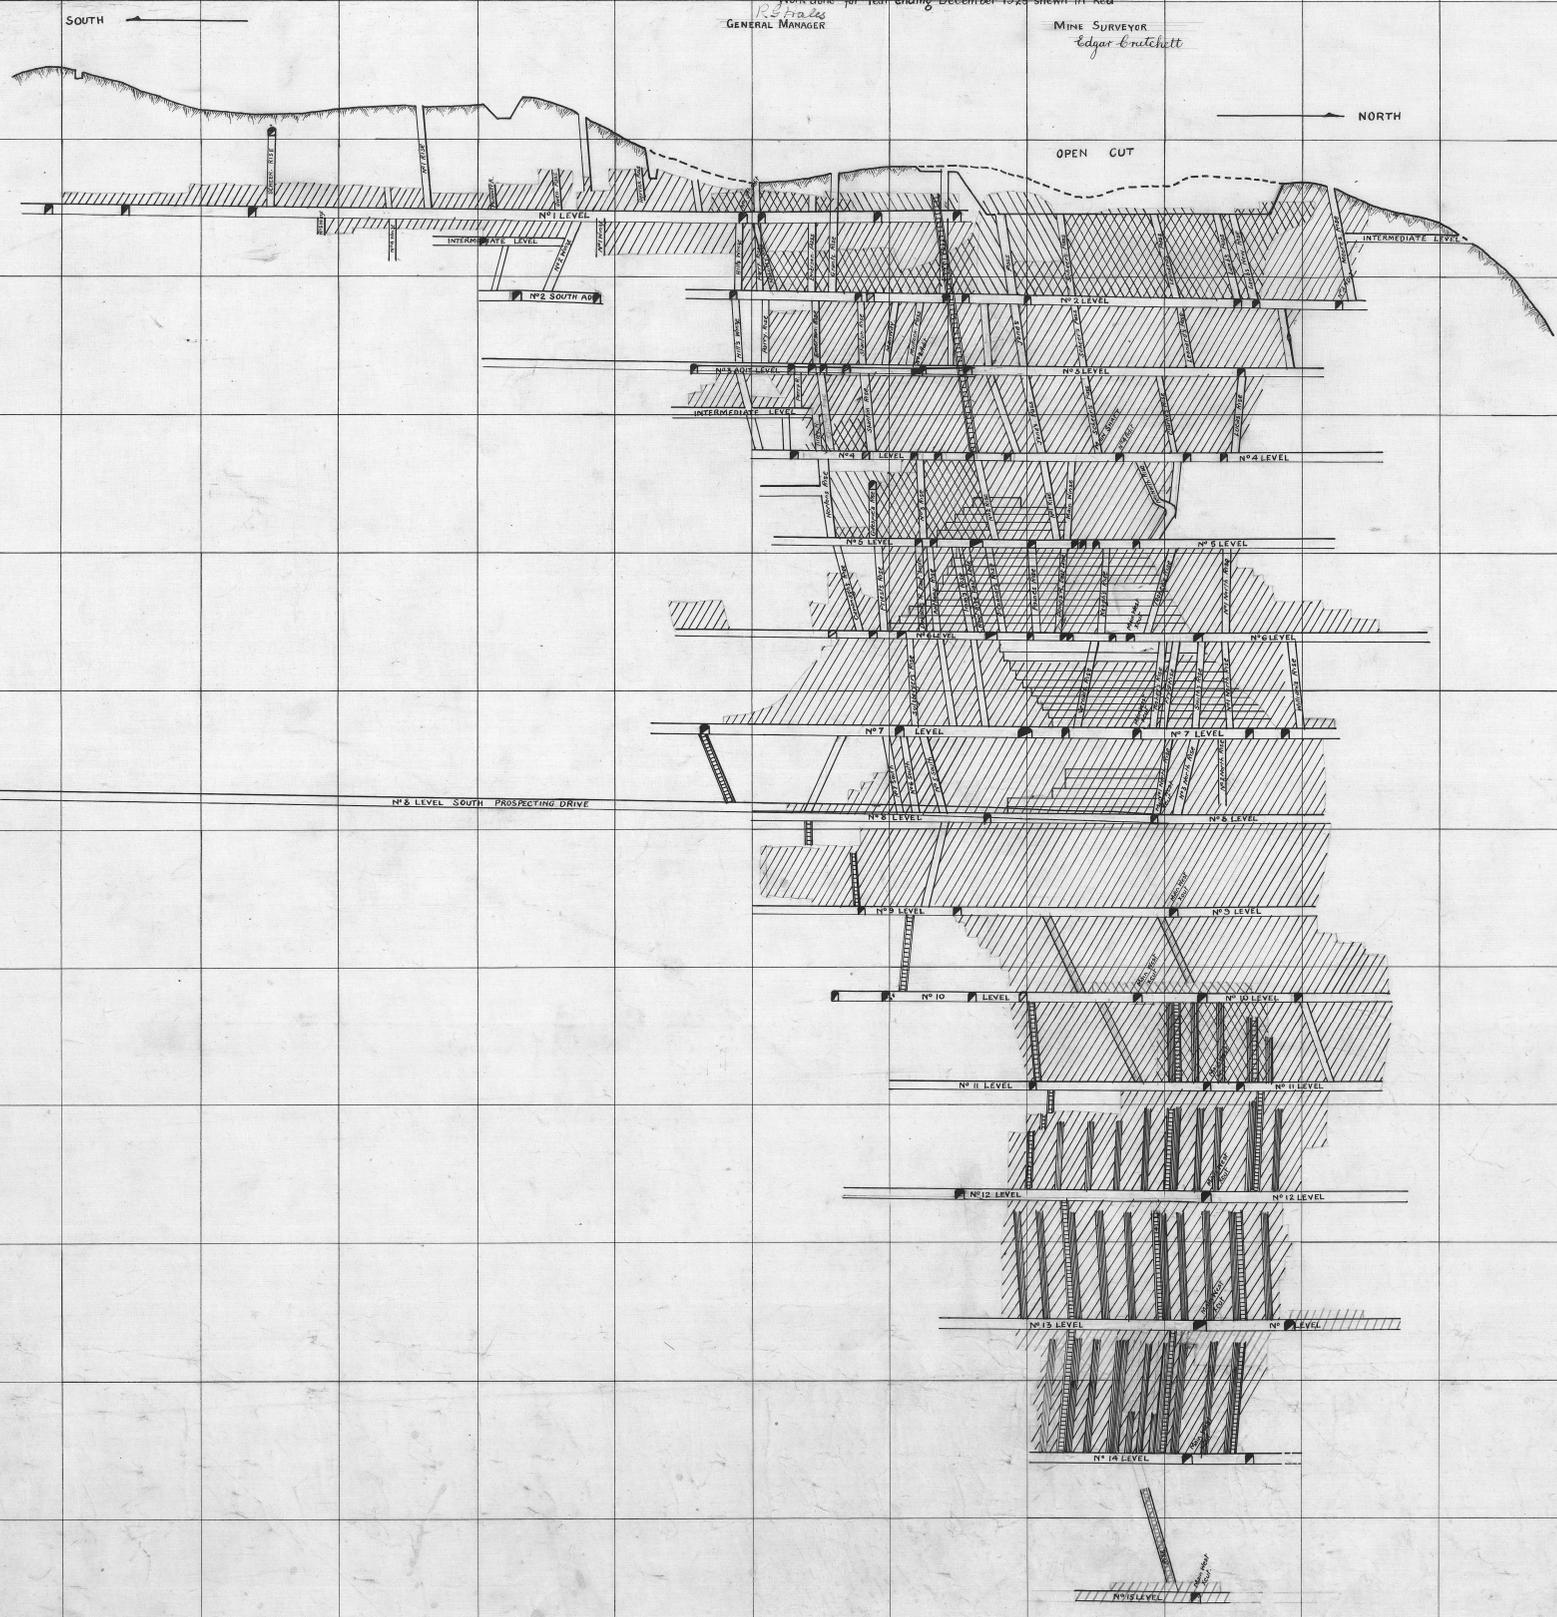

5000 ft