


5 cm

MAGNET MINE

No. 11 Level, Back Lode, N.

Scale 25 Feet to One Inch
B.D. Harrison Mine Manager 10.3.33

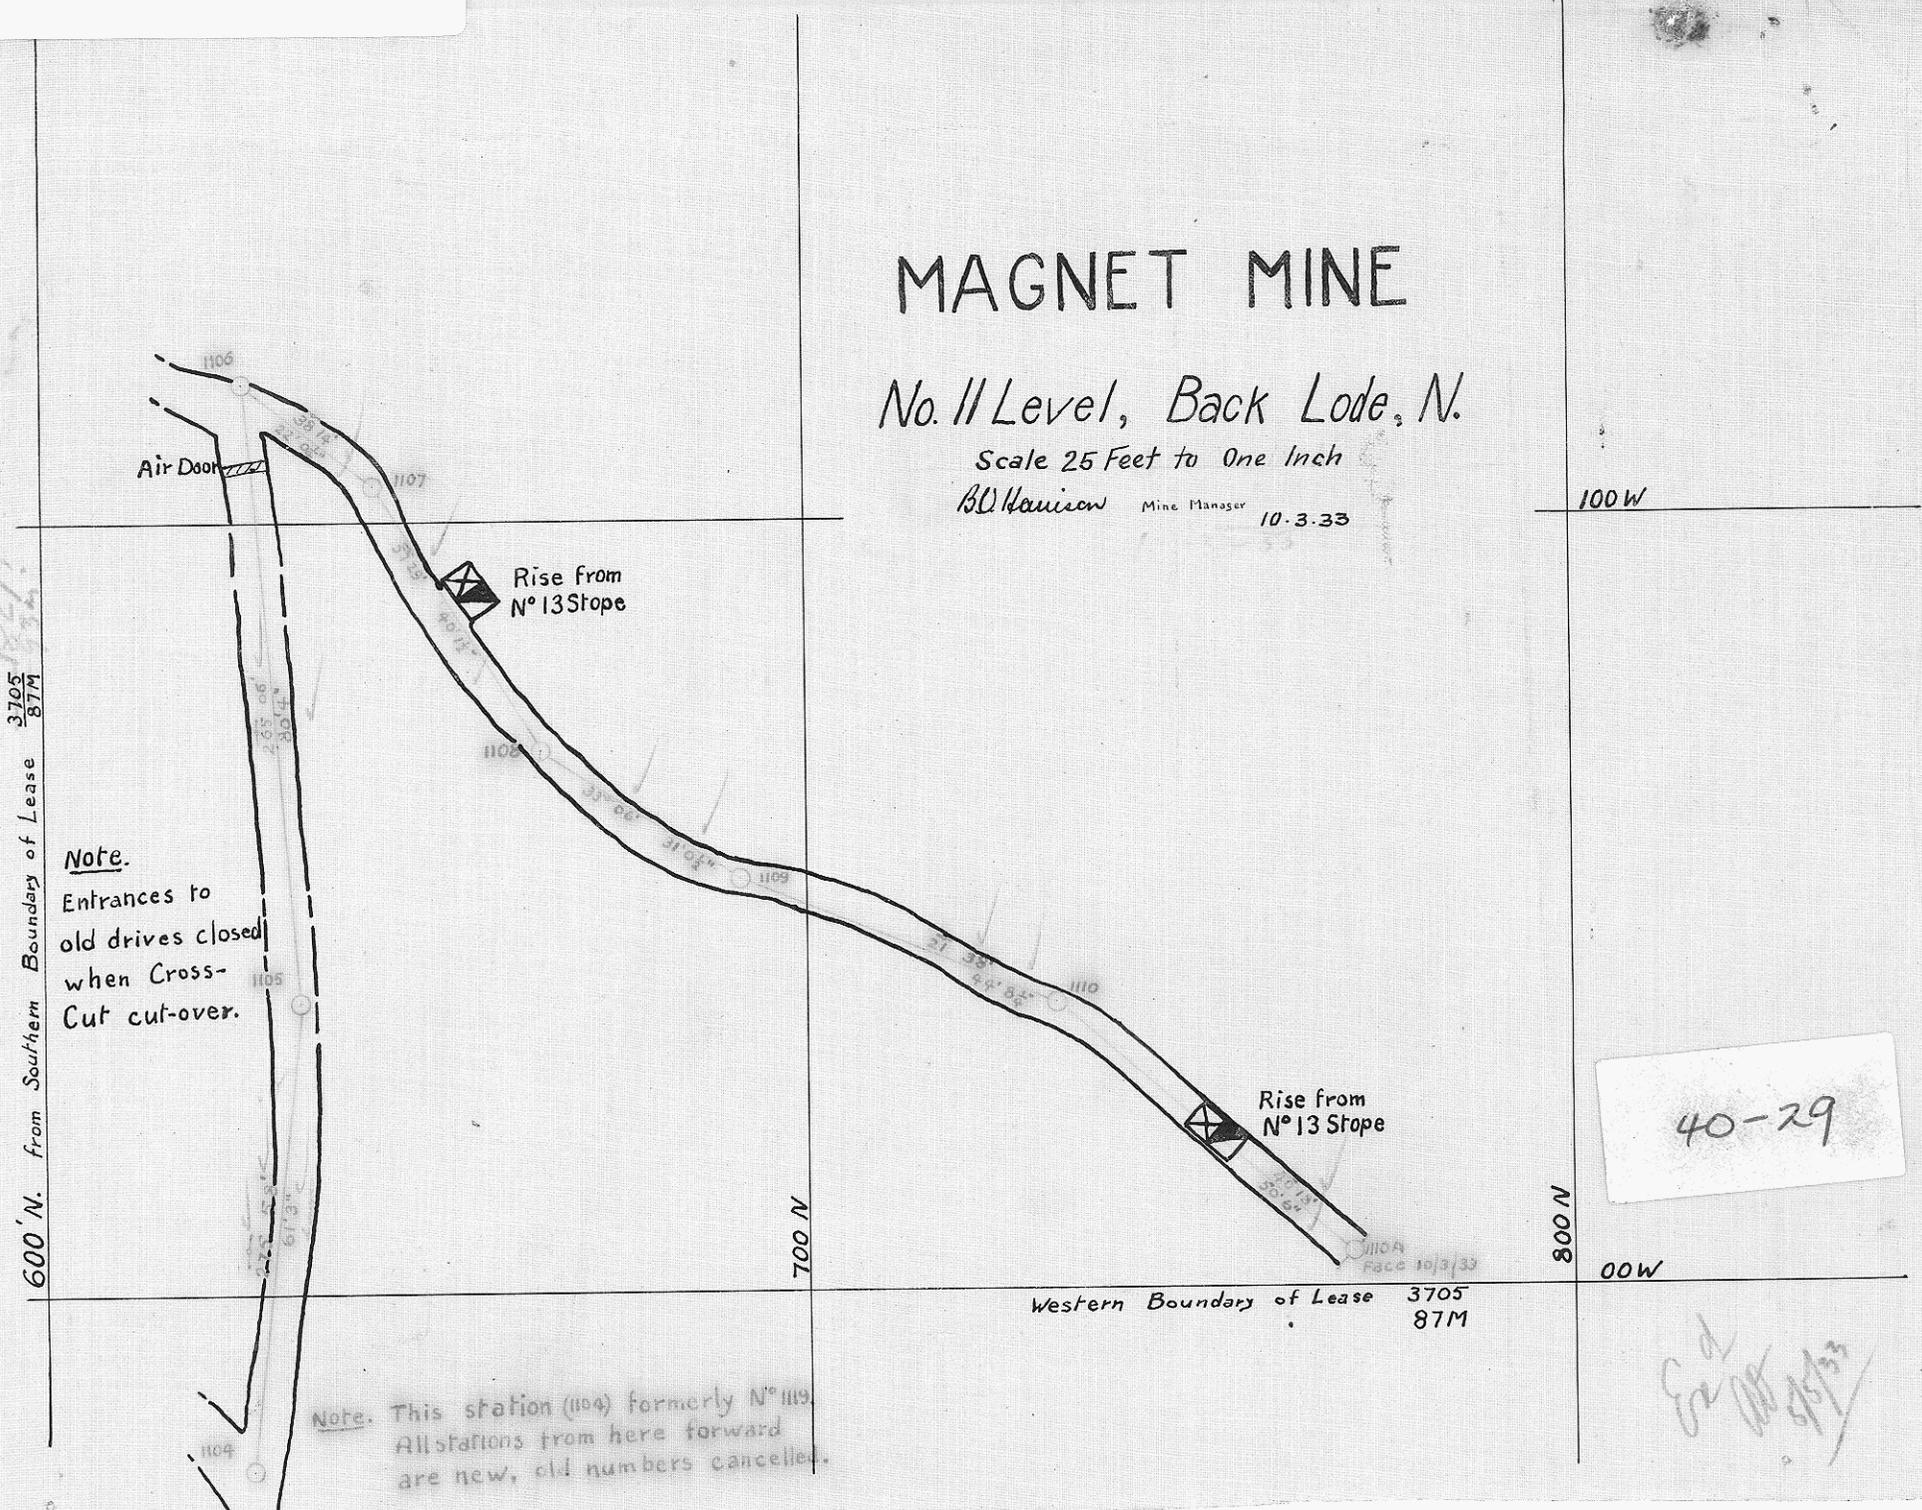

Note.
Entrances to
old drives closed
when Cross-
Cut cut-over.

Note. This station (1104) formerly N° 1109.
All stations from here forward
are new, old numbers cancelled.

100 W

800 N

00 W

Western Boundary of Lease 3705 87M

40-29

Ed
10/3/33