


MAGNET MINE.  
ELEVATION OF LOWER LEVELS  
Showing Stopes as at 31st. March 1933.

B.D. Haiscow Mine Manager

B.M. Del. 13/4/33

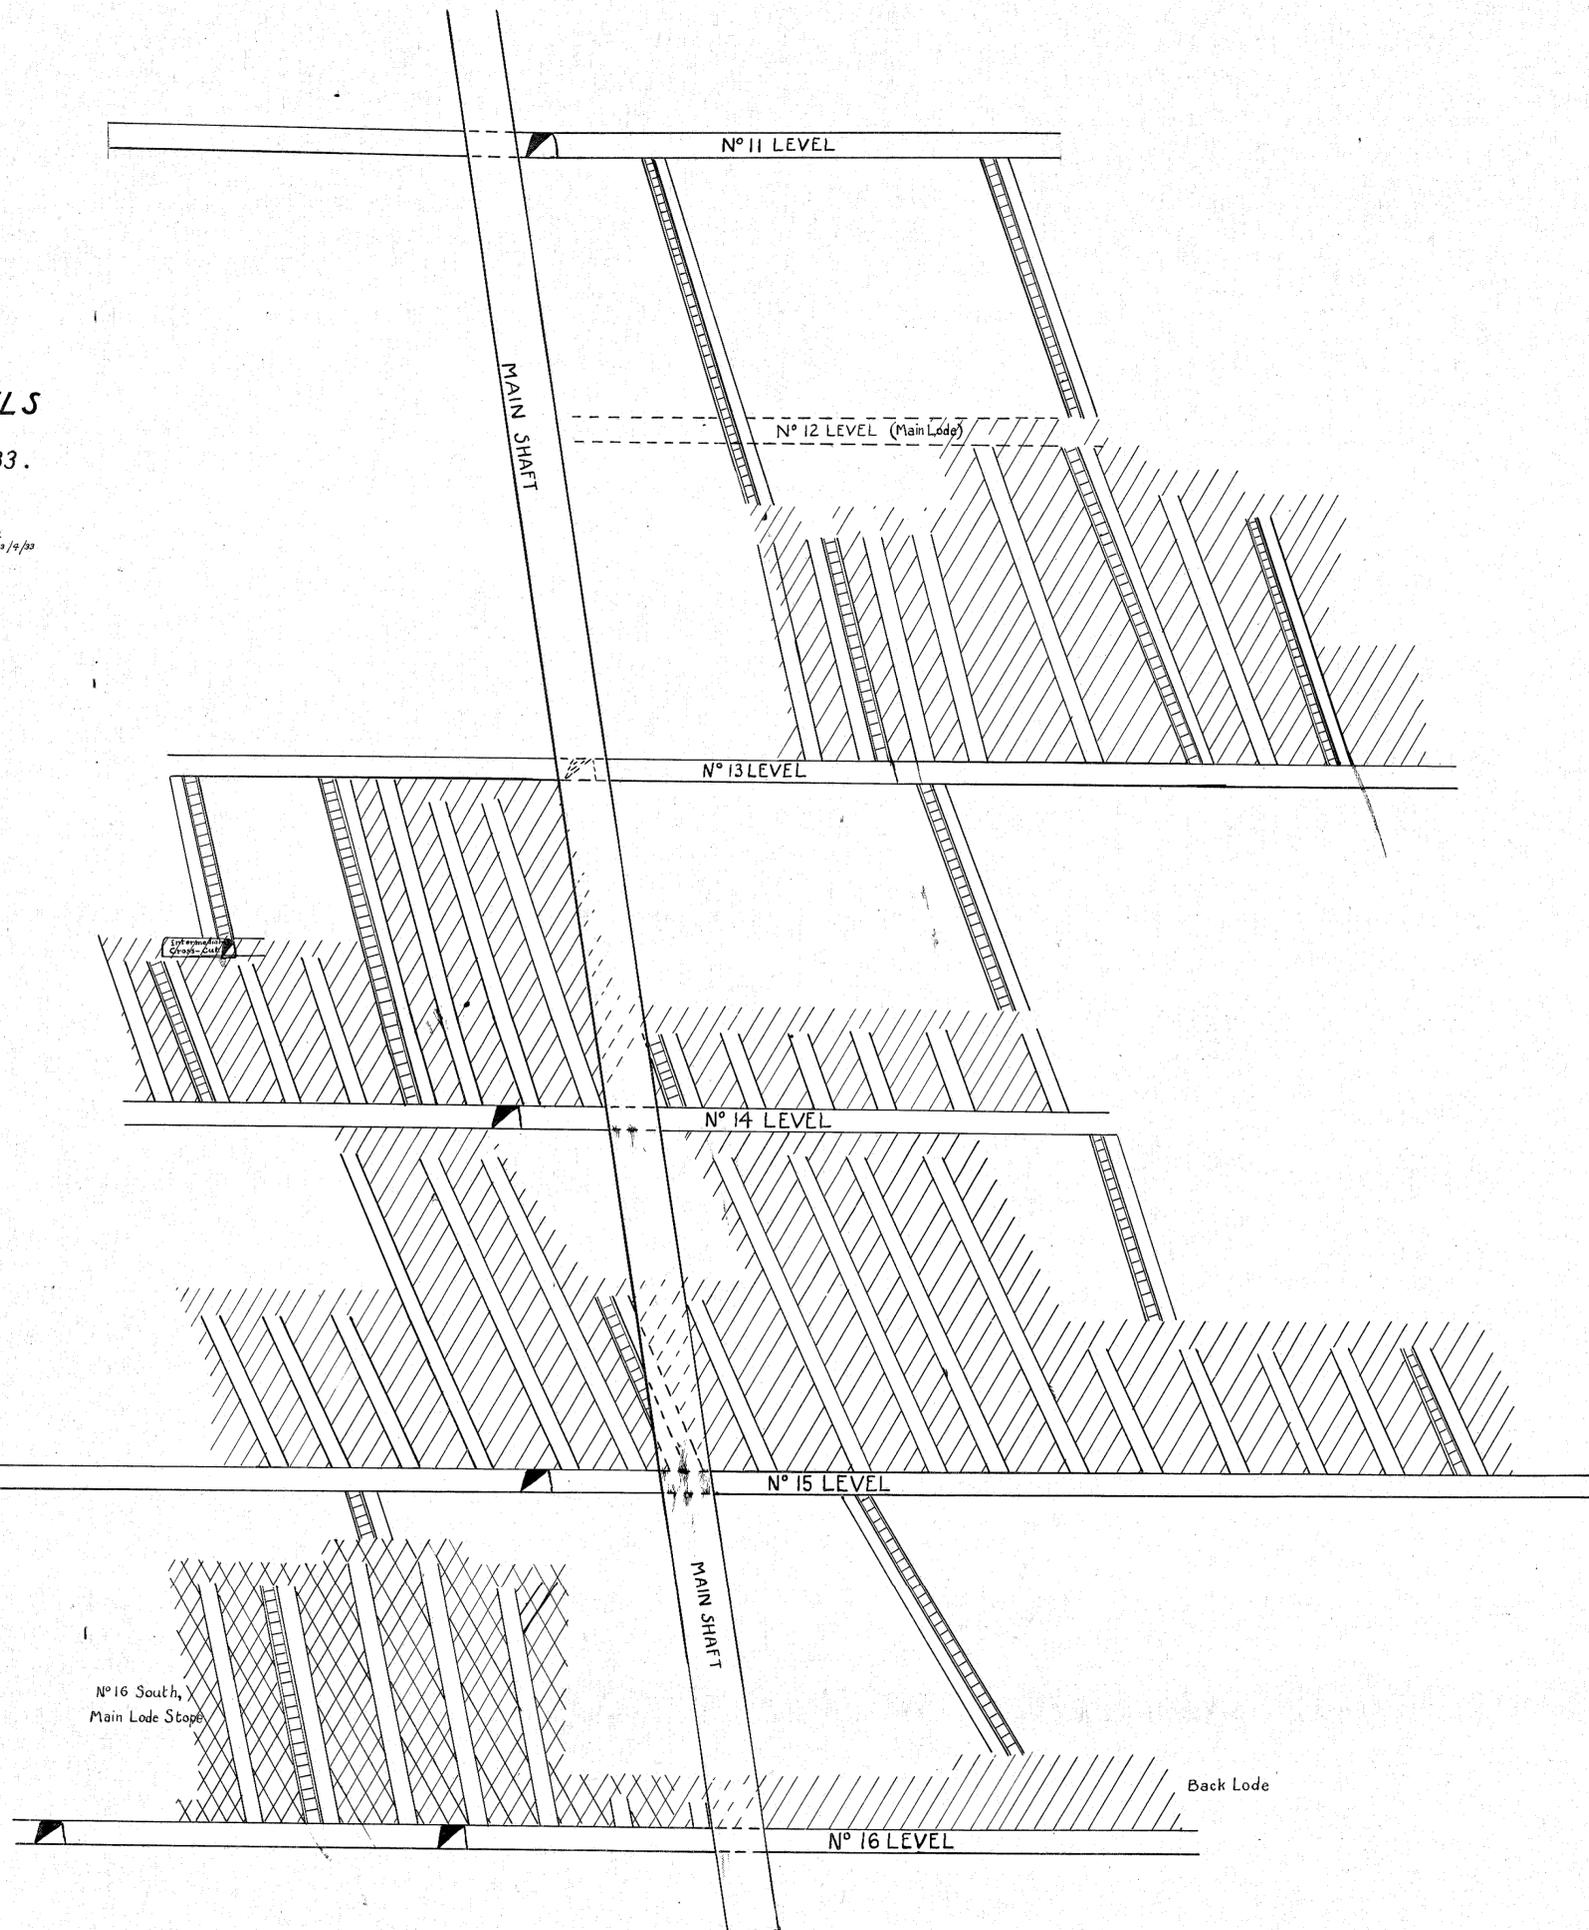

40-30

40-30