



RC

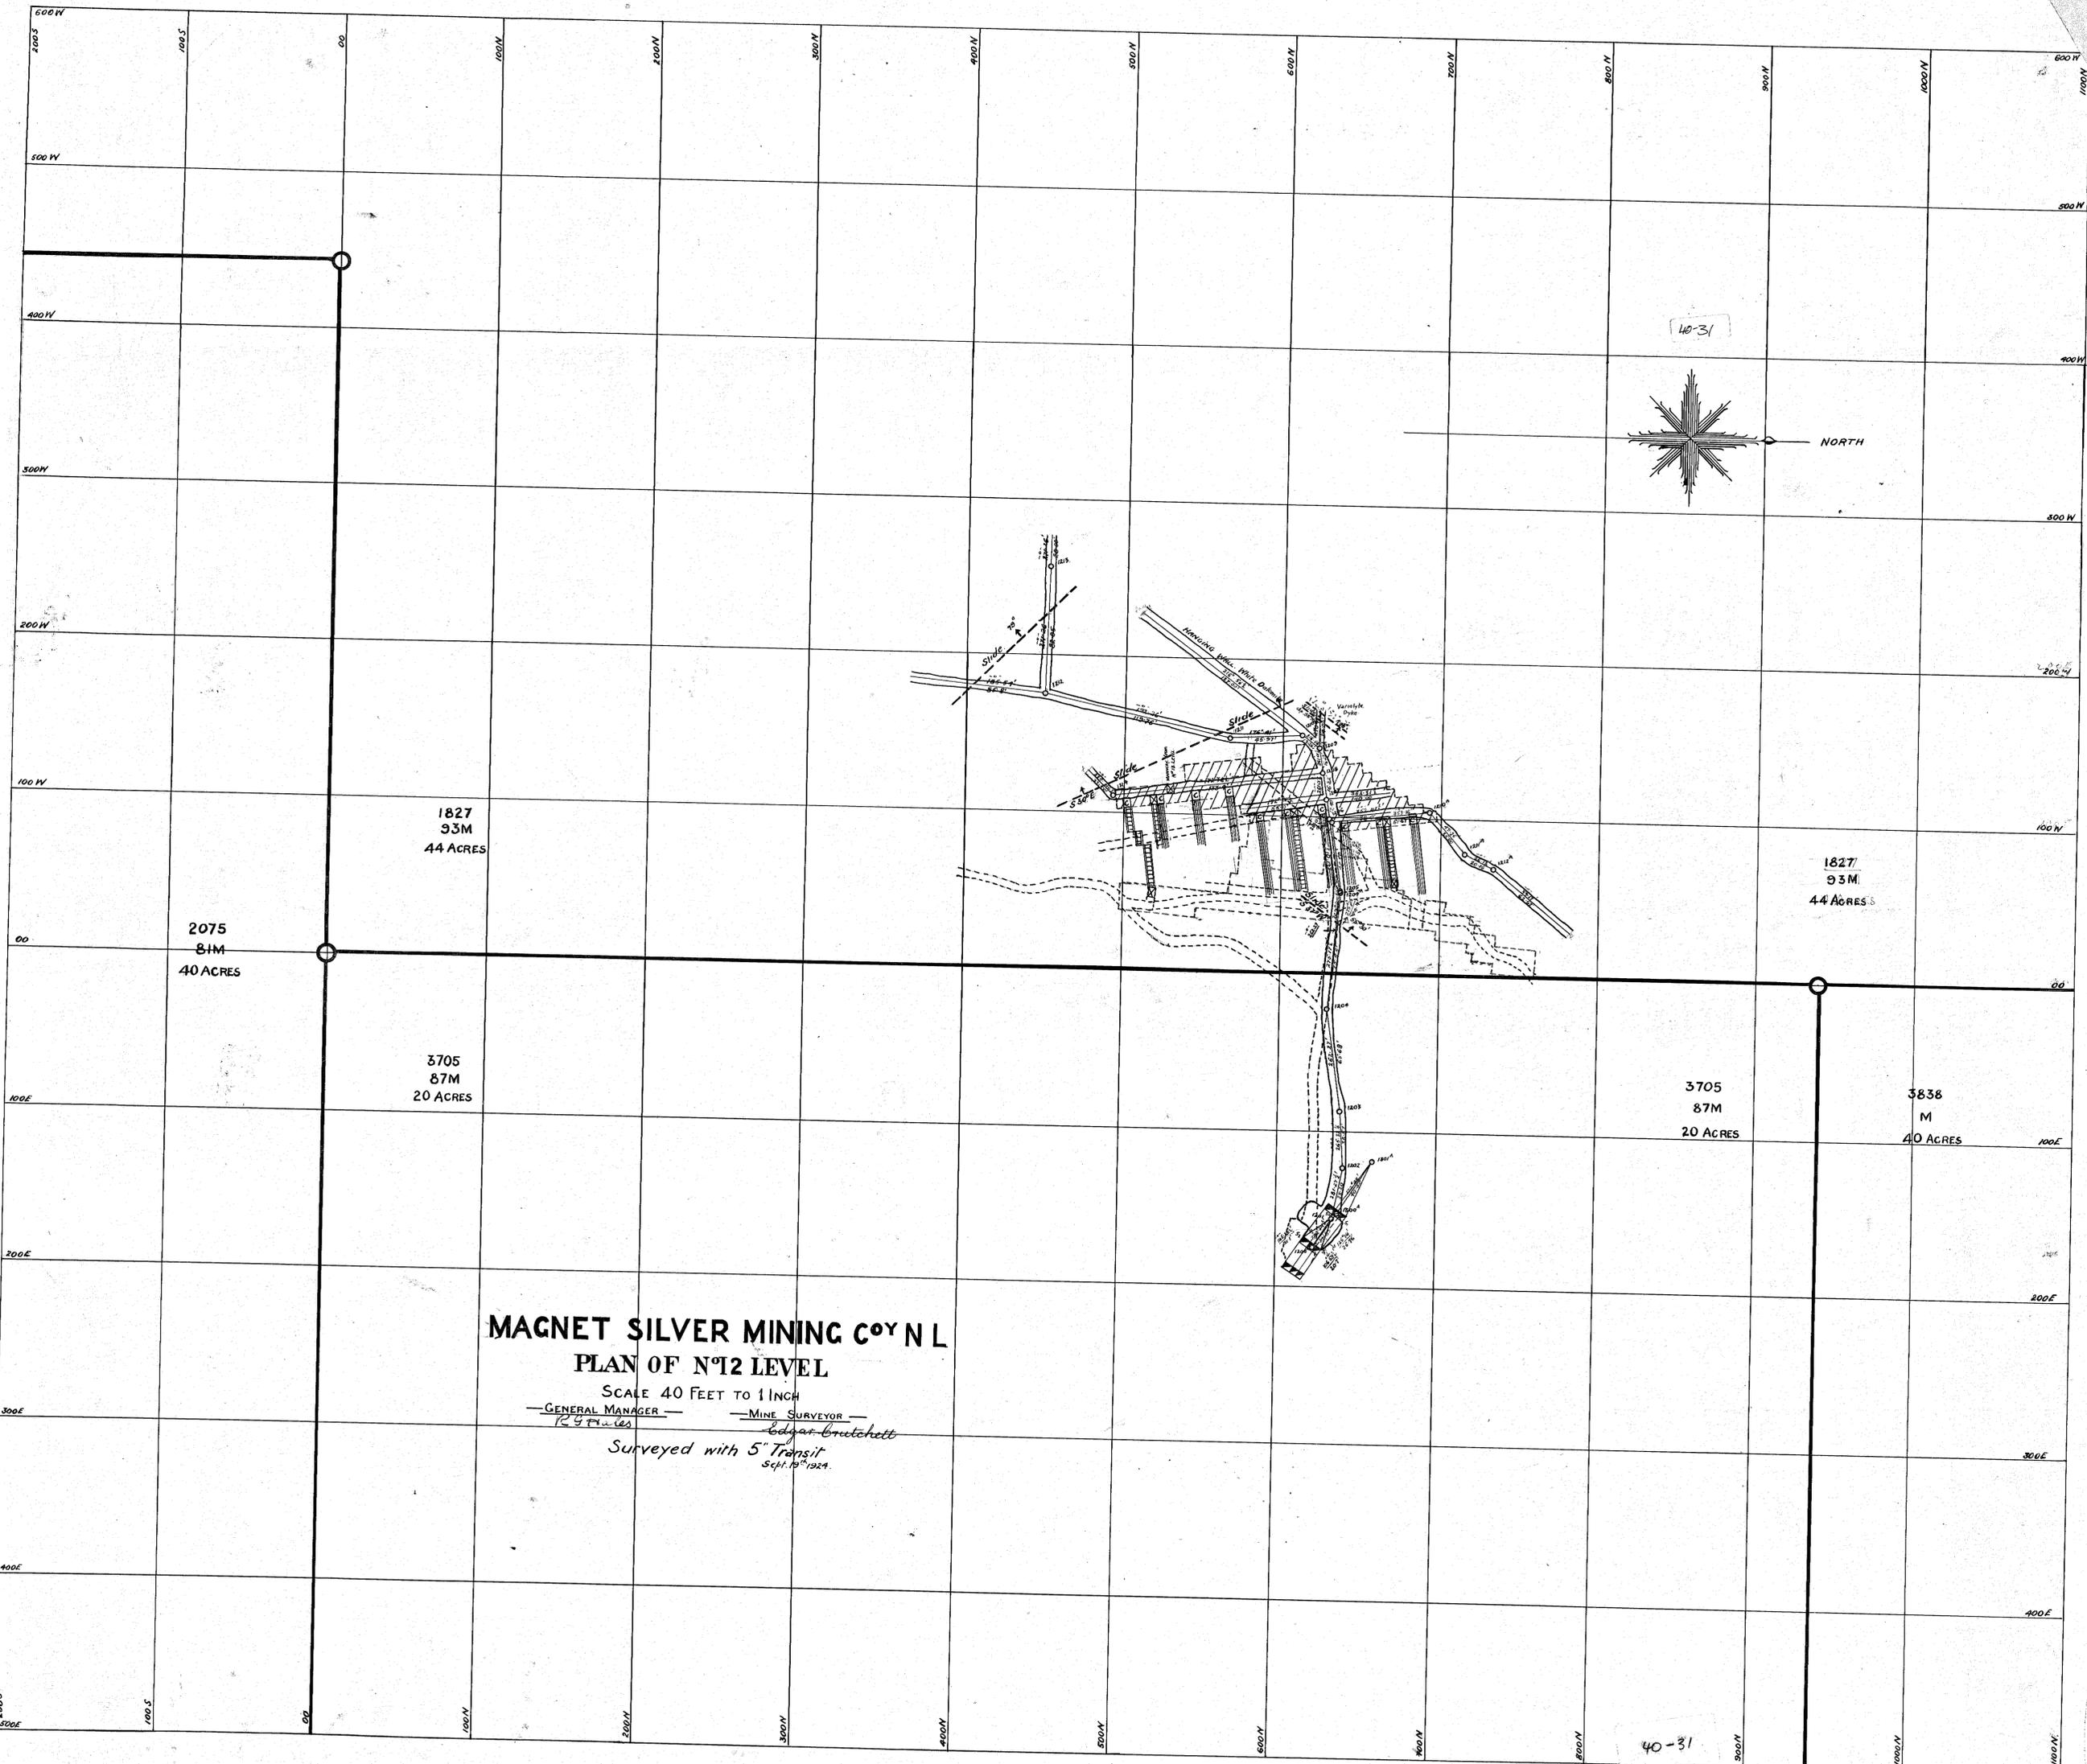

MAGNET SILVER MINING COY N L
PLAN OF N°12 LEVEL

SCALE 40 FEET TO 1 INCH
 — GENERAL MANAGER — — MINE SURVEYOR —
 (R. S. [unclear]) Edgar Bretchett
 Surveyed with 5" Transit
 Sept. 19th 1924

40-31

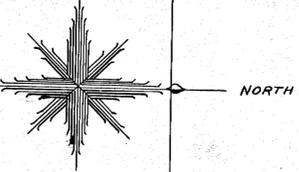

500'

40-31