


RC

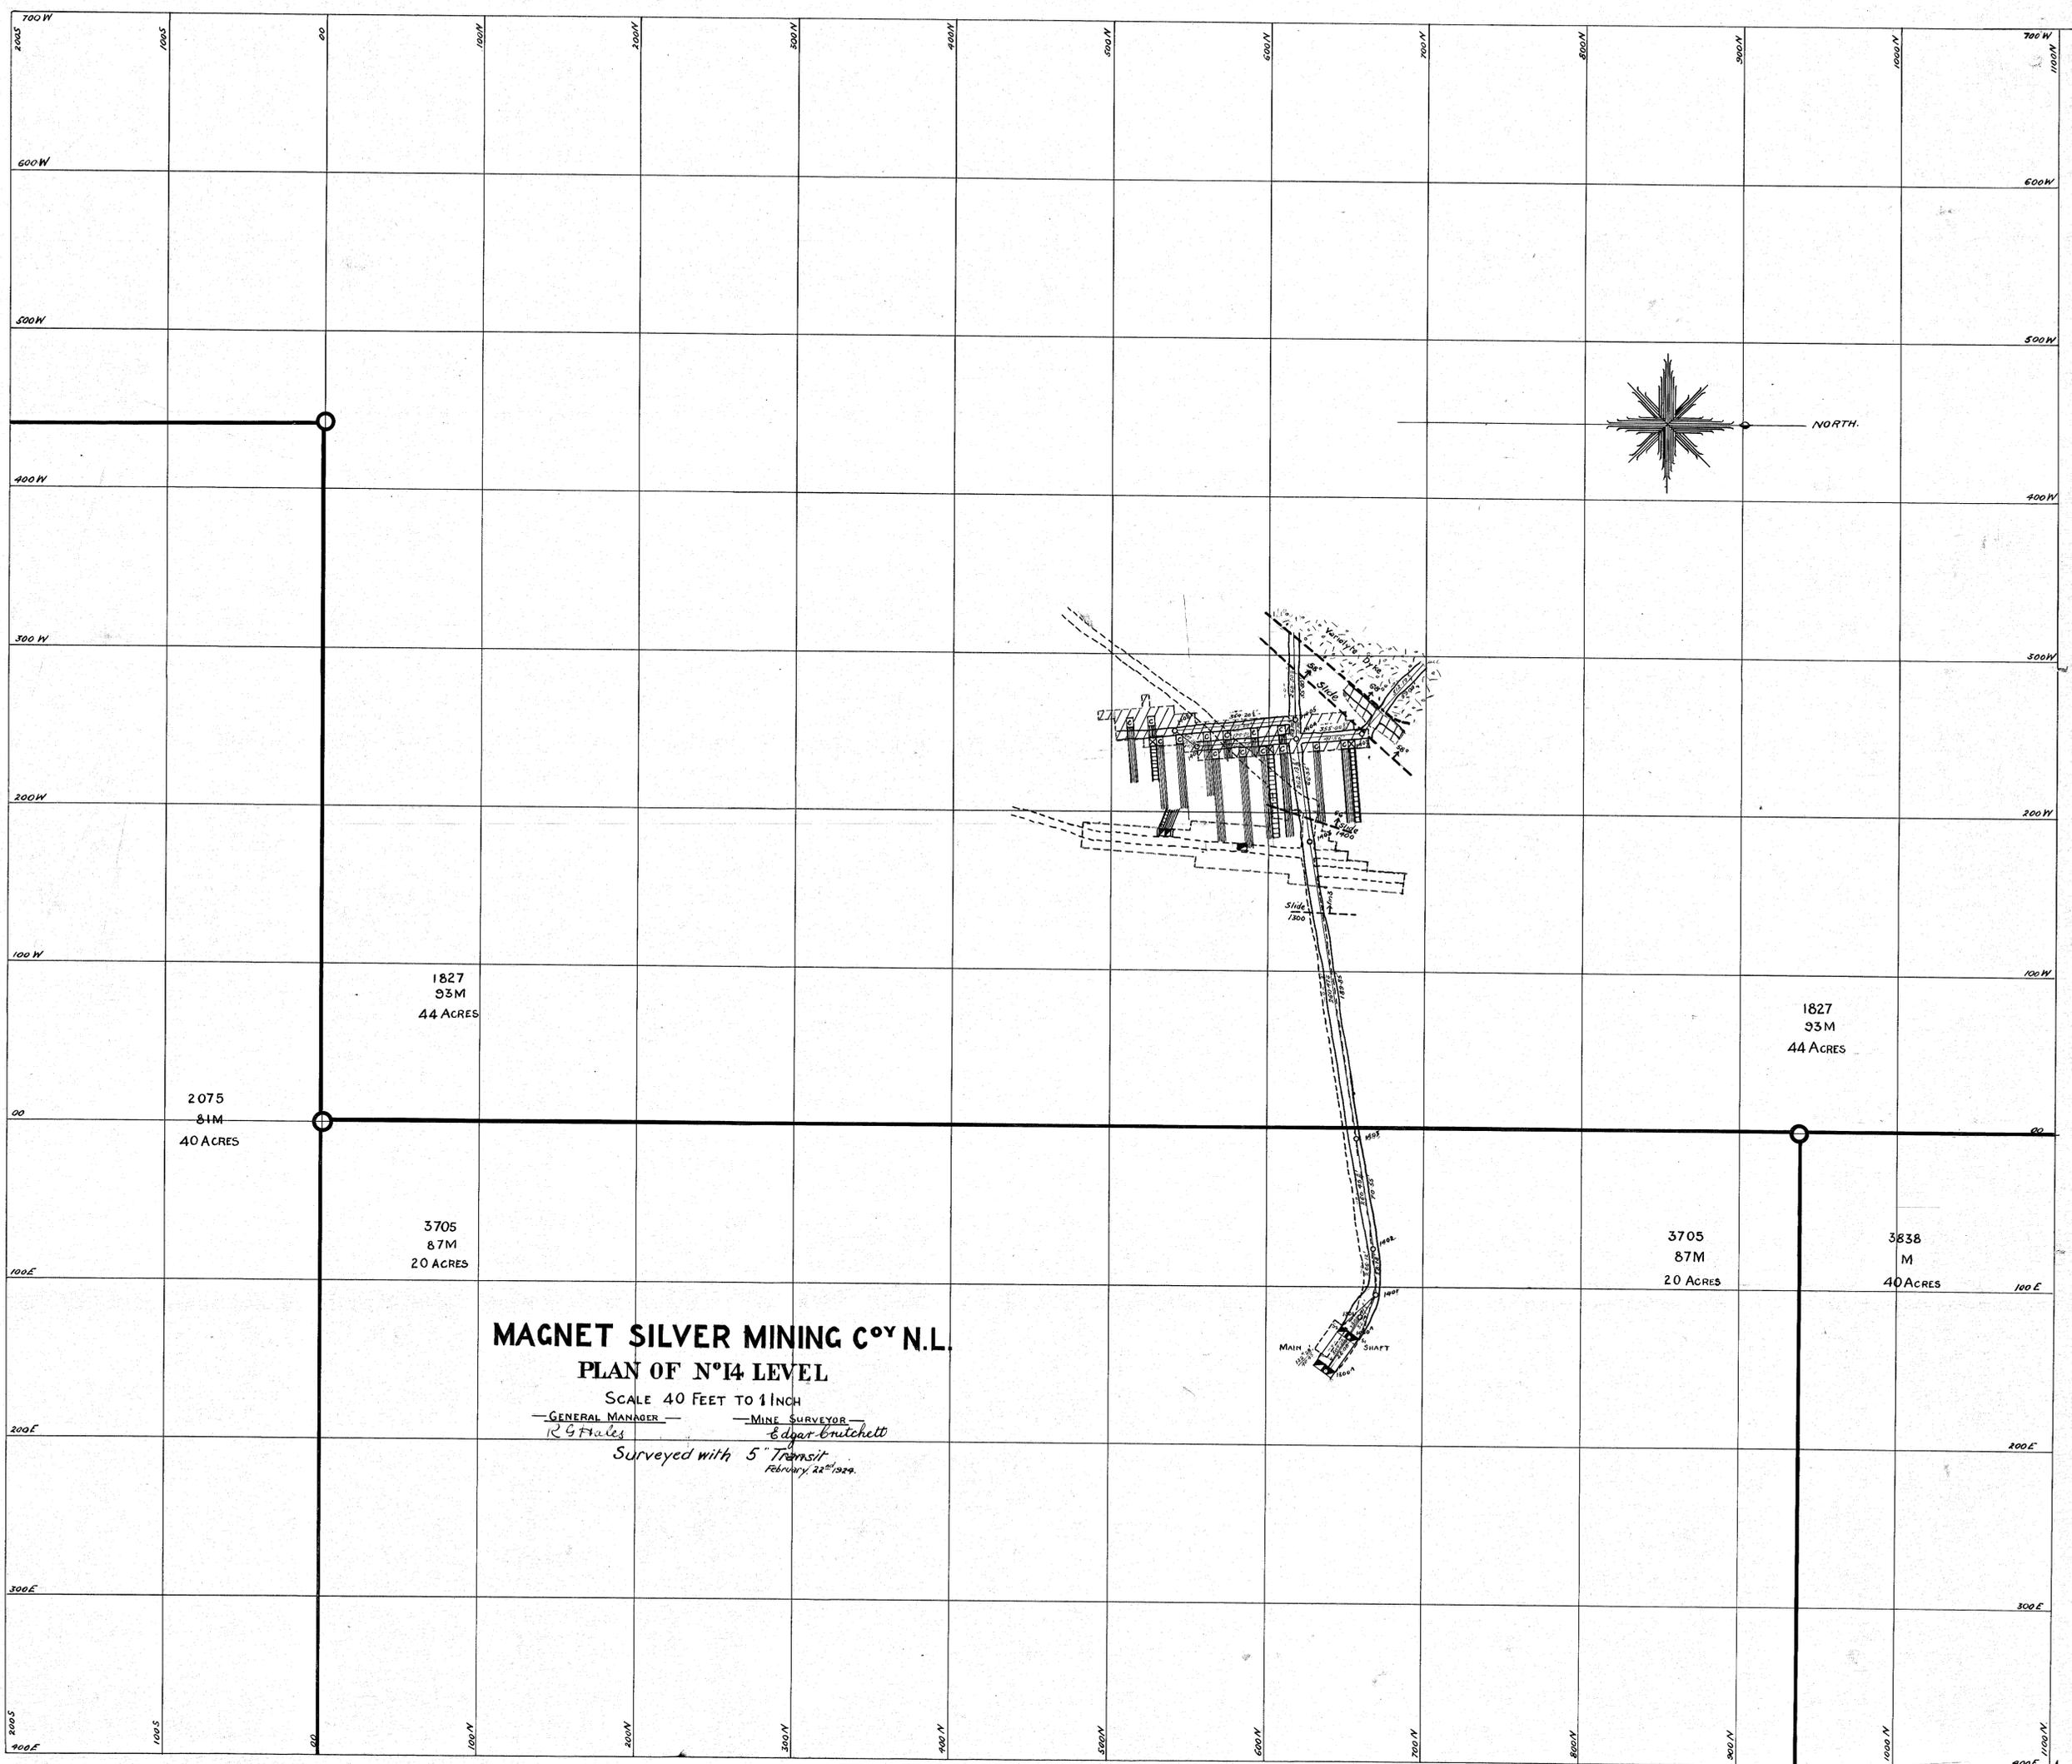

MAGNET SILVER MINING COY N.L.
PLAN OF N°14 LEVEL

SCALE 40 FEET TO 1 INCH
 — GENERAL MANAGER — — MINE SURVEYOR —
R G Hales *Edgar Hutchett*
 Surveyed with 5" Transit
 February, 22nd 1909.