

MAGNET SILVER MINING C^oY N. L.

LONGITUDINAL SECTION OF WORKINGS

— Scale 40 Feet to 1 Inch —

NOTE: Section taken along North and South Section Lines


Hanging Wall Stops shown thus

Footwall Stops shown thus

East Lode Stops shown thus



Rules

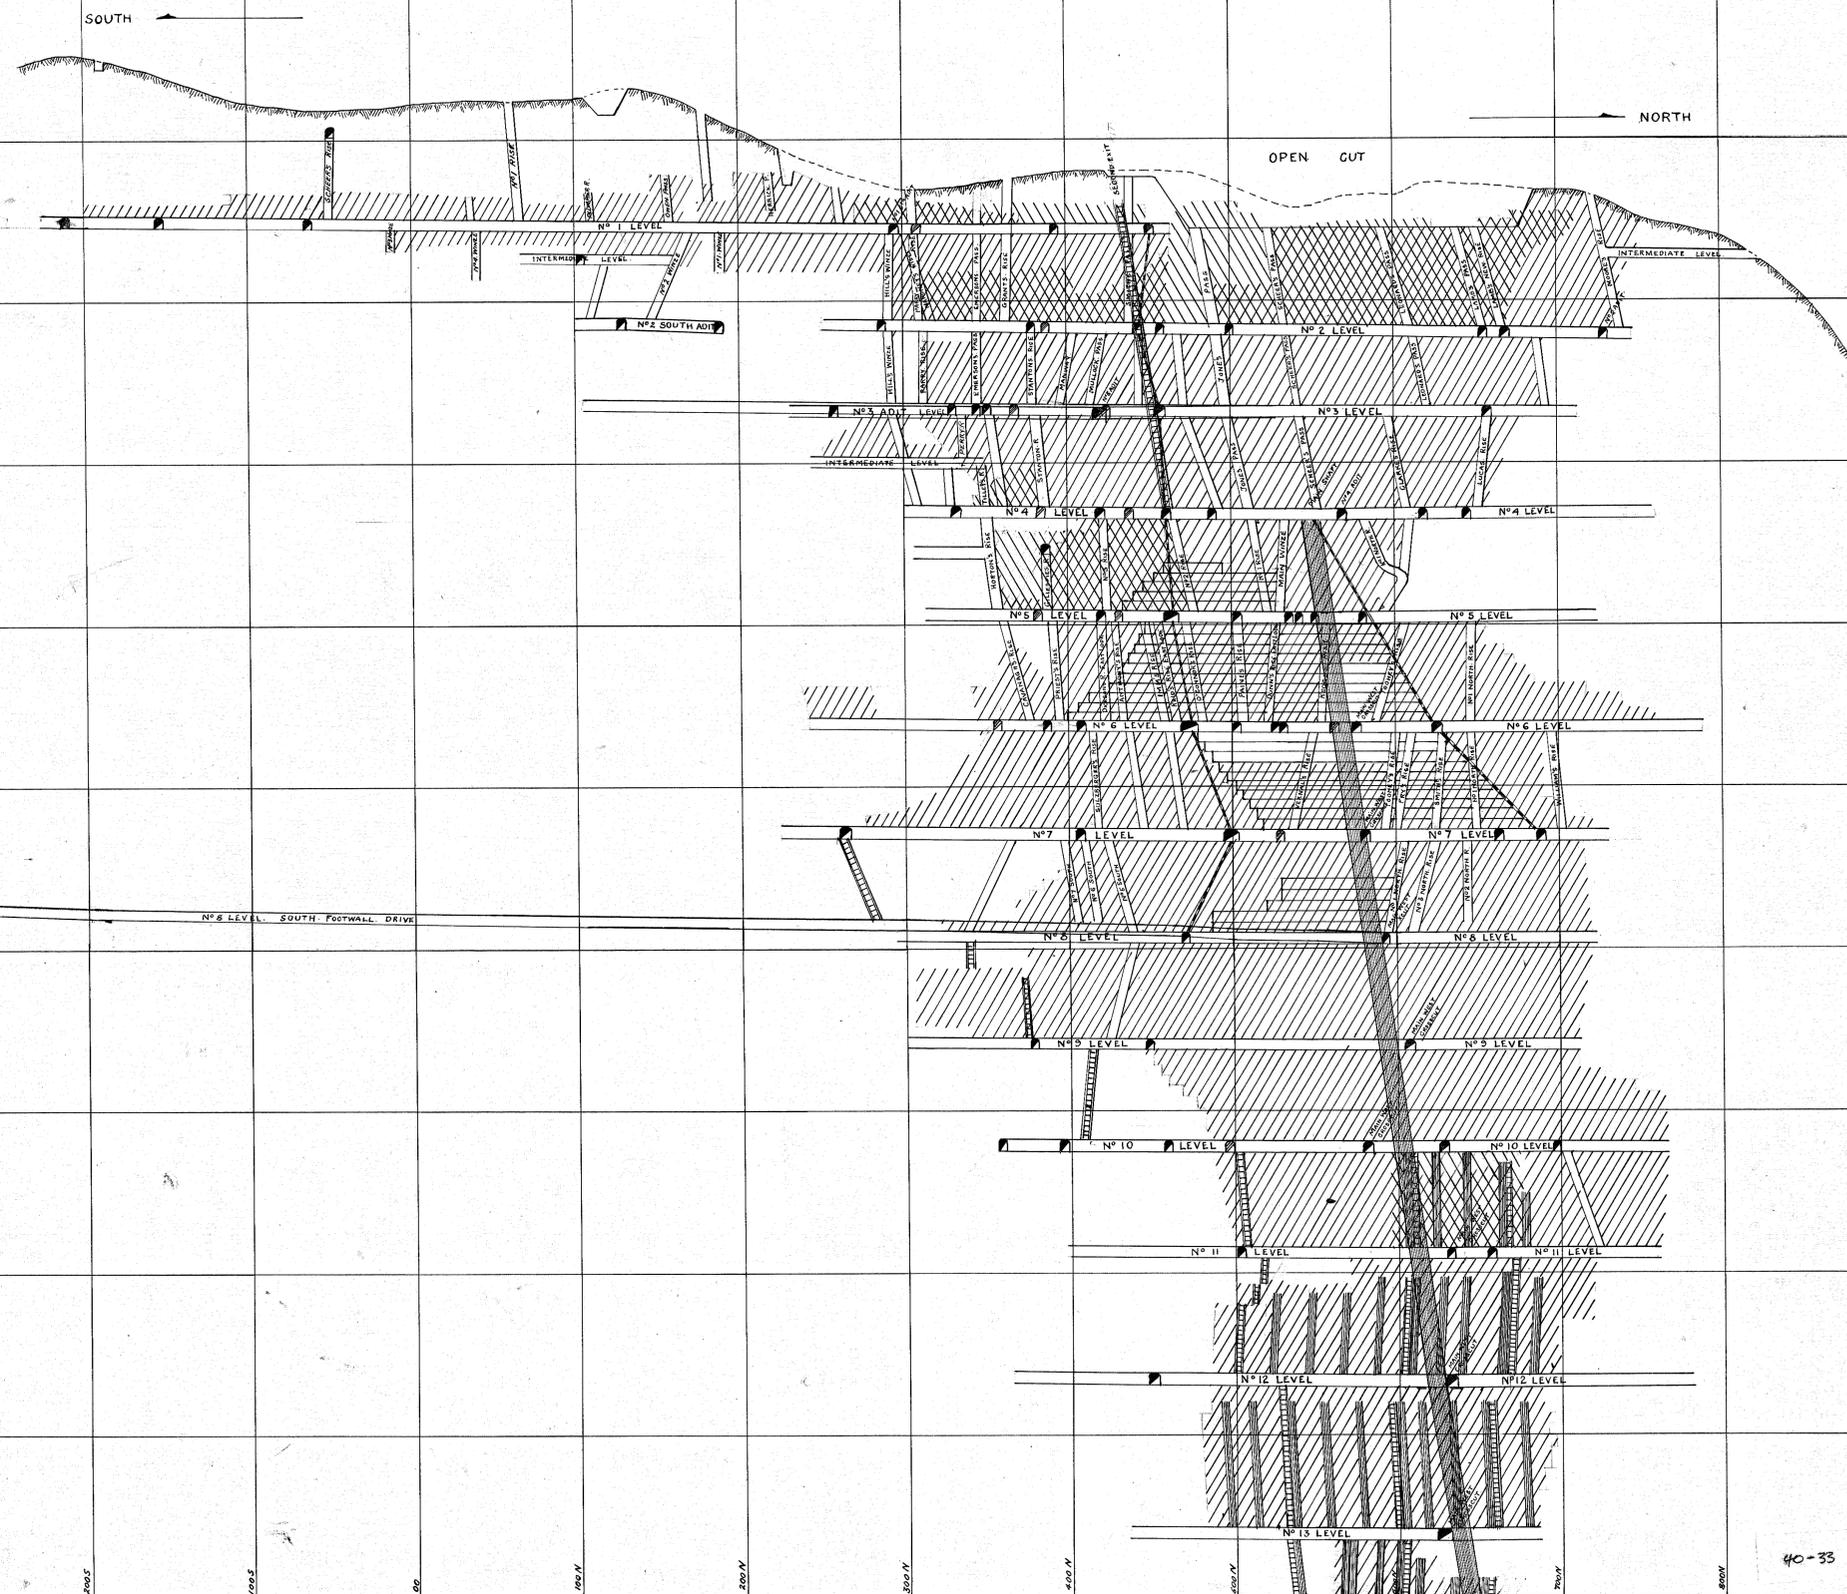

40-33