


RC

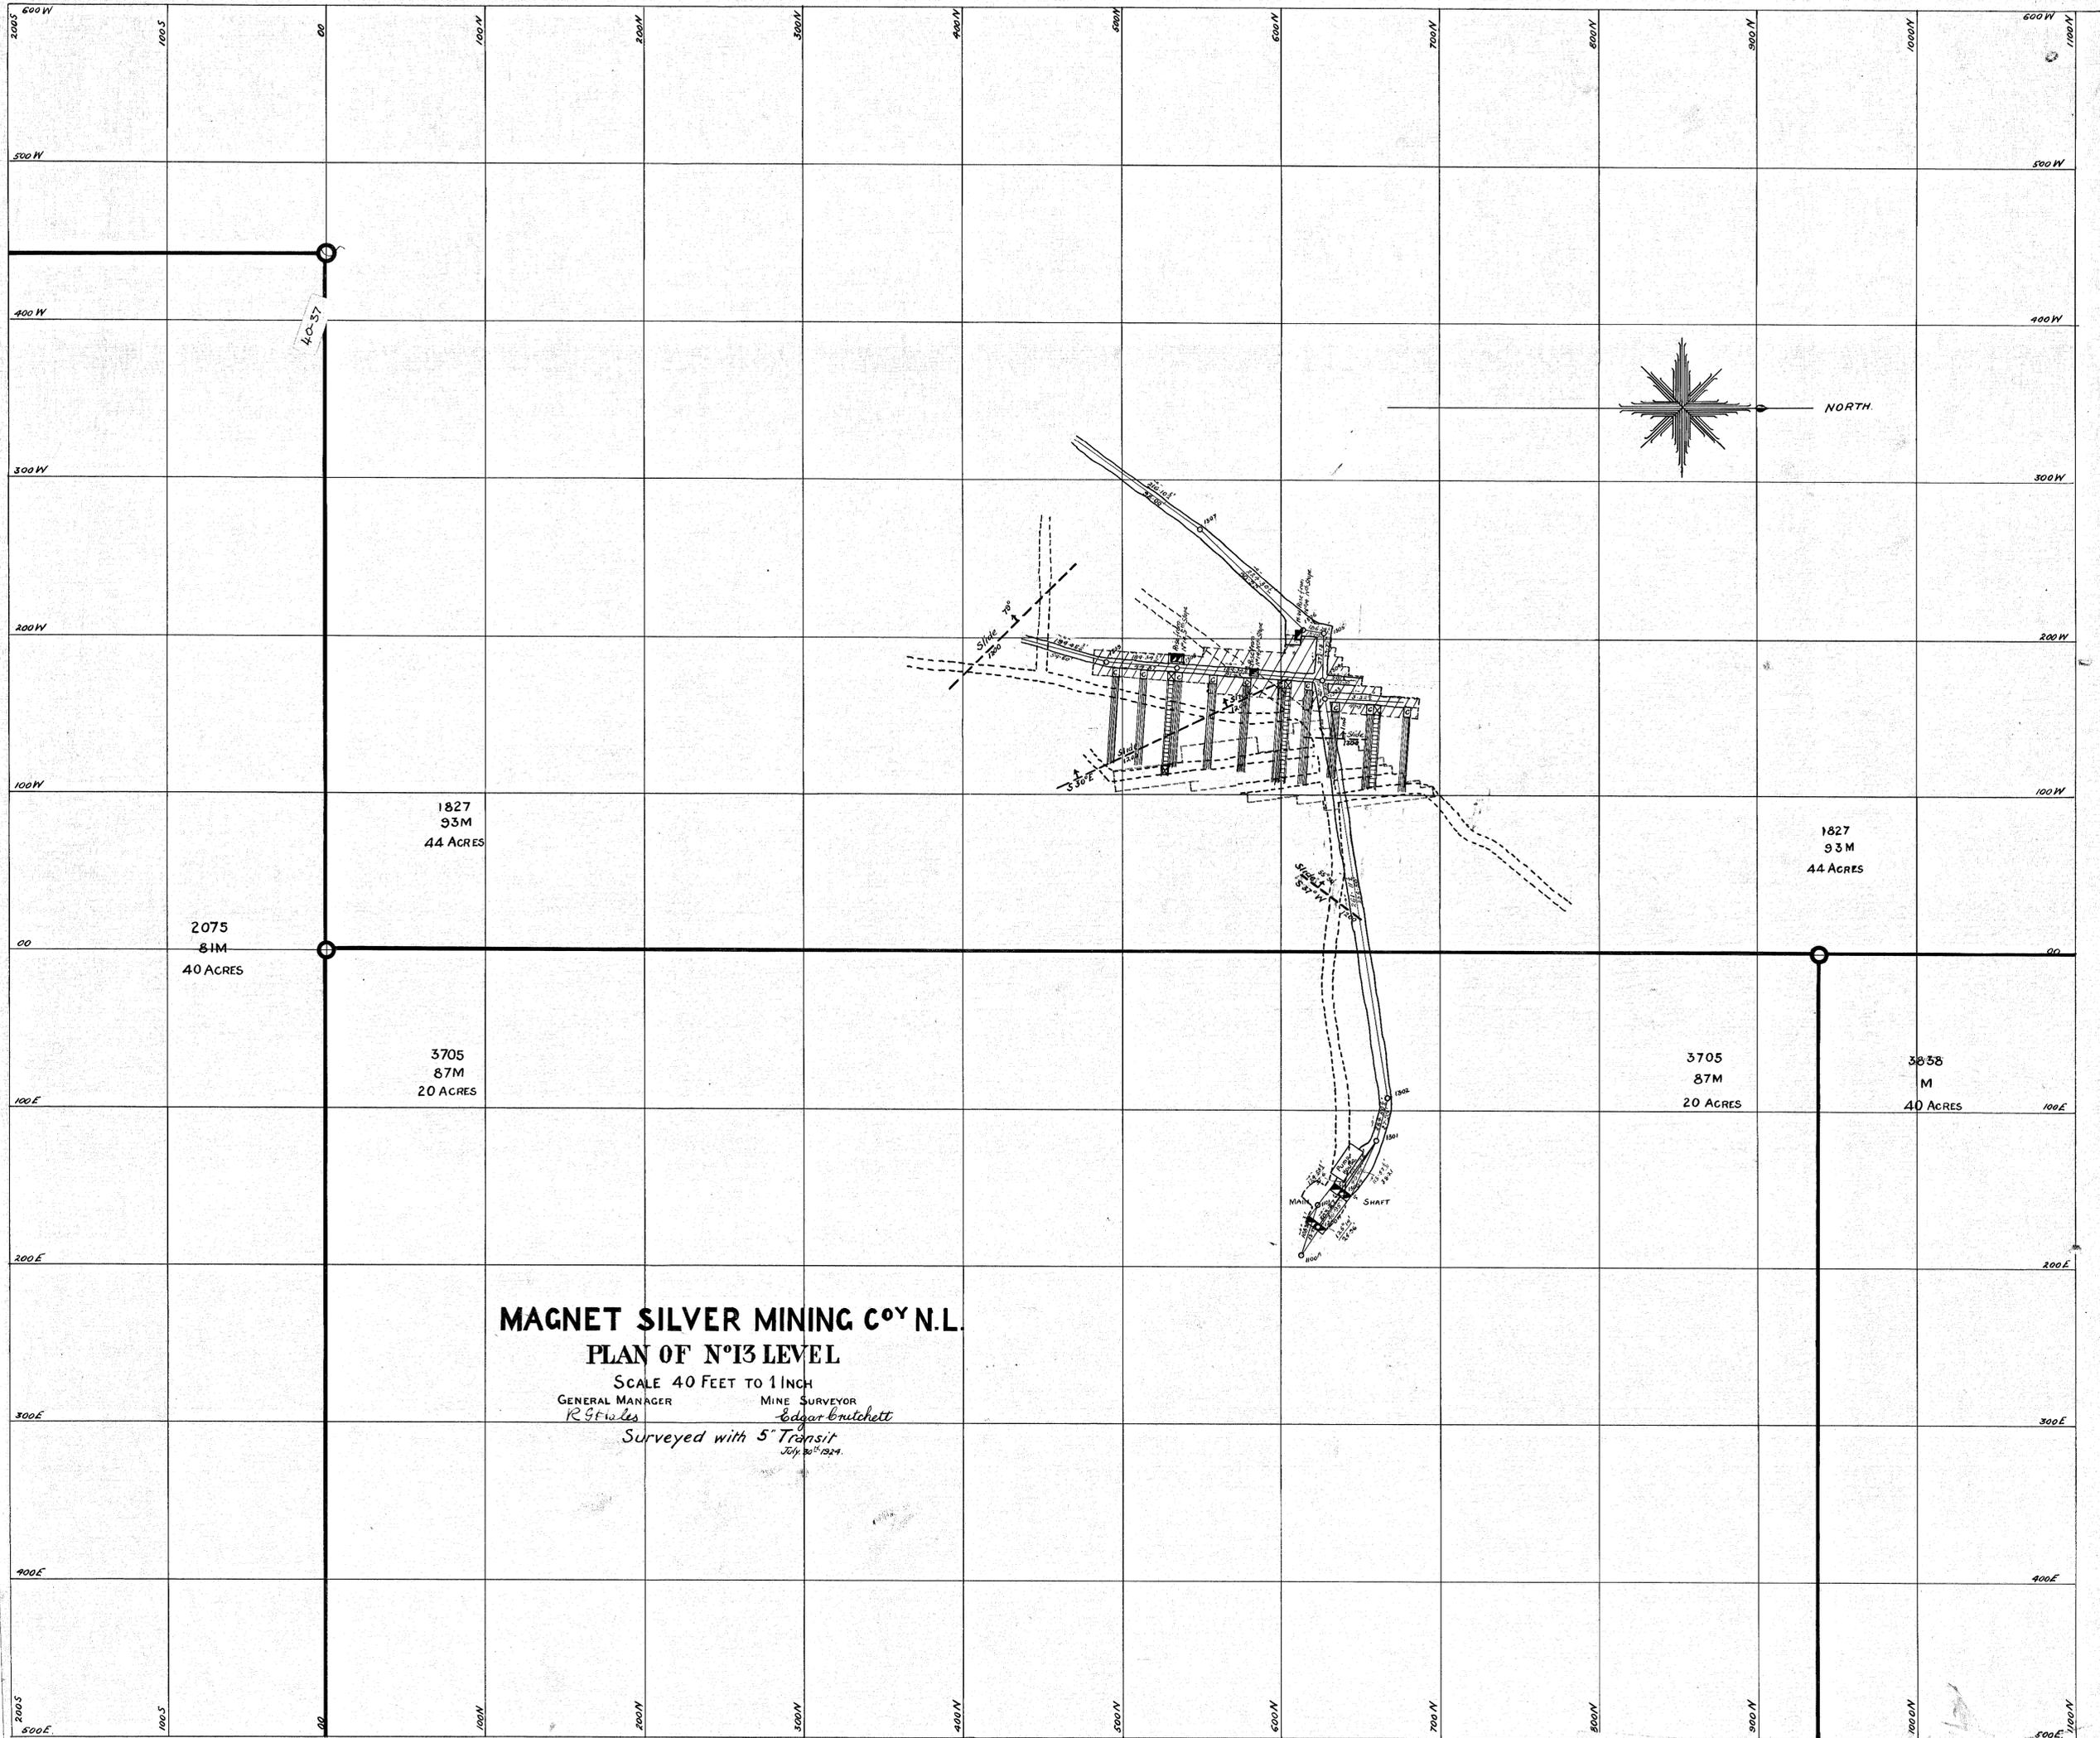

**MAGNET SILVER MINING COY N.L.**  
**PLAN OF N°13 LEVEL**  
 SCALE 40 FEET TO 1 INCH  
 GENERAL MANAGER R.G. Wiles  
 MINE SURVEYOR Edgar Hutchett  
 Surveyed with 5" Transit  
 July 20th 1924