


RC

40-40

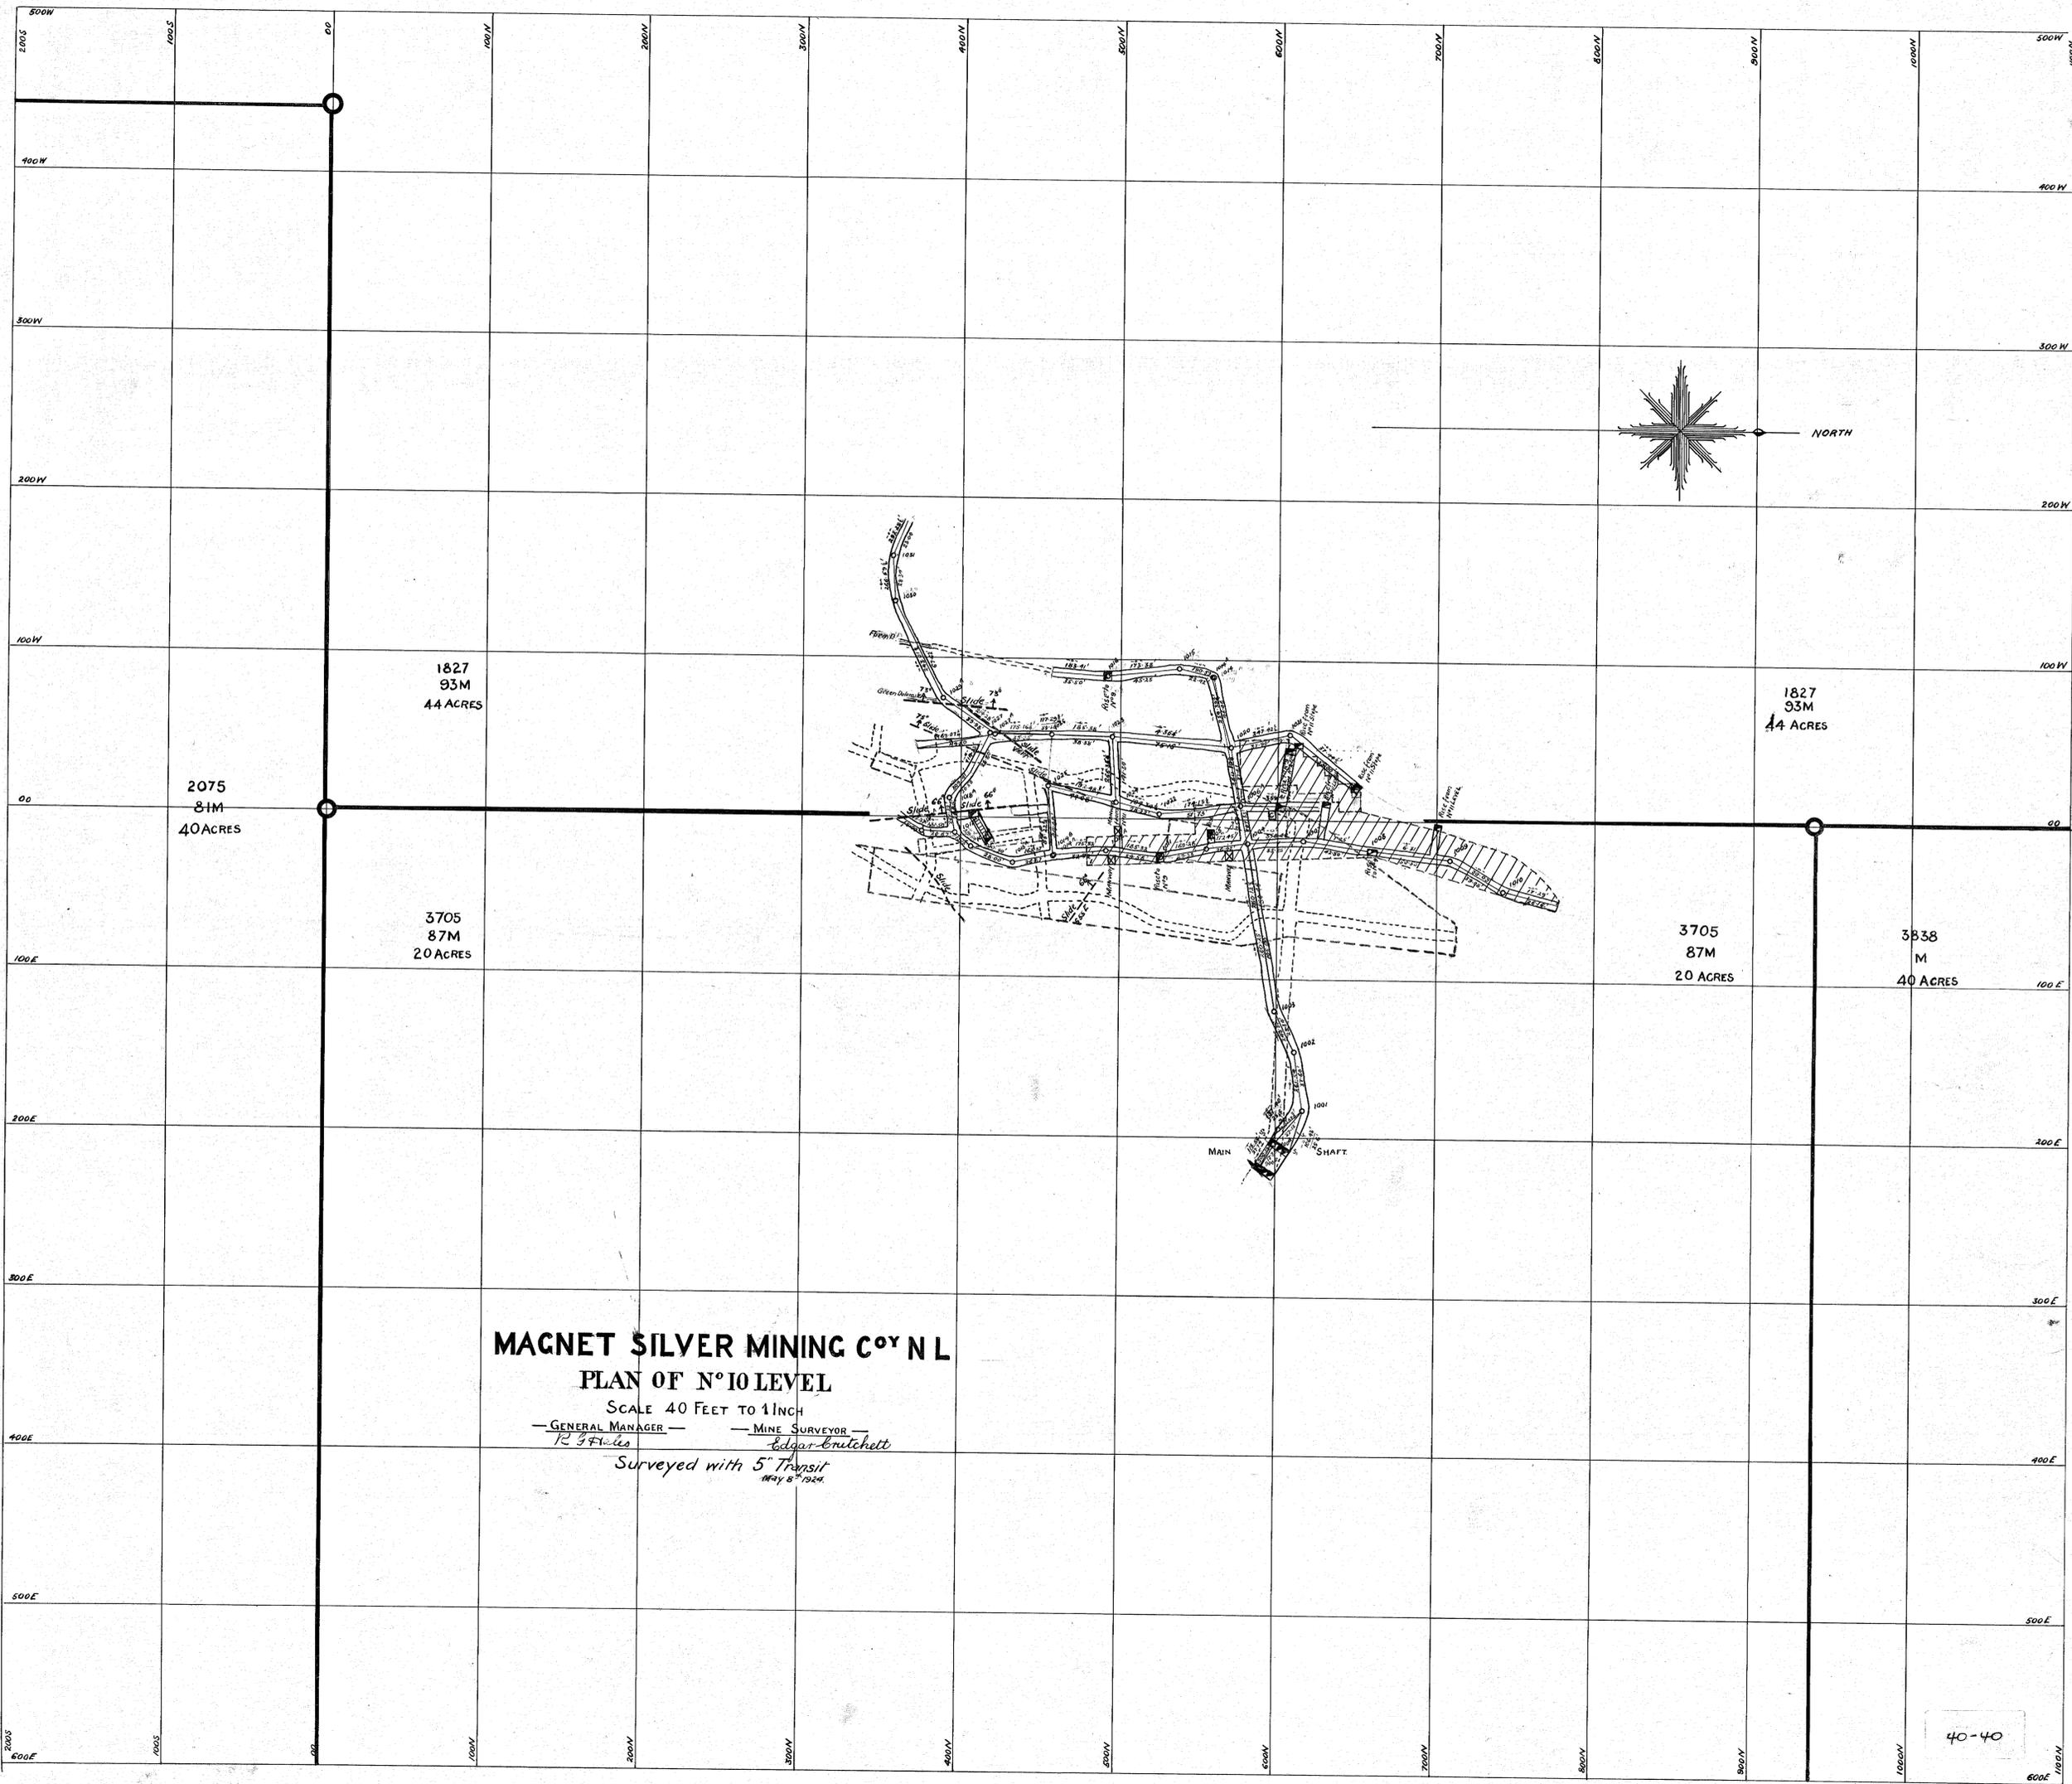

MAGNET SILVER MINING COY N L
PLAN OF N° 10 LEVEL
 SCALE 40 FEET TO 1 INCH
 — GENERAL MANAGER — — MINE SURVEYOR —
R. S. Files *Edgar Brutchett*
 Surveyed with 5" Transit
 May 8-1924

40-40