


RC

40-41

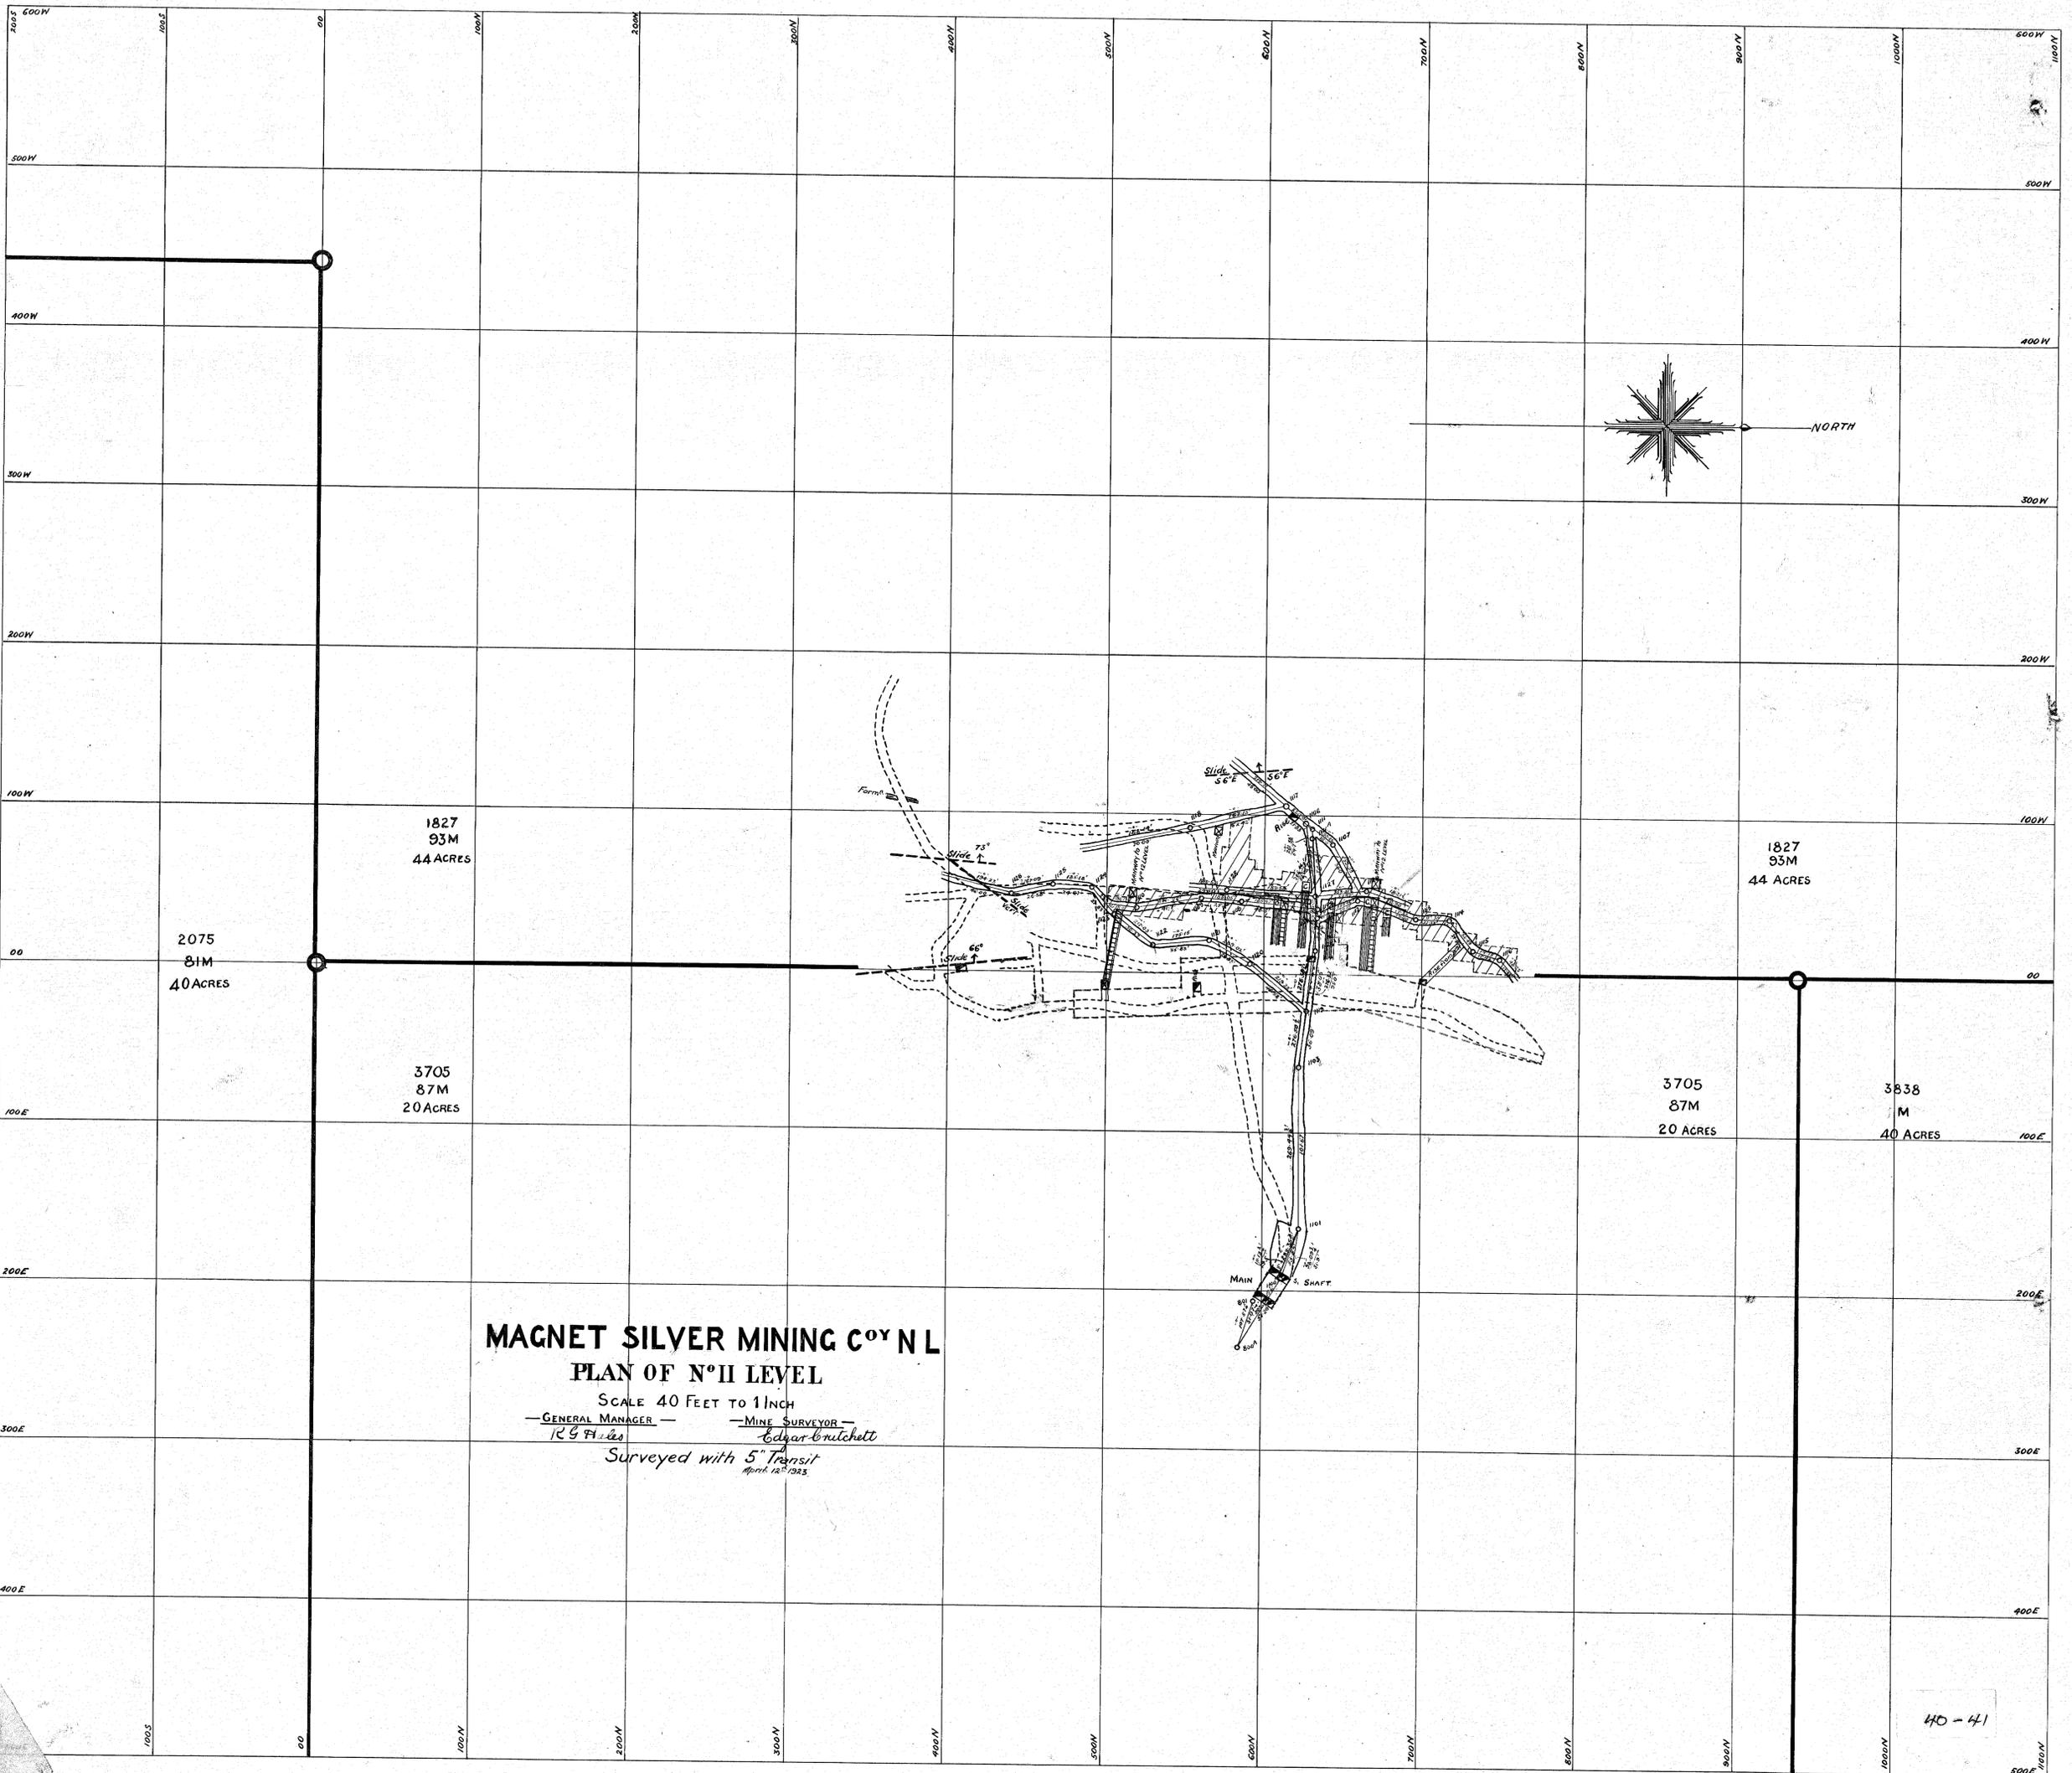

MAGNET SILVER MINING COY NL
PLAN OF N°II LEVEL

SCALE 40 FEET TO 1 INCH
 — GENERAL MANAGER — — MINE SURVEYOR —
R. G. Flaherty *Edgar Hutchett*
 Surveyed with 5" Transit
 April 12th 1923.

40-41