


RC

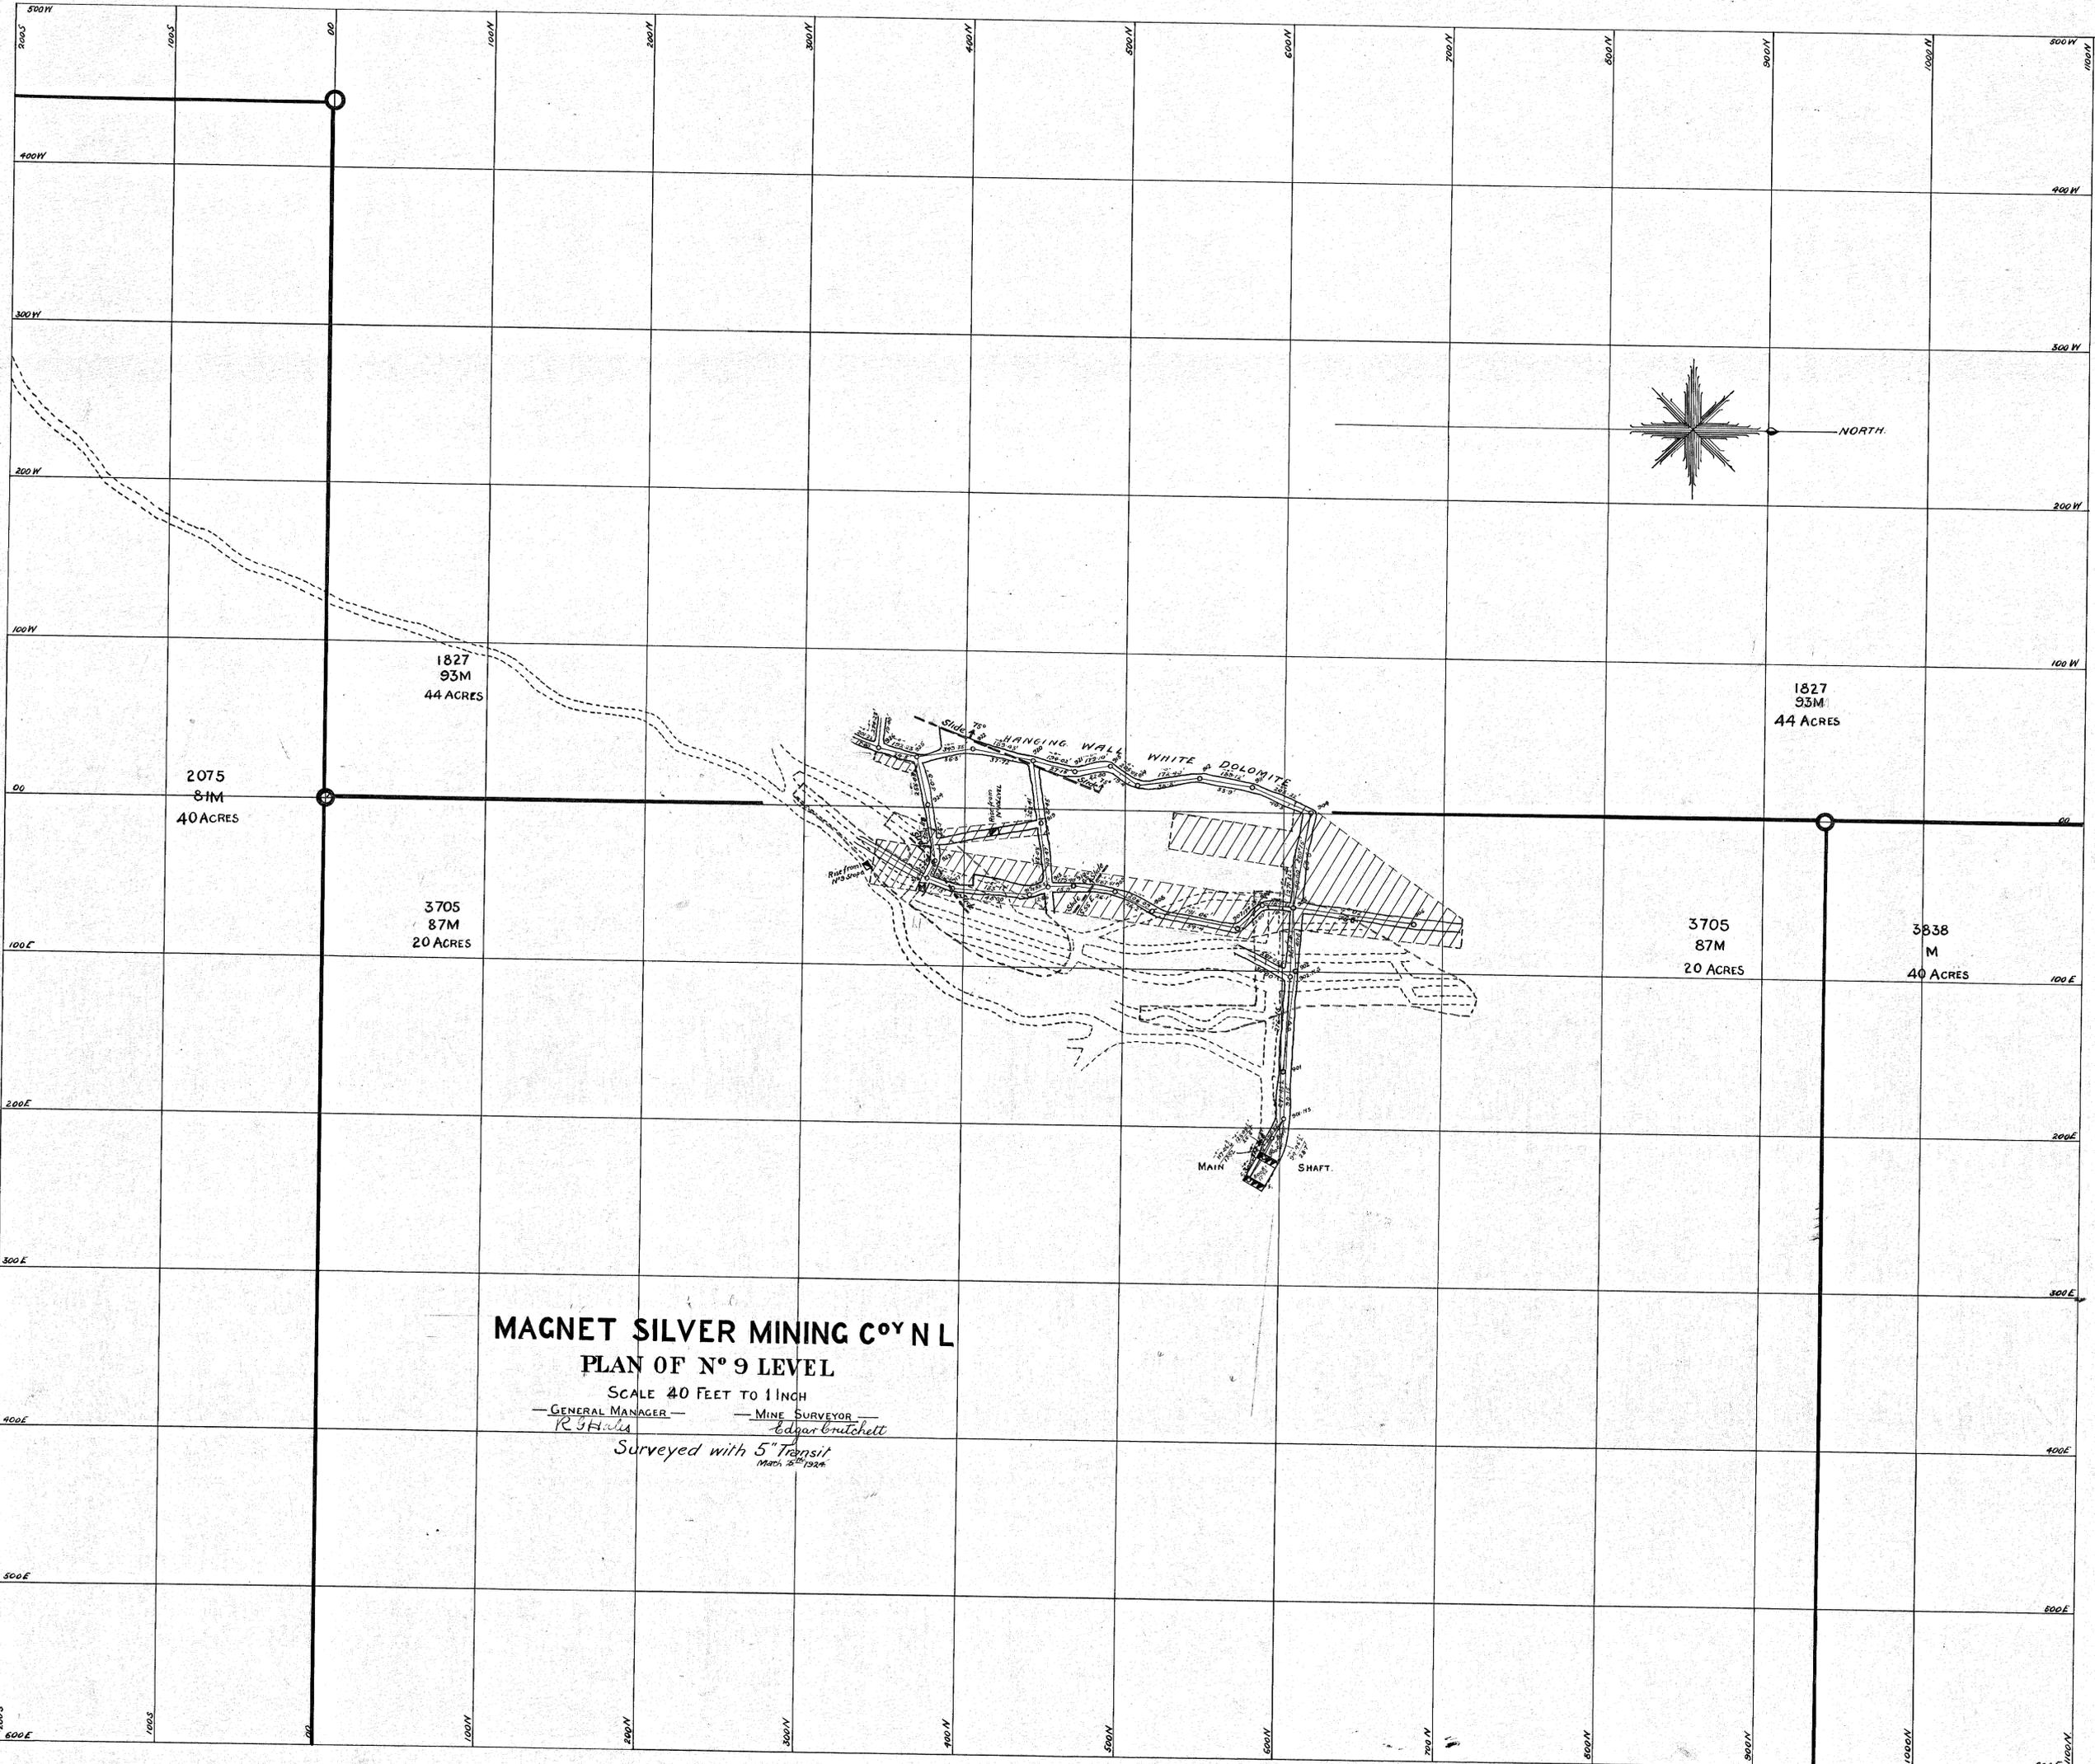

**MAGNET SILVER MINING COY N L**  
**PLAN OF N° 9 LEVEL**  
 SCALE 40 FEET TO 1 INCH  
 — GENERAL MANAGER — R. G. H. ...  
 — MINE SURVEYOR — Edgar C. Mitchell  
 Surveyed with 5" Transit  
 March 25th 1926