



5 cm

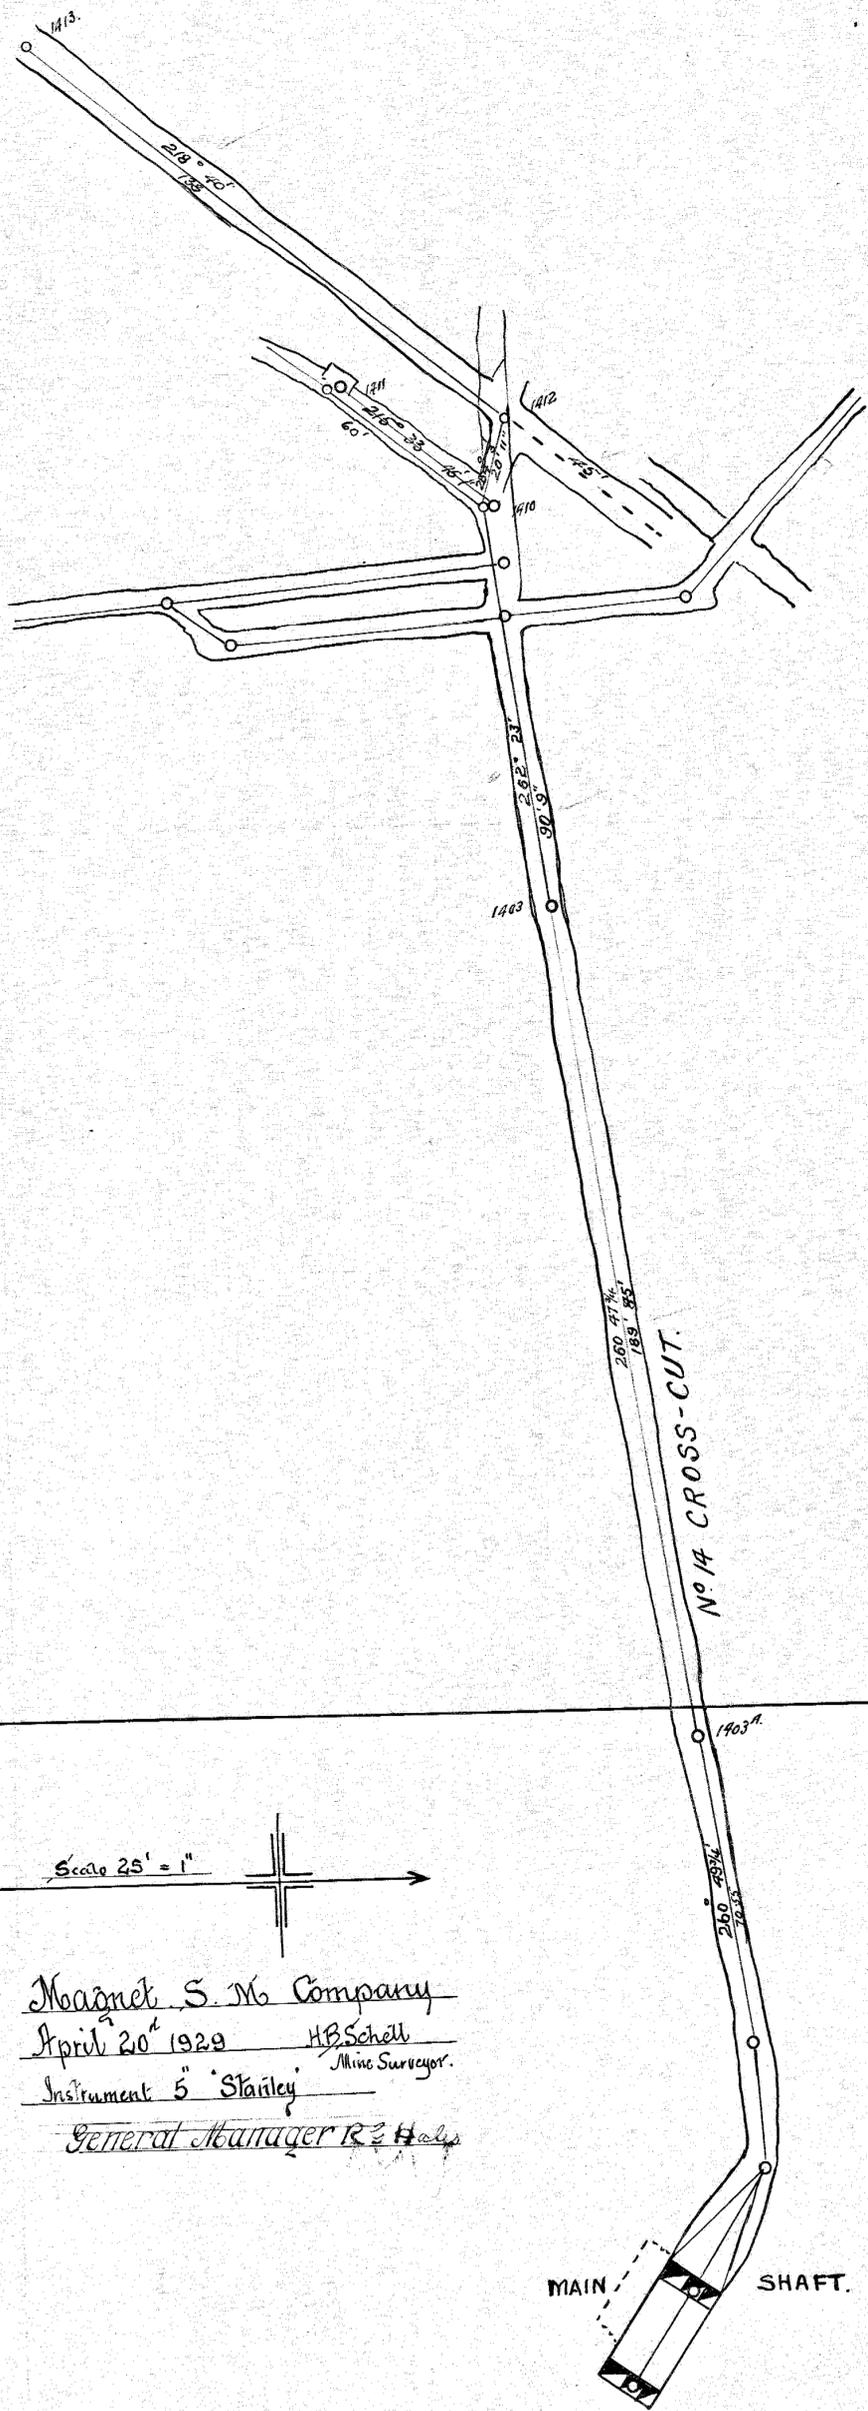

400 W
300 W
200 W
100 W
00
100 E
200 E
300 N
400 N
500 N
600 N
700 N
800 N

Scale 25' = 1"

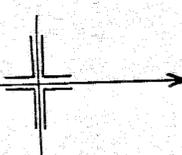

Magnet S. M. Company
 April 20th 1929 H.B. Schell
 Mine Surveyor.
 Instrument 5" Stanley
 General Manager R. E. Halp

MAIN SHAFT.