


# ILLAMATHA COAL MINE


## SPREYTON

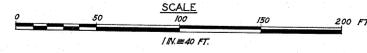

SURVEY BY THEODOLITE & MAG. COMPASS.

*W. Seaford*  
INSPECTOR OF MINES  
11 . 11 . 1948

ADDITIONS APRIL 1949  
MARCH 1950  
JULY 1951  
SEPT. 1952  
OCT. 1954  
MAR. 1958  
DEC. 1958  
DEC 1960 (abandoned)

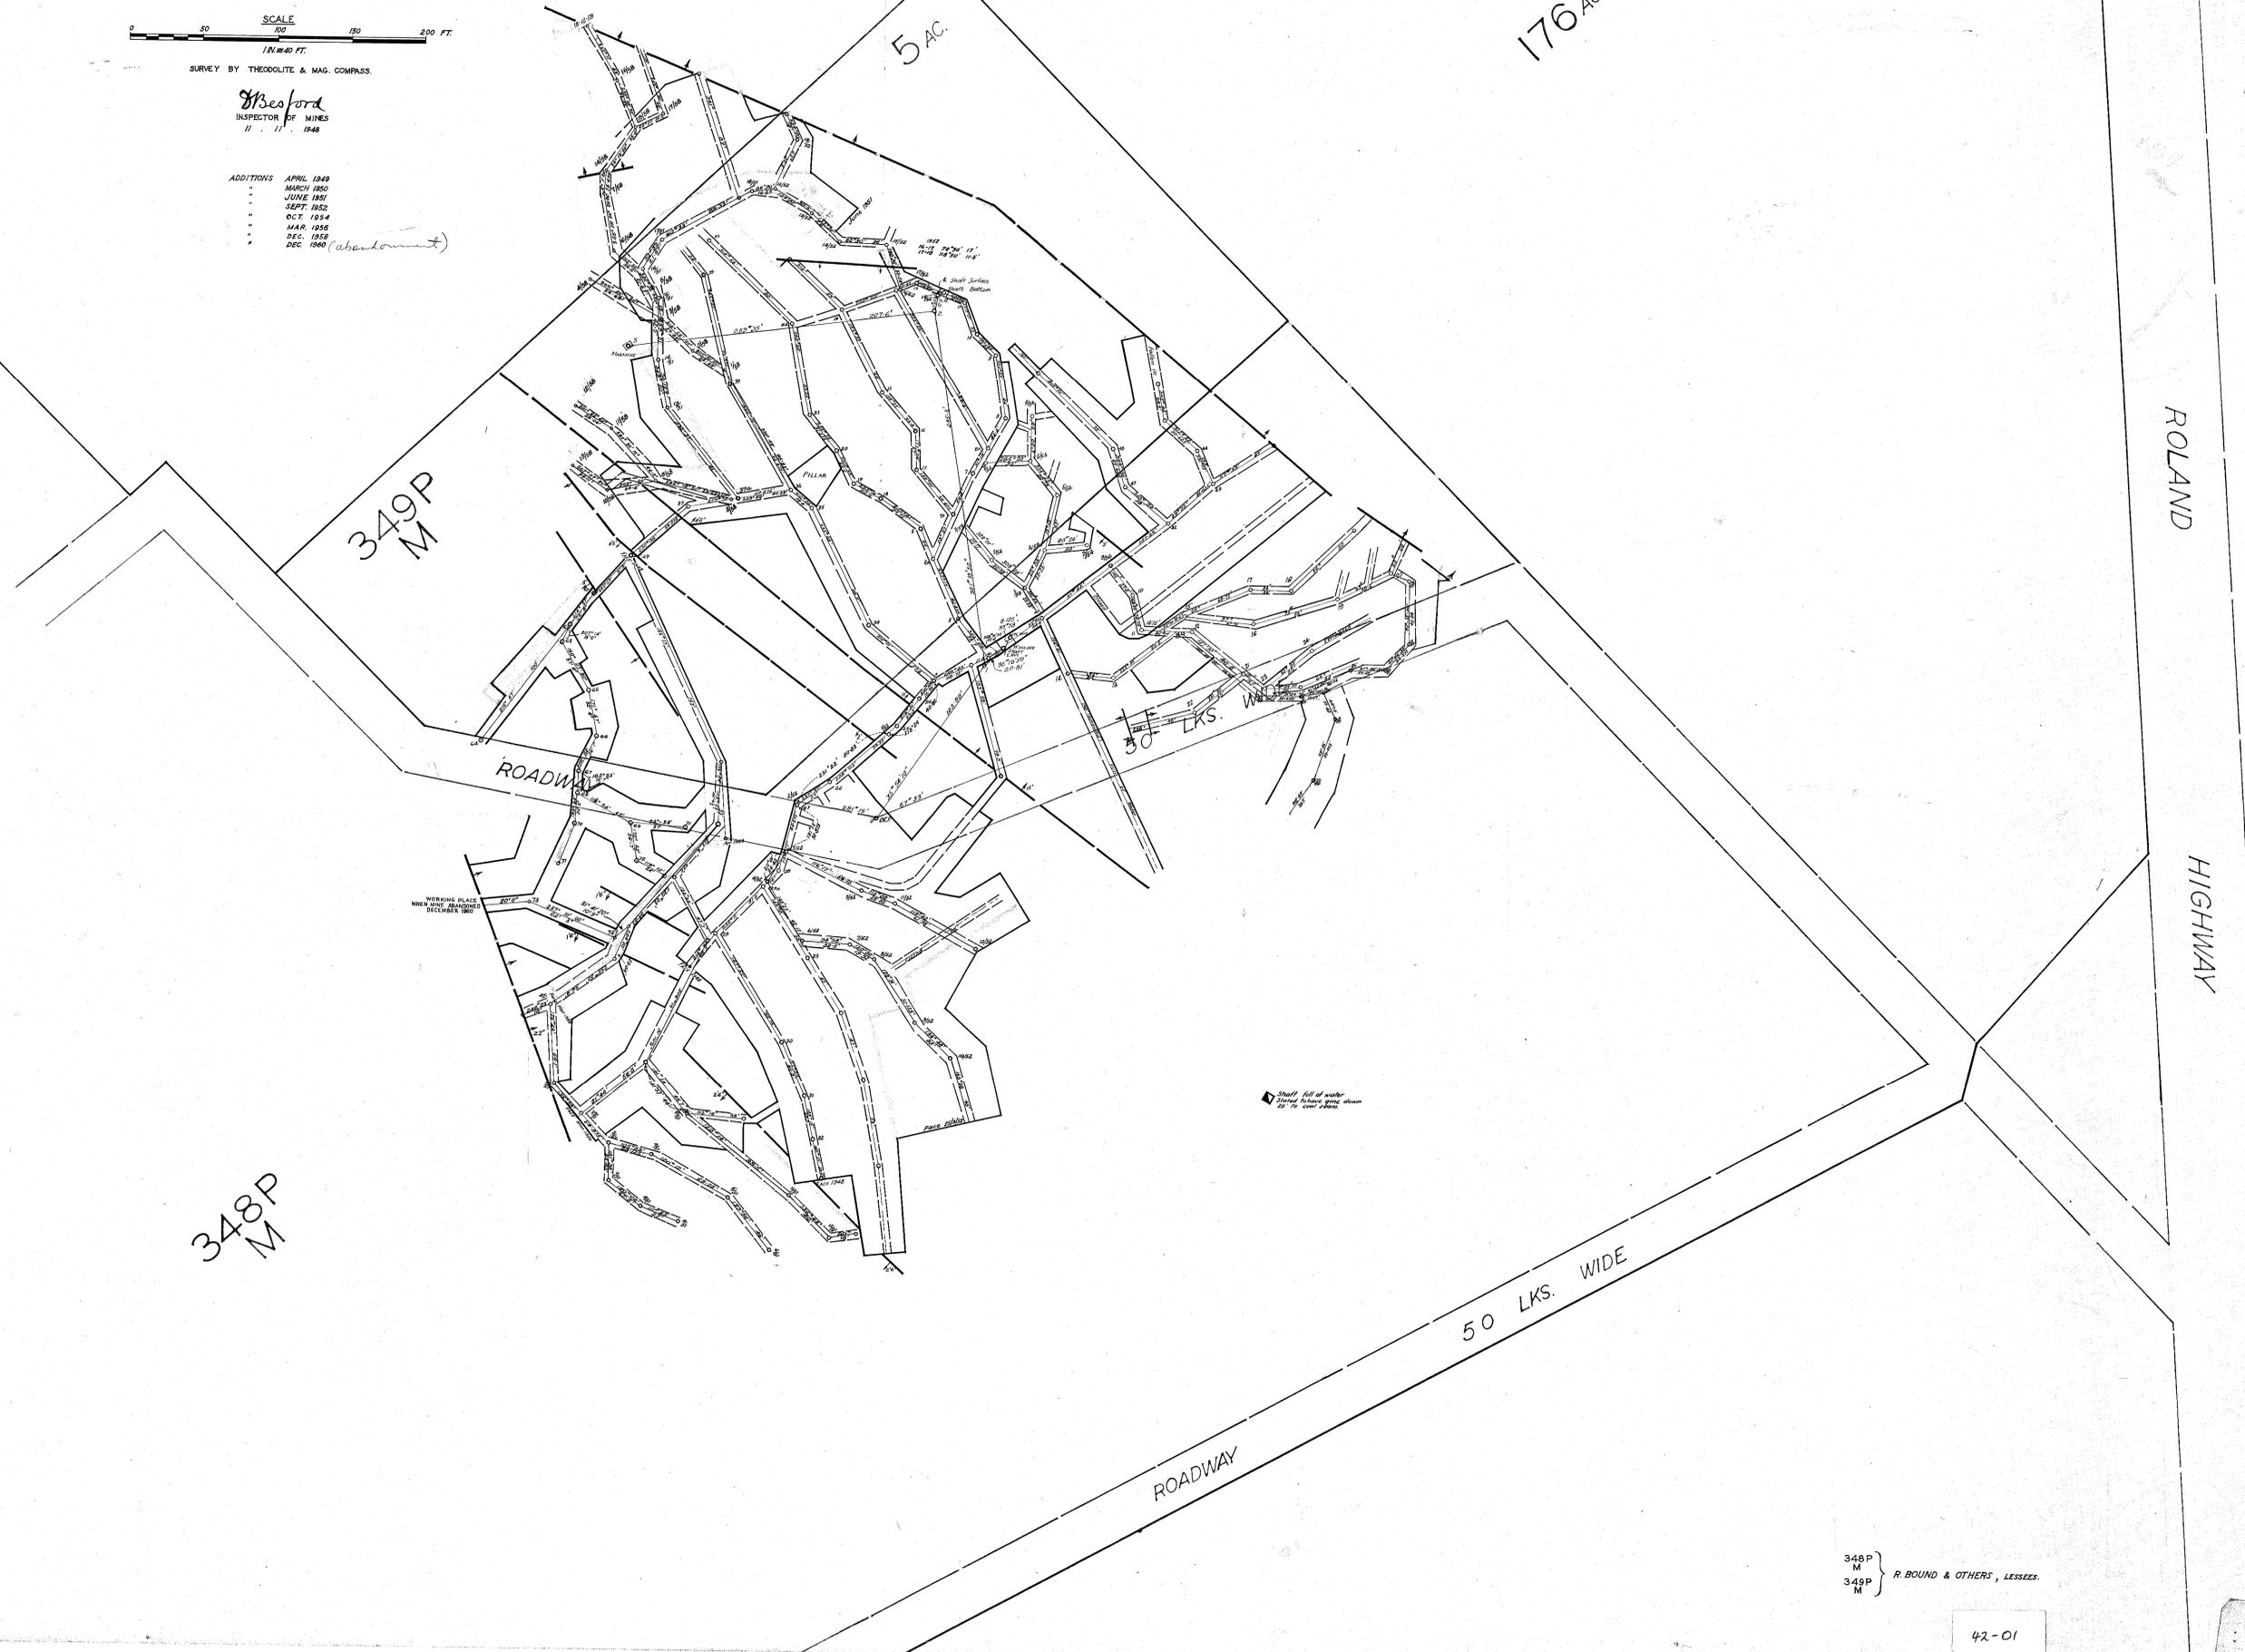

348P }  
M }  
349P }  
M }  
R. BOUND & OTHERS, LESSEES.