
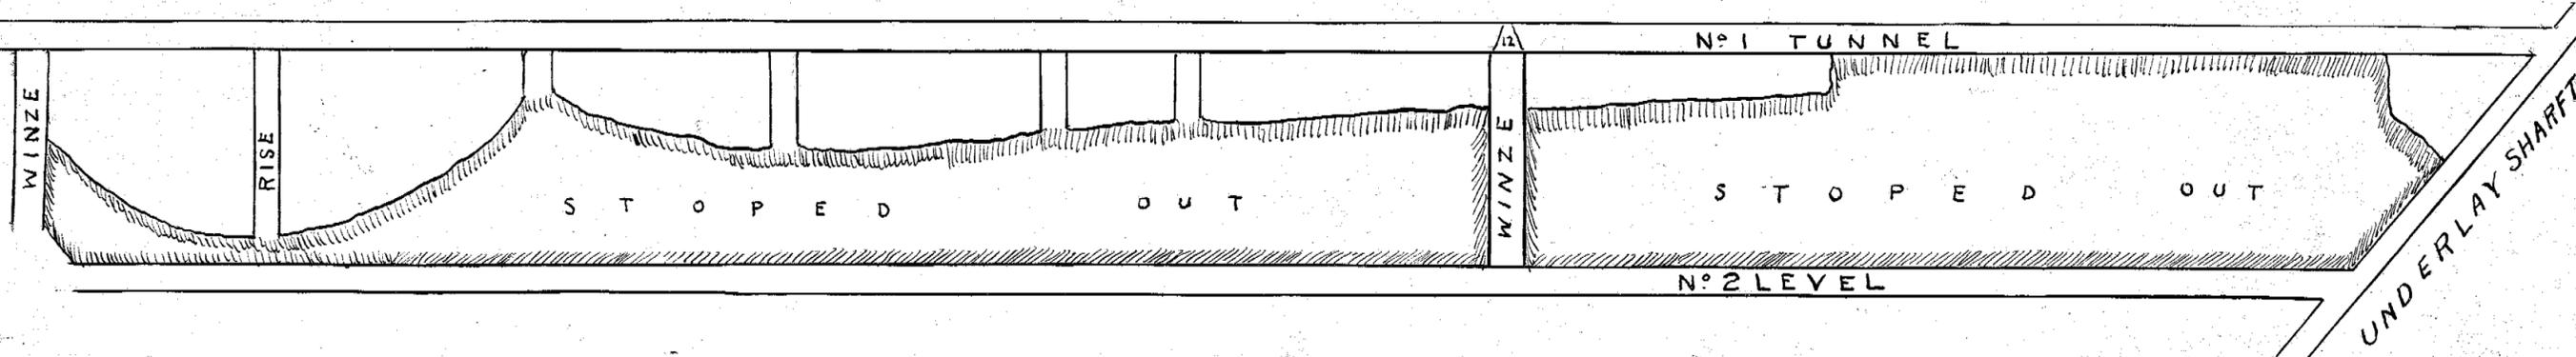


5 cm

ROYAL GEORGE T.M.

Scale 40 ft. to inch.

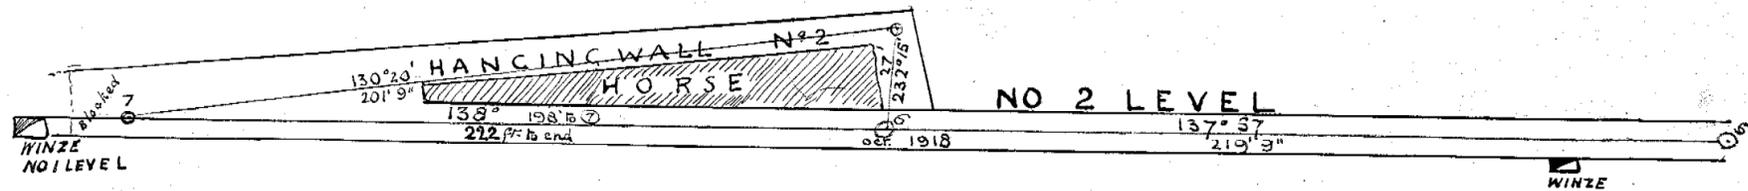

Extension of workings
 since 20/9/18
 Certified Correct
 R. D. Watson
 Dick. W. W. W.
 Survey with theodolite
 25/10/20

45-01