


5 cm

ROYAL GEORGE T.M.

Scale 40 ft. to inch

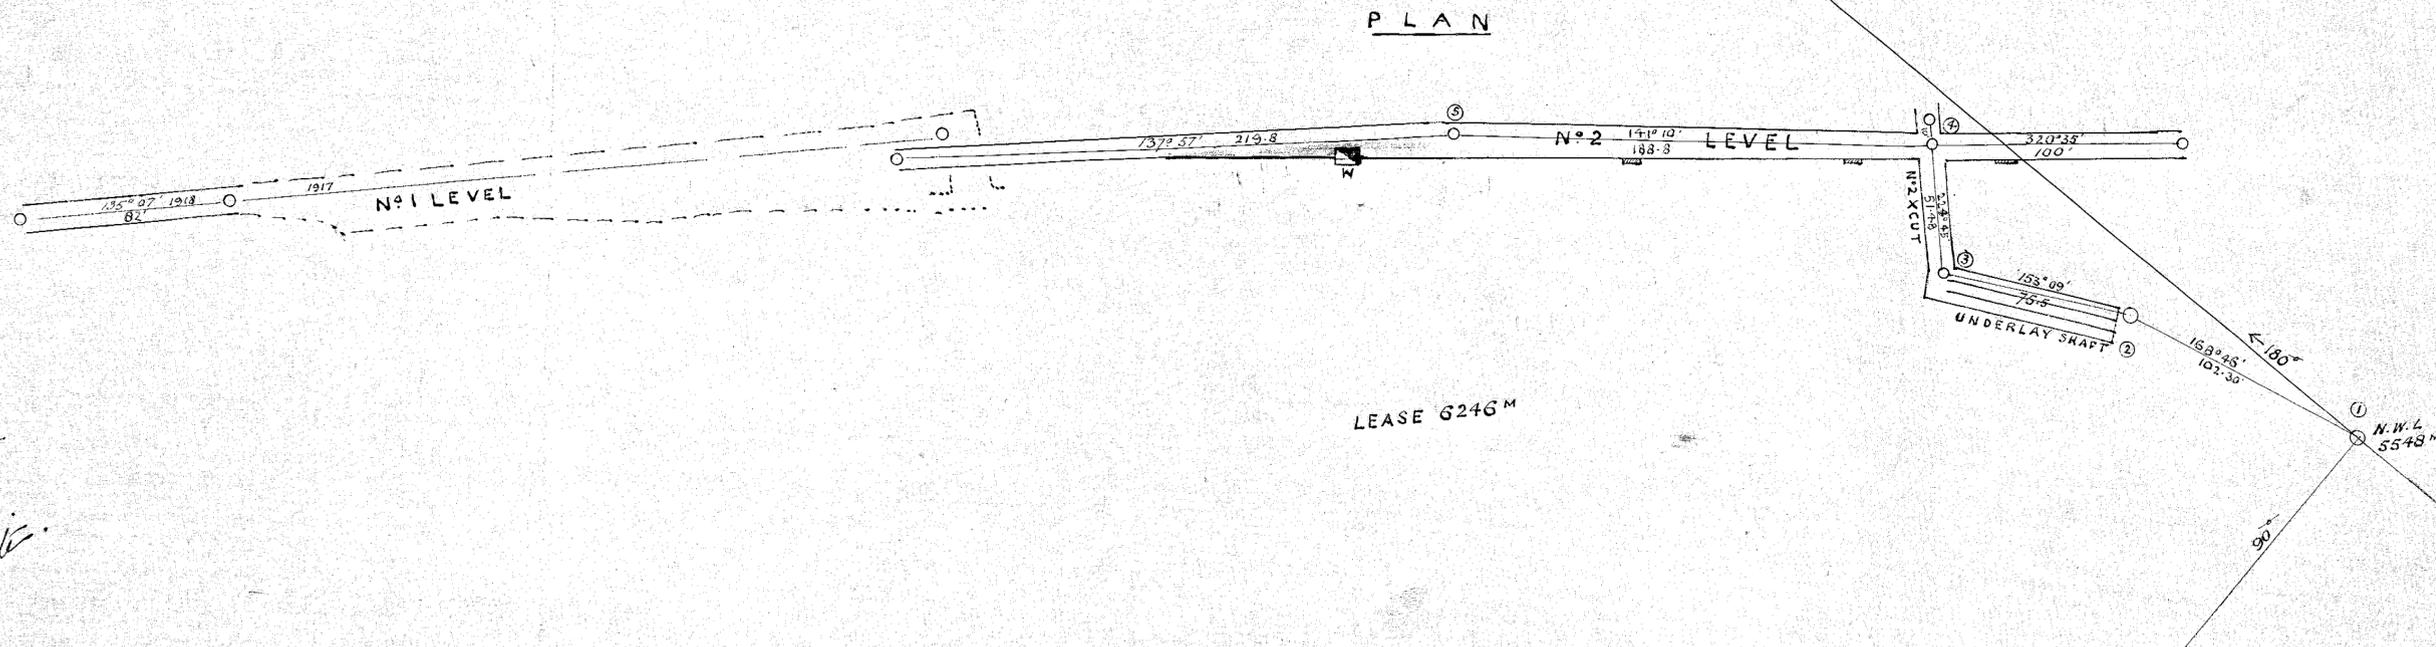

*Study whether this is
a correct copy of plan of
work to Dept. of Mines
to Prince Rupert
Adk. Commission
arranged with theodolite.*

LONGITUDINAL SECTION

