



SCALE 40 FT TO 1. INCH.

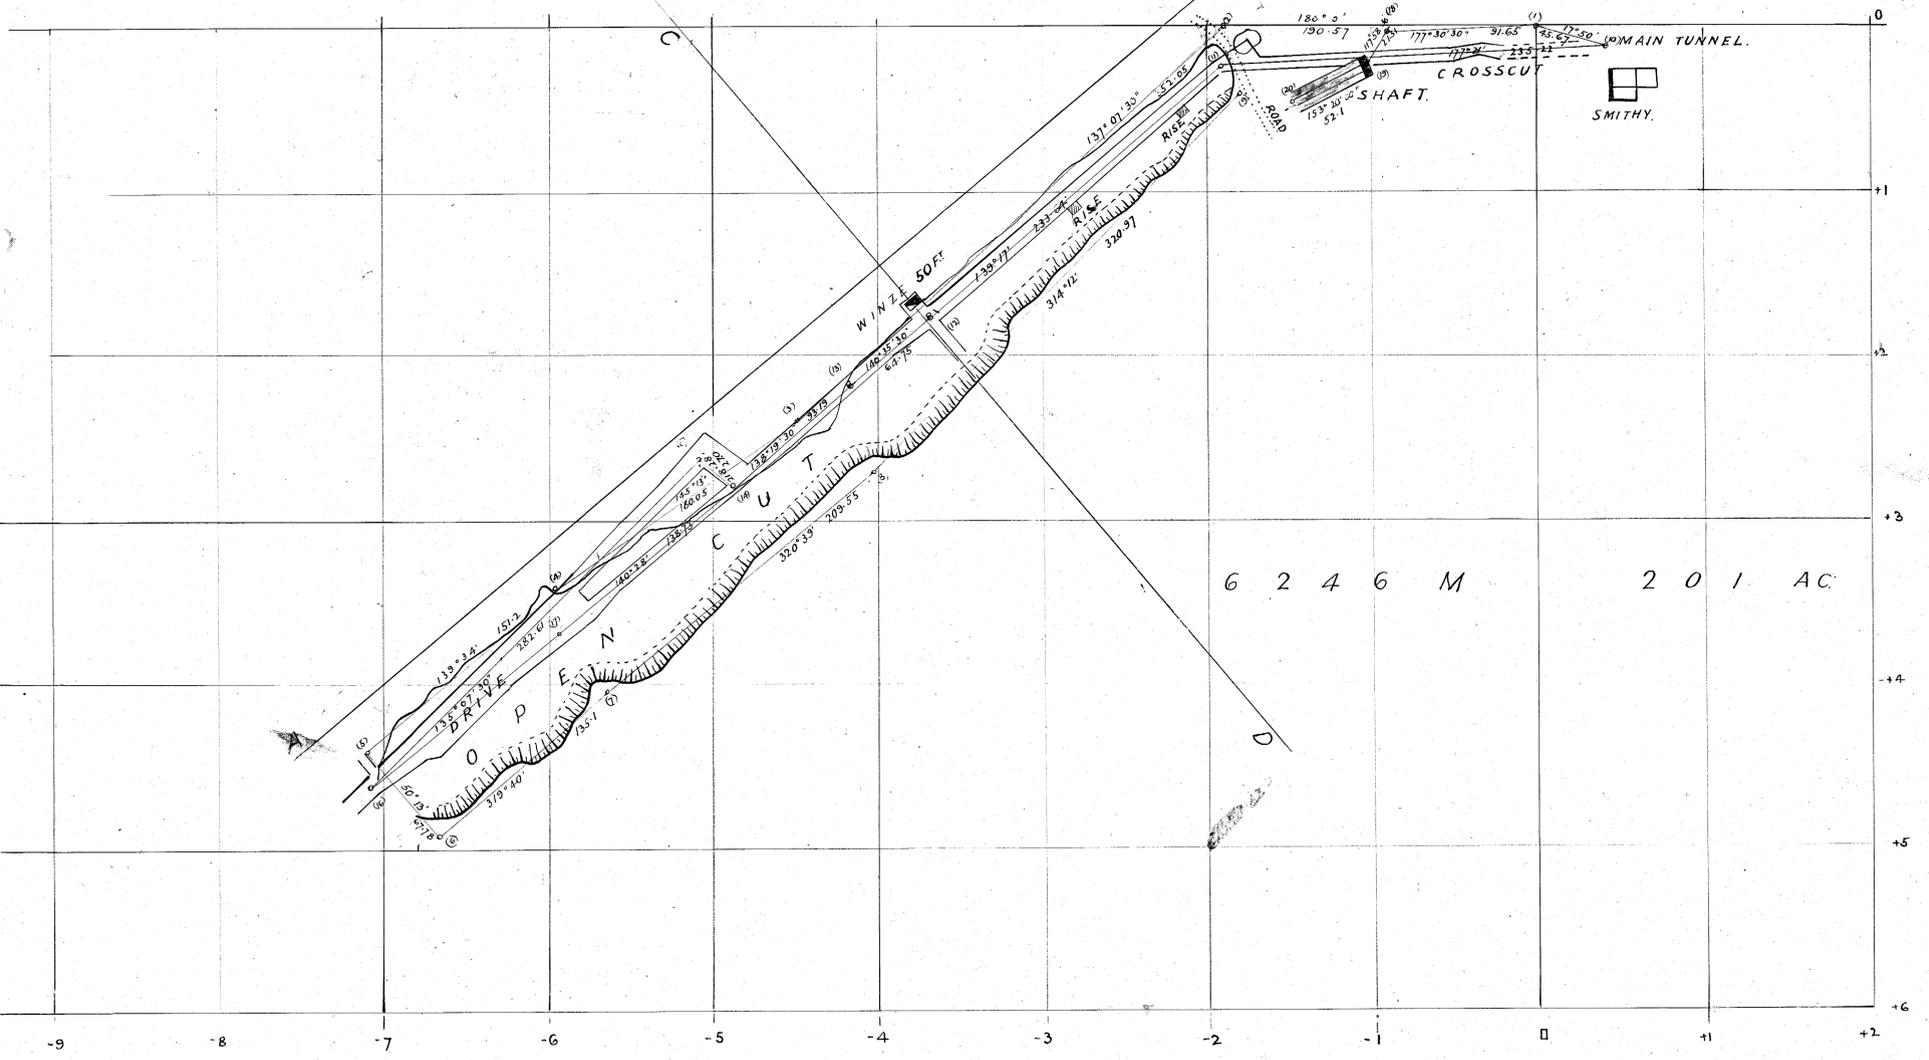


LONGITUDINAL SECTION

PROJECTION ON AB

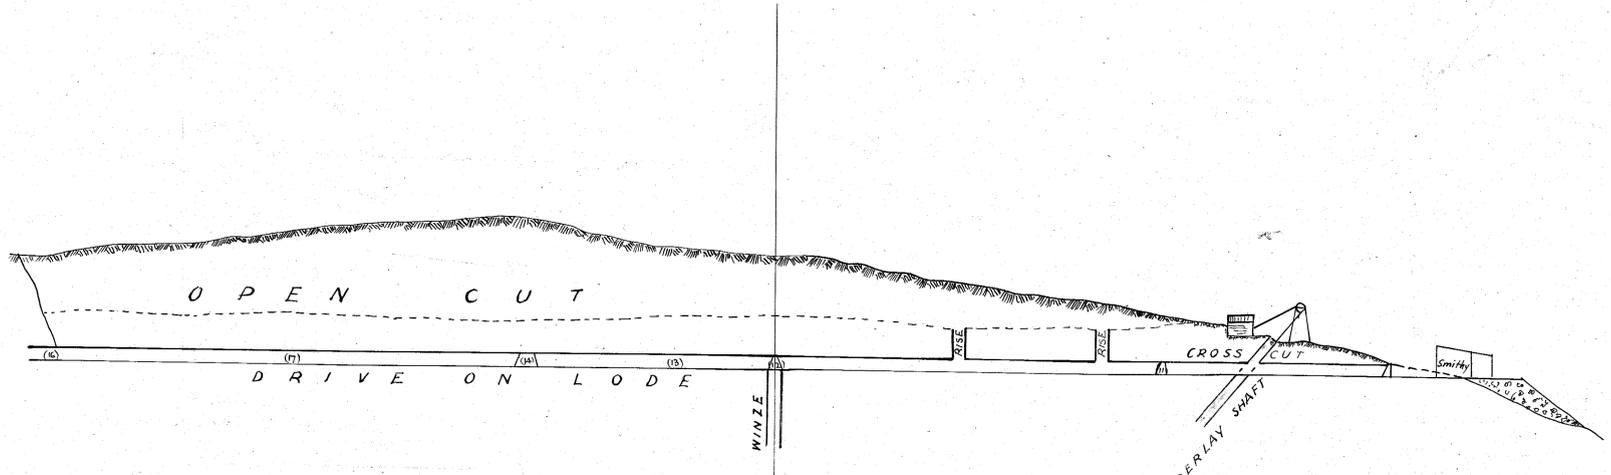

TRANSVERSE SECTION

PROJECTION ON LINE CD

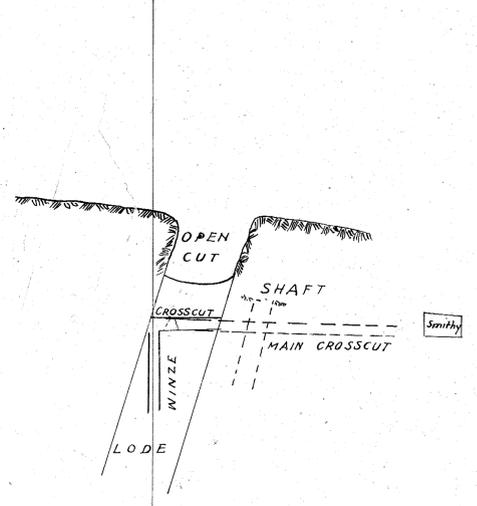

Surveyed by  
A. H. Reid  
4th May 1917  
5th Thredbo