
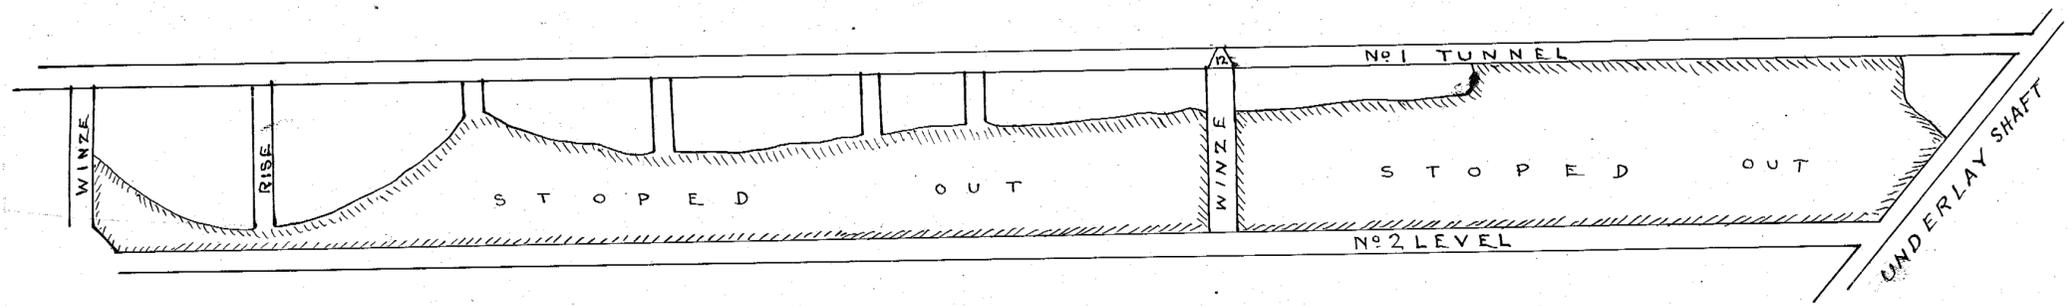


5 cm

ROYAL GEORGE T.M.

Scale 40ft. to Inch

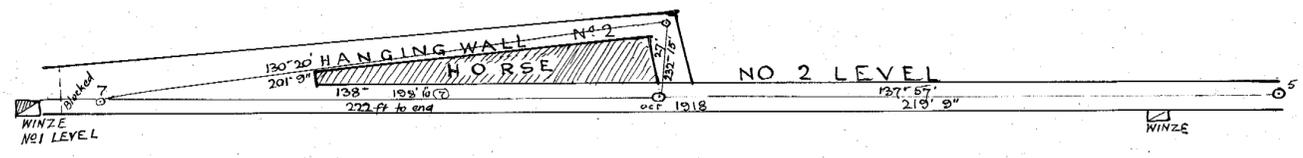

Extension of workings
 since 20/9/18
 Certified correct
 (Dd) C Bingley Watchorn
 Authd Surveyor
 Survey with theodolite
 25/10/20

45-06