


5 cm



END OPEN CUT

SURFACE & UNDERGROUND WORKINGS ROYAL GEORGE MINE

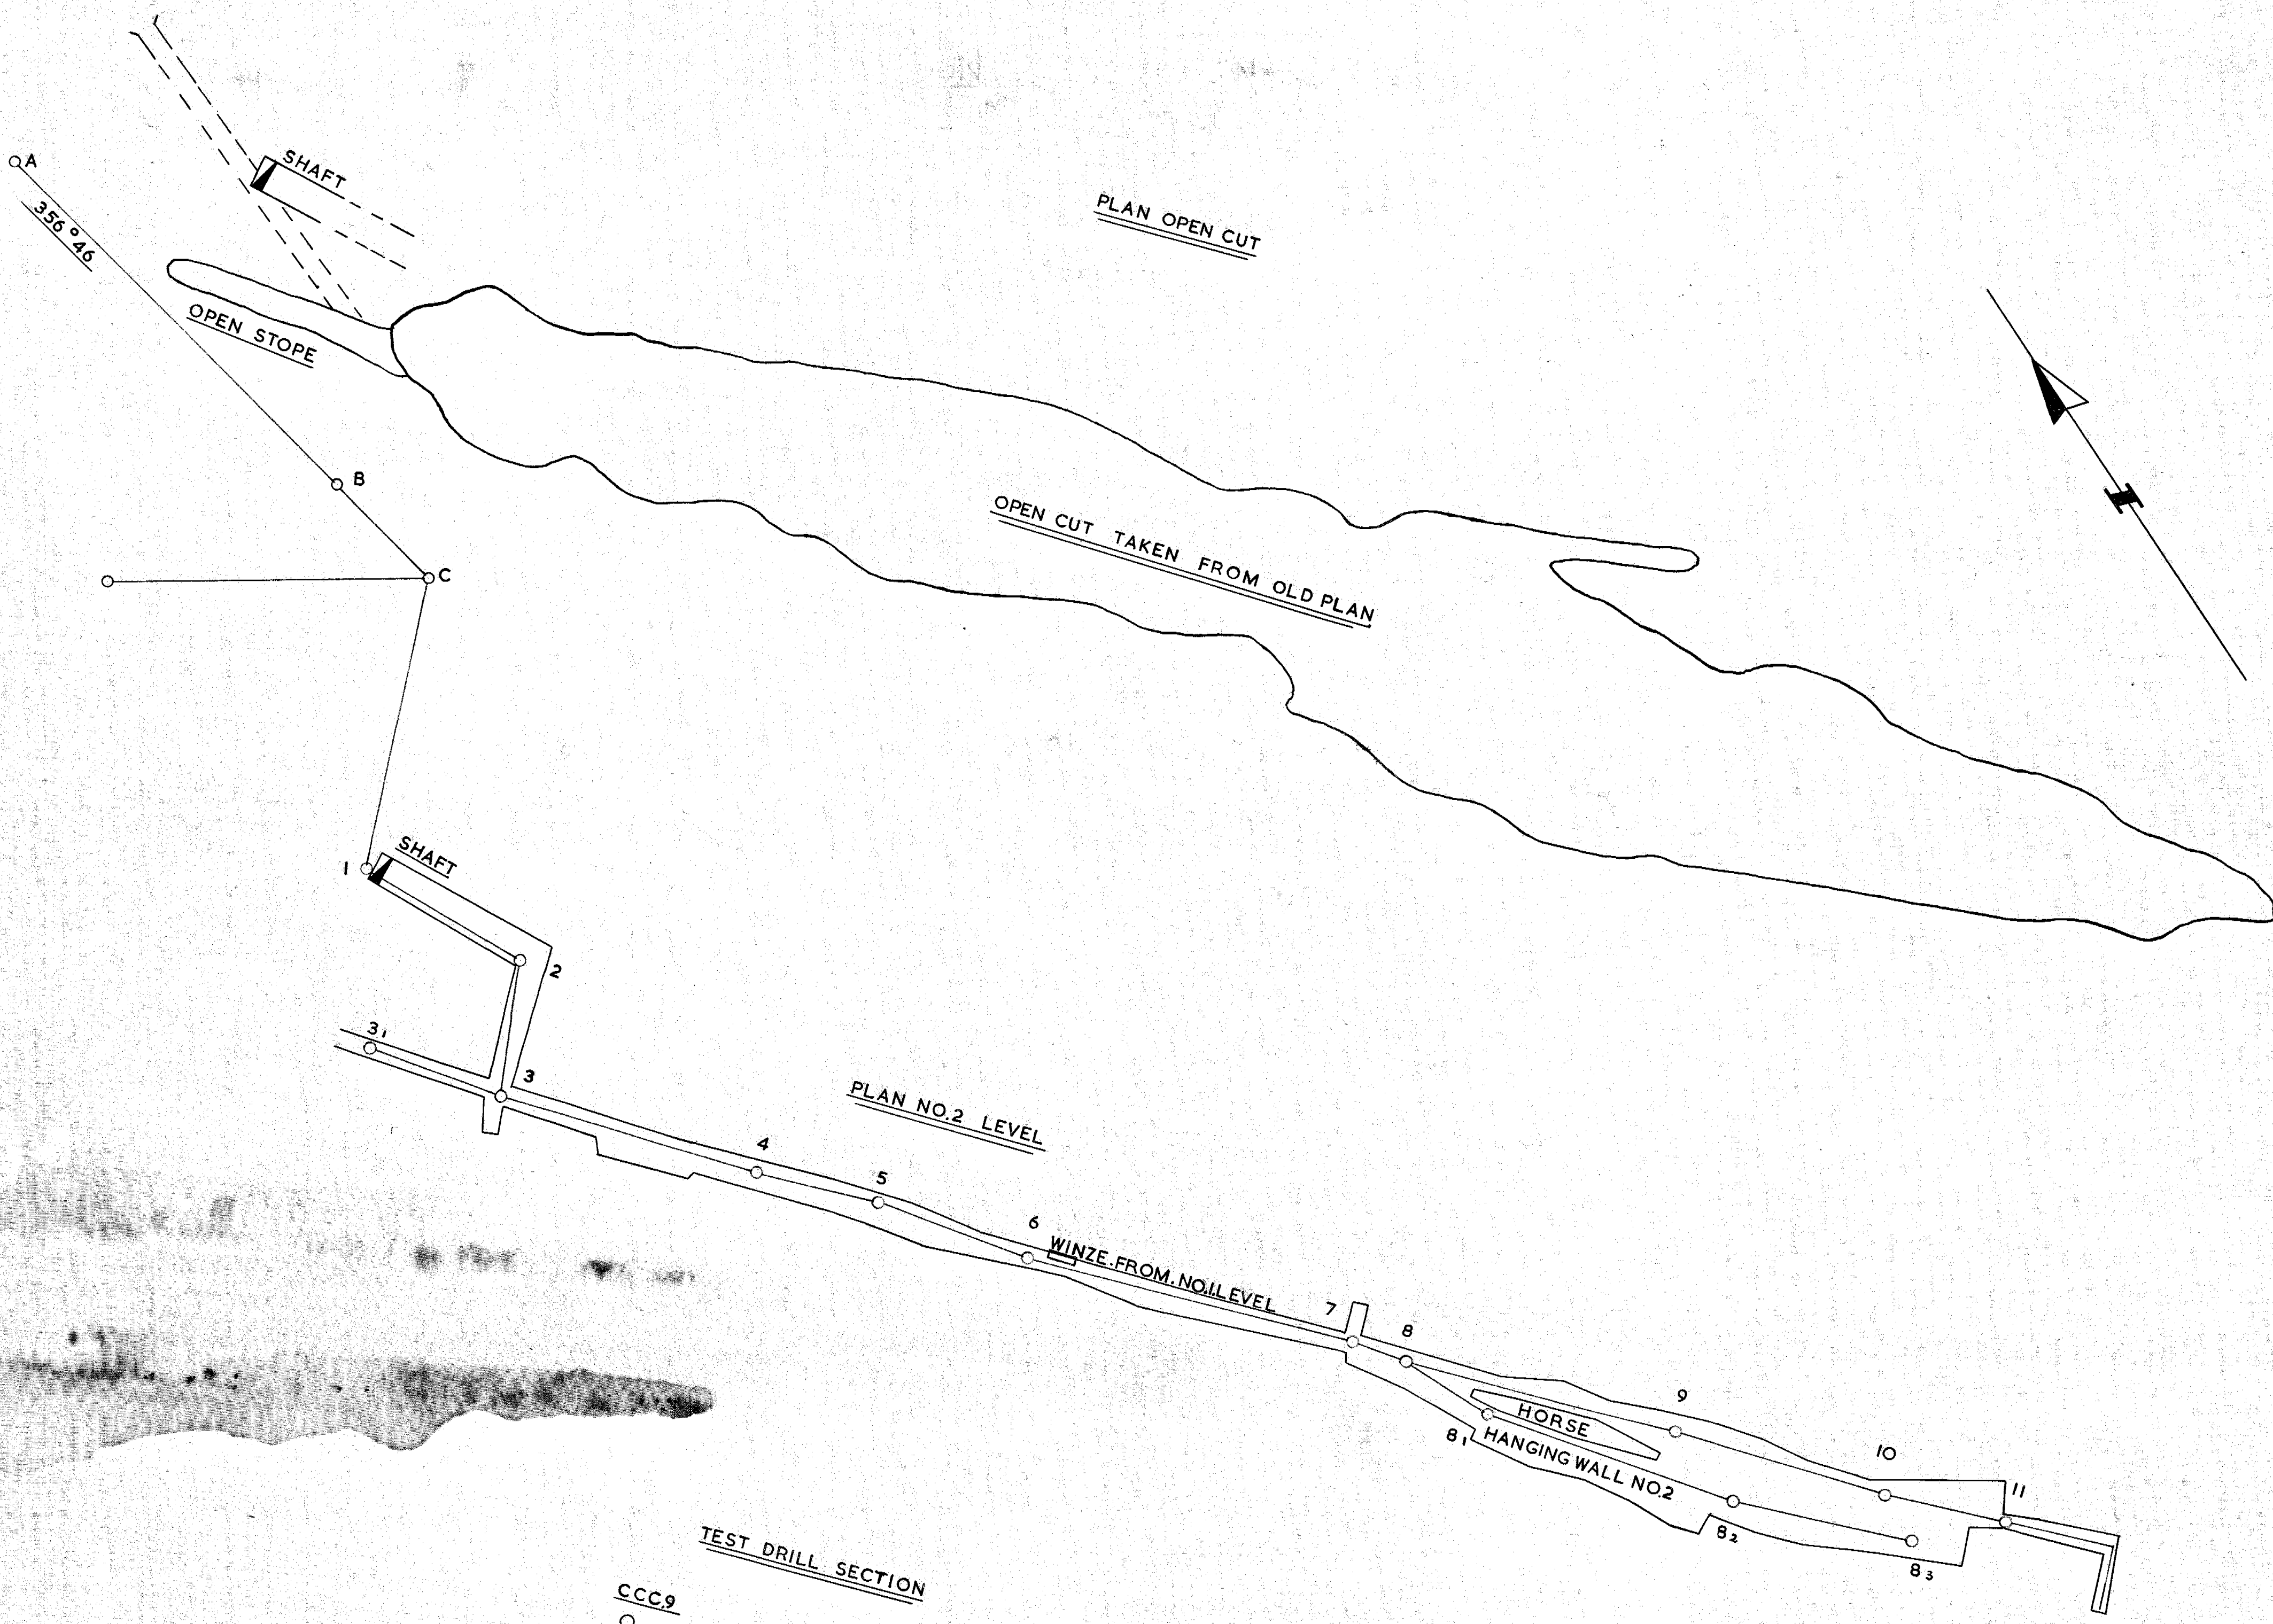