


46-01

James Ludovick Barnett
Gardners Bay 1801

5 cm

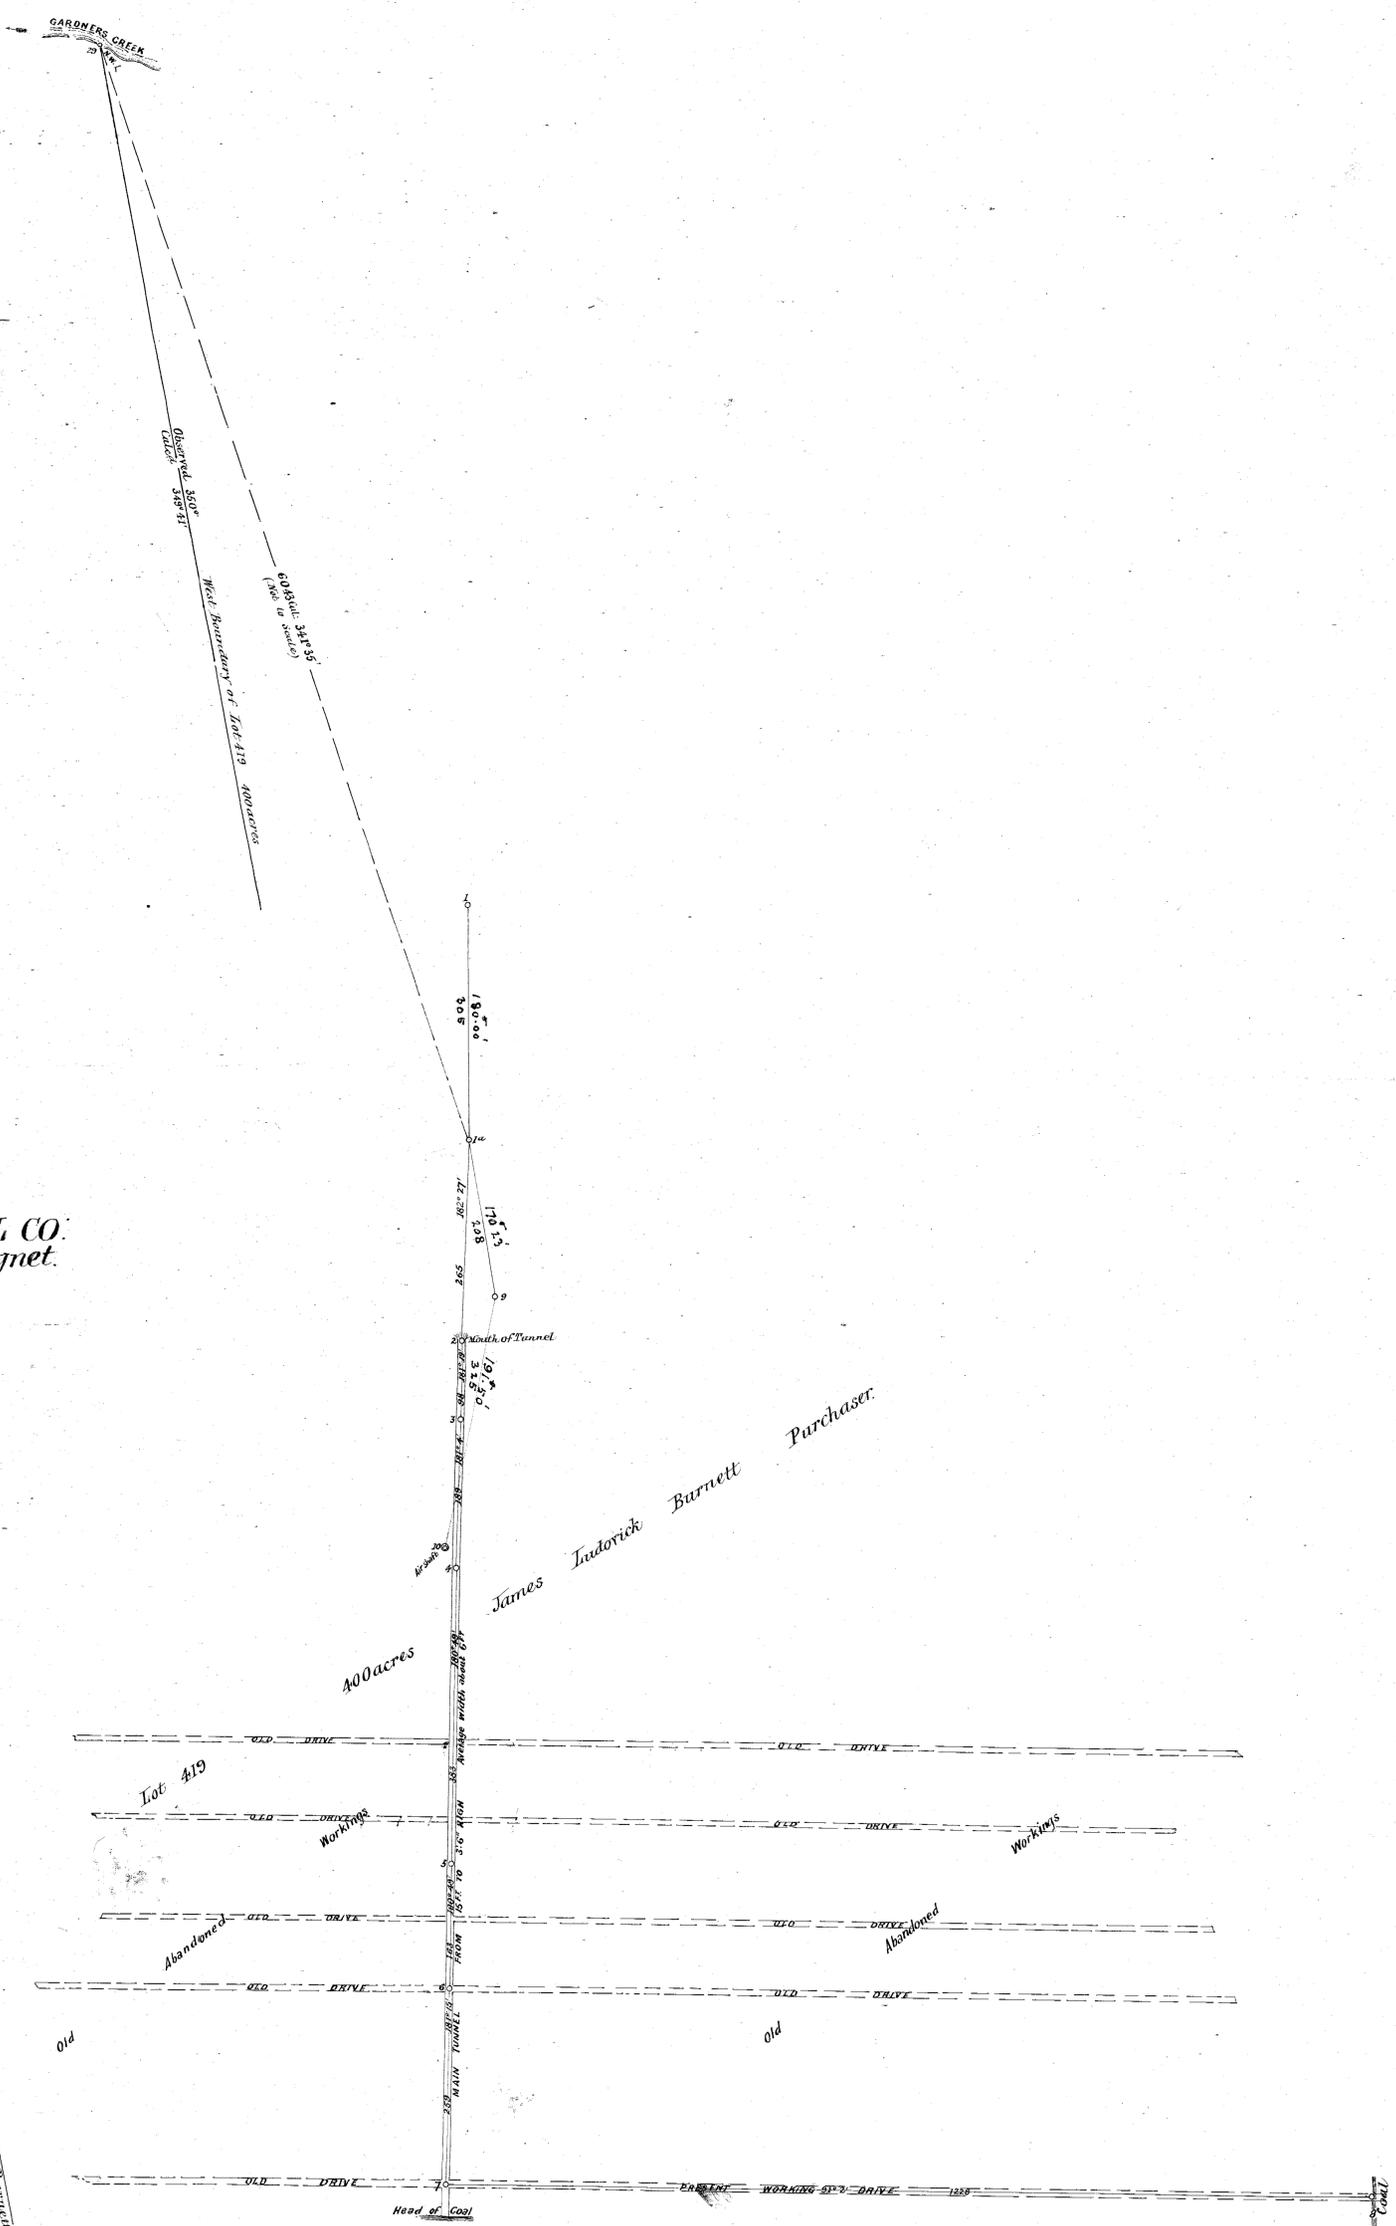

MOUNT CYGNET COAL CO.
Gardners Bay Port Cygnet.

Scale One chain to an Inch



Elphines
District Surveyor.
7. 8. 1901

Instrument used - Theodolite

46-01

James Ludovick Barnett
1801

West boundary of Lot 419 400 acres (see continuation above)