


5 cm

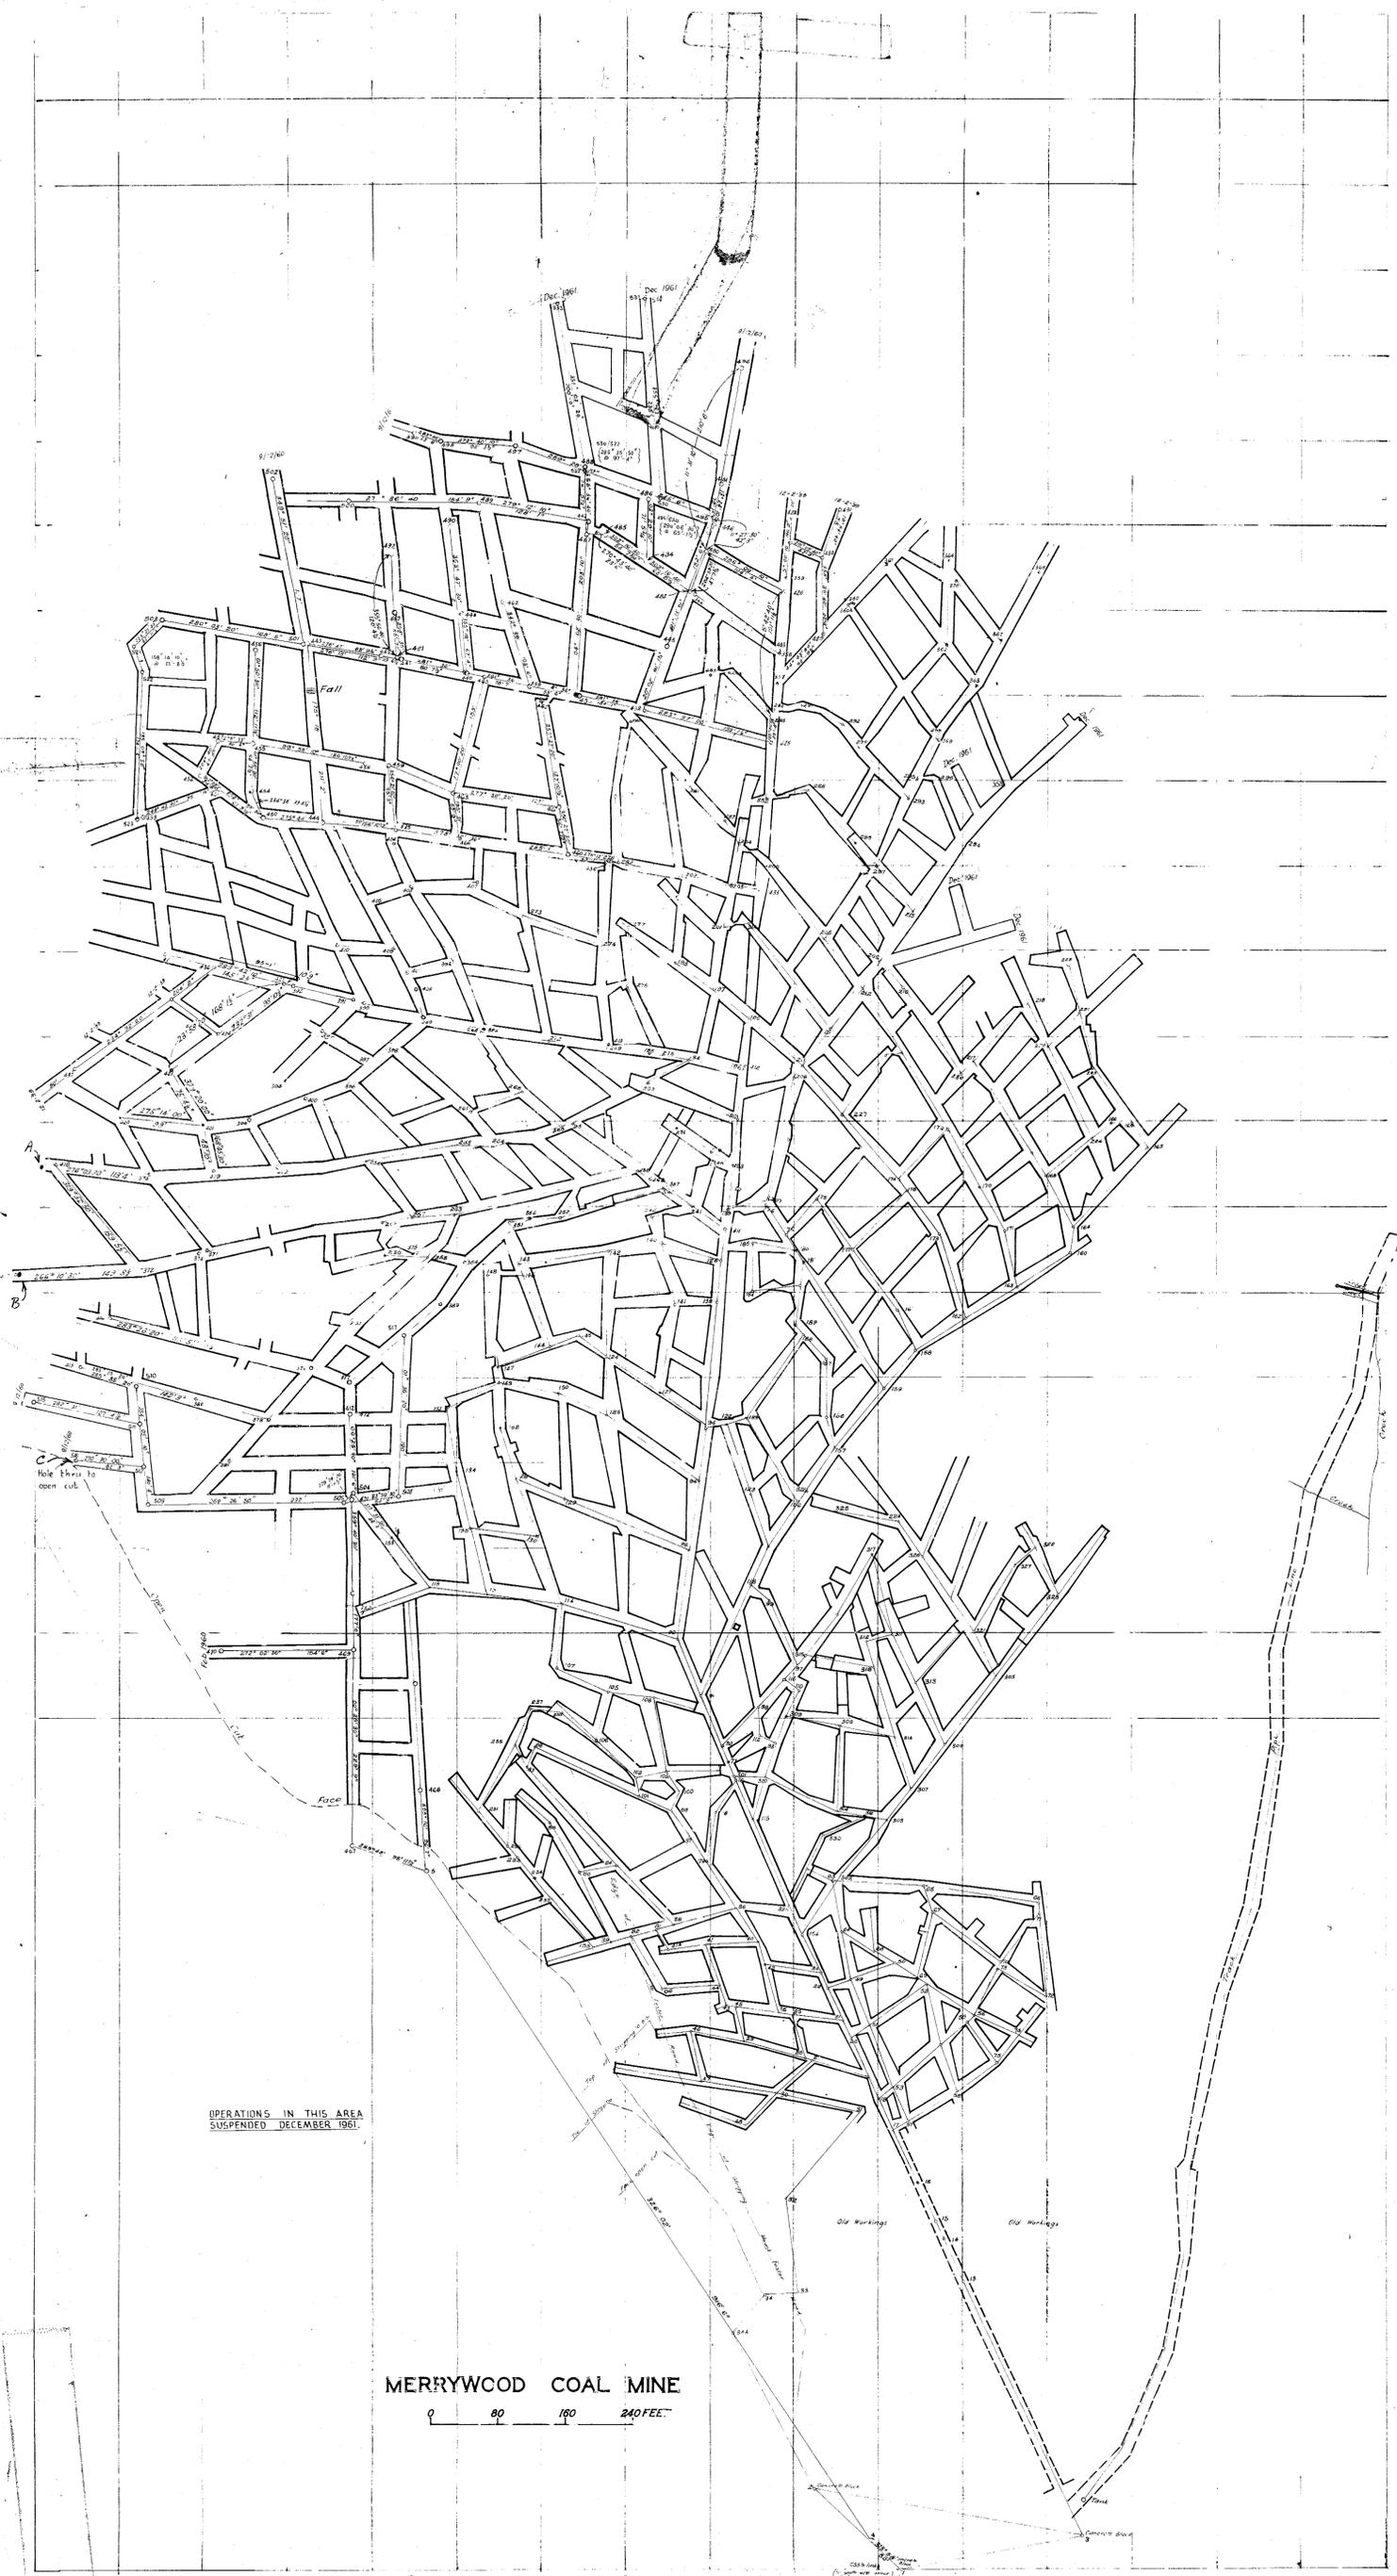

B
C
Hole thru open cut

OPERATIONS IN THIS AREA
SUSPENDED DECEMBER 1961.

MERRYWOOD COAL MINE

0 80 160 240 FEET

