


5 cm

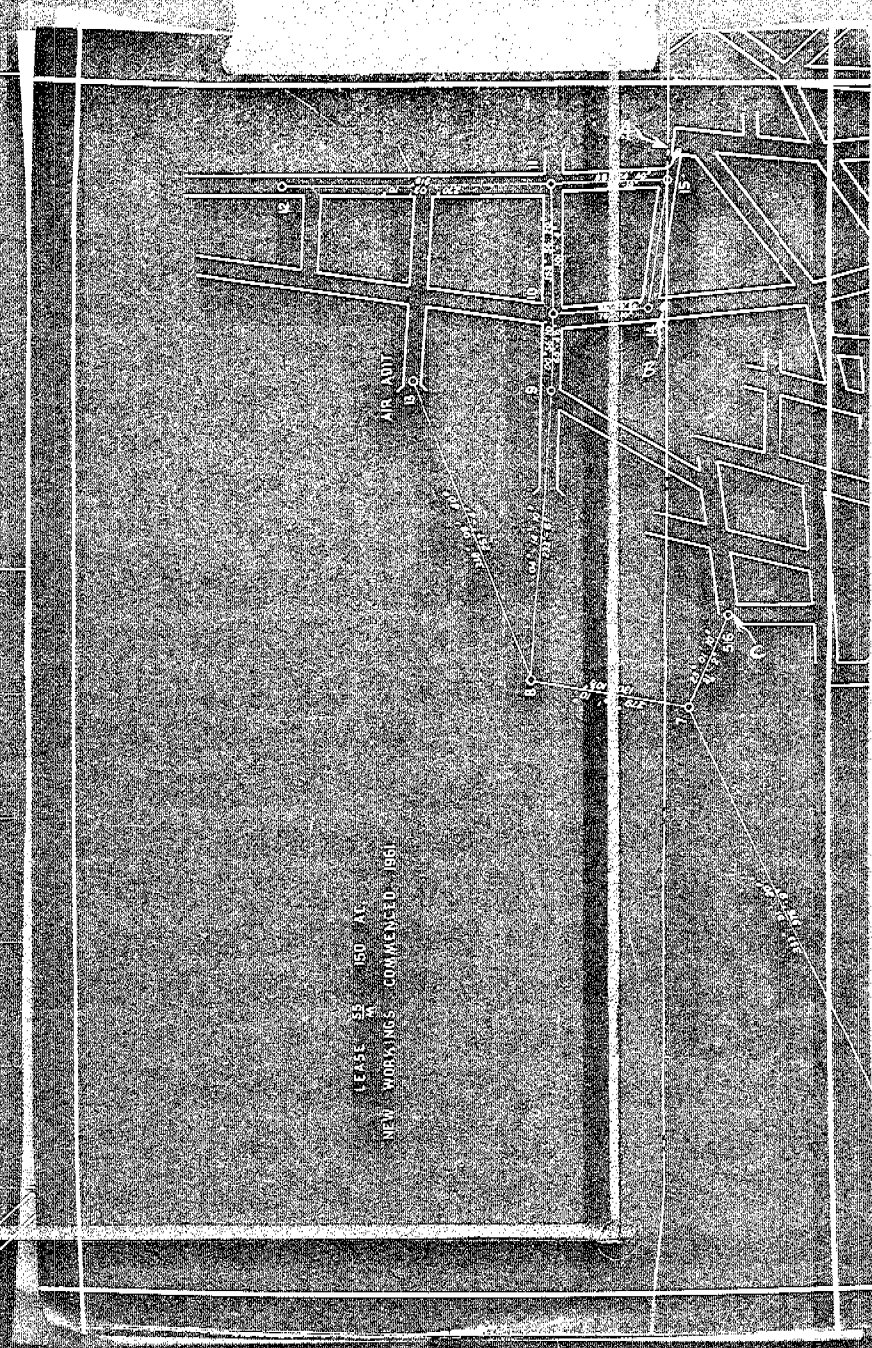

OPERATIONS IN THIS AREA
SUSPENDED DECEMBER 1961

MERRYWOOD COAL MINE

0 80 160 240 FEET

— 453 —

48-02