
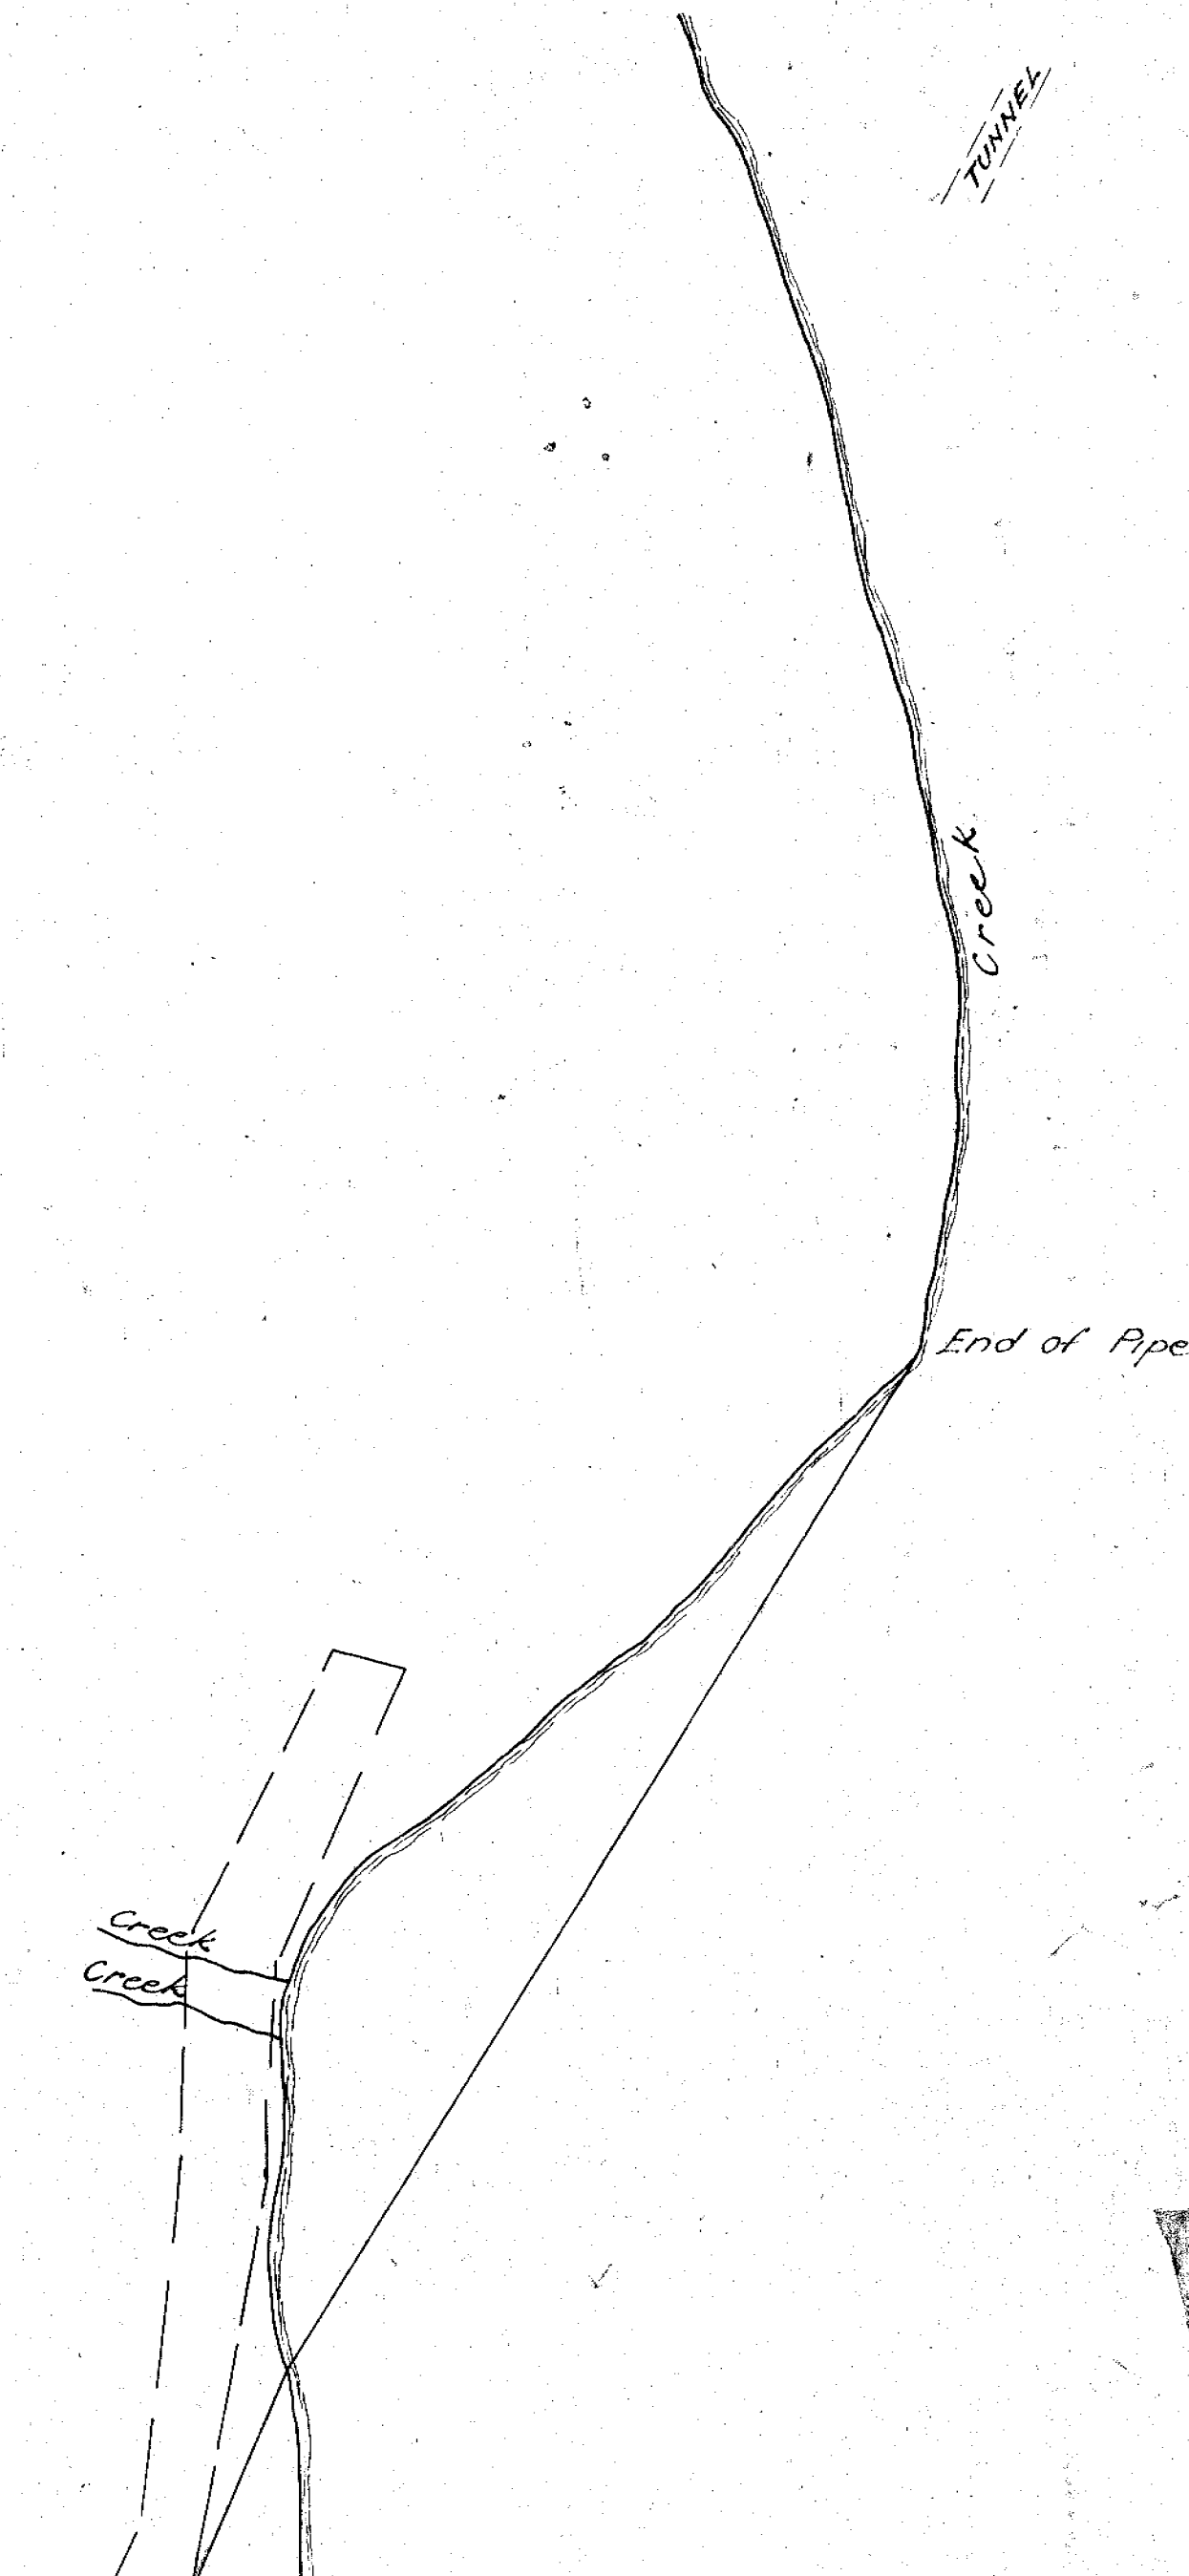


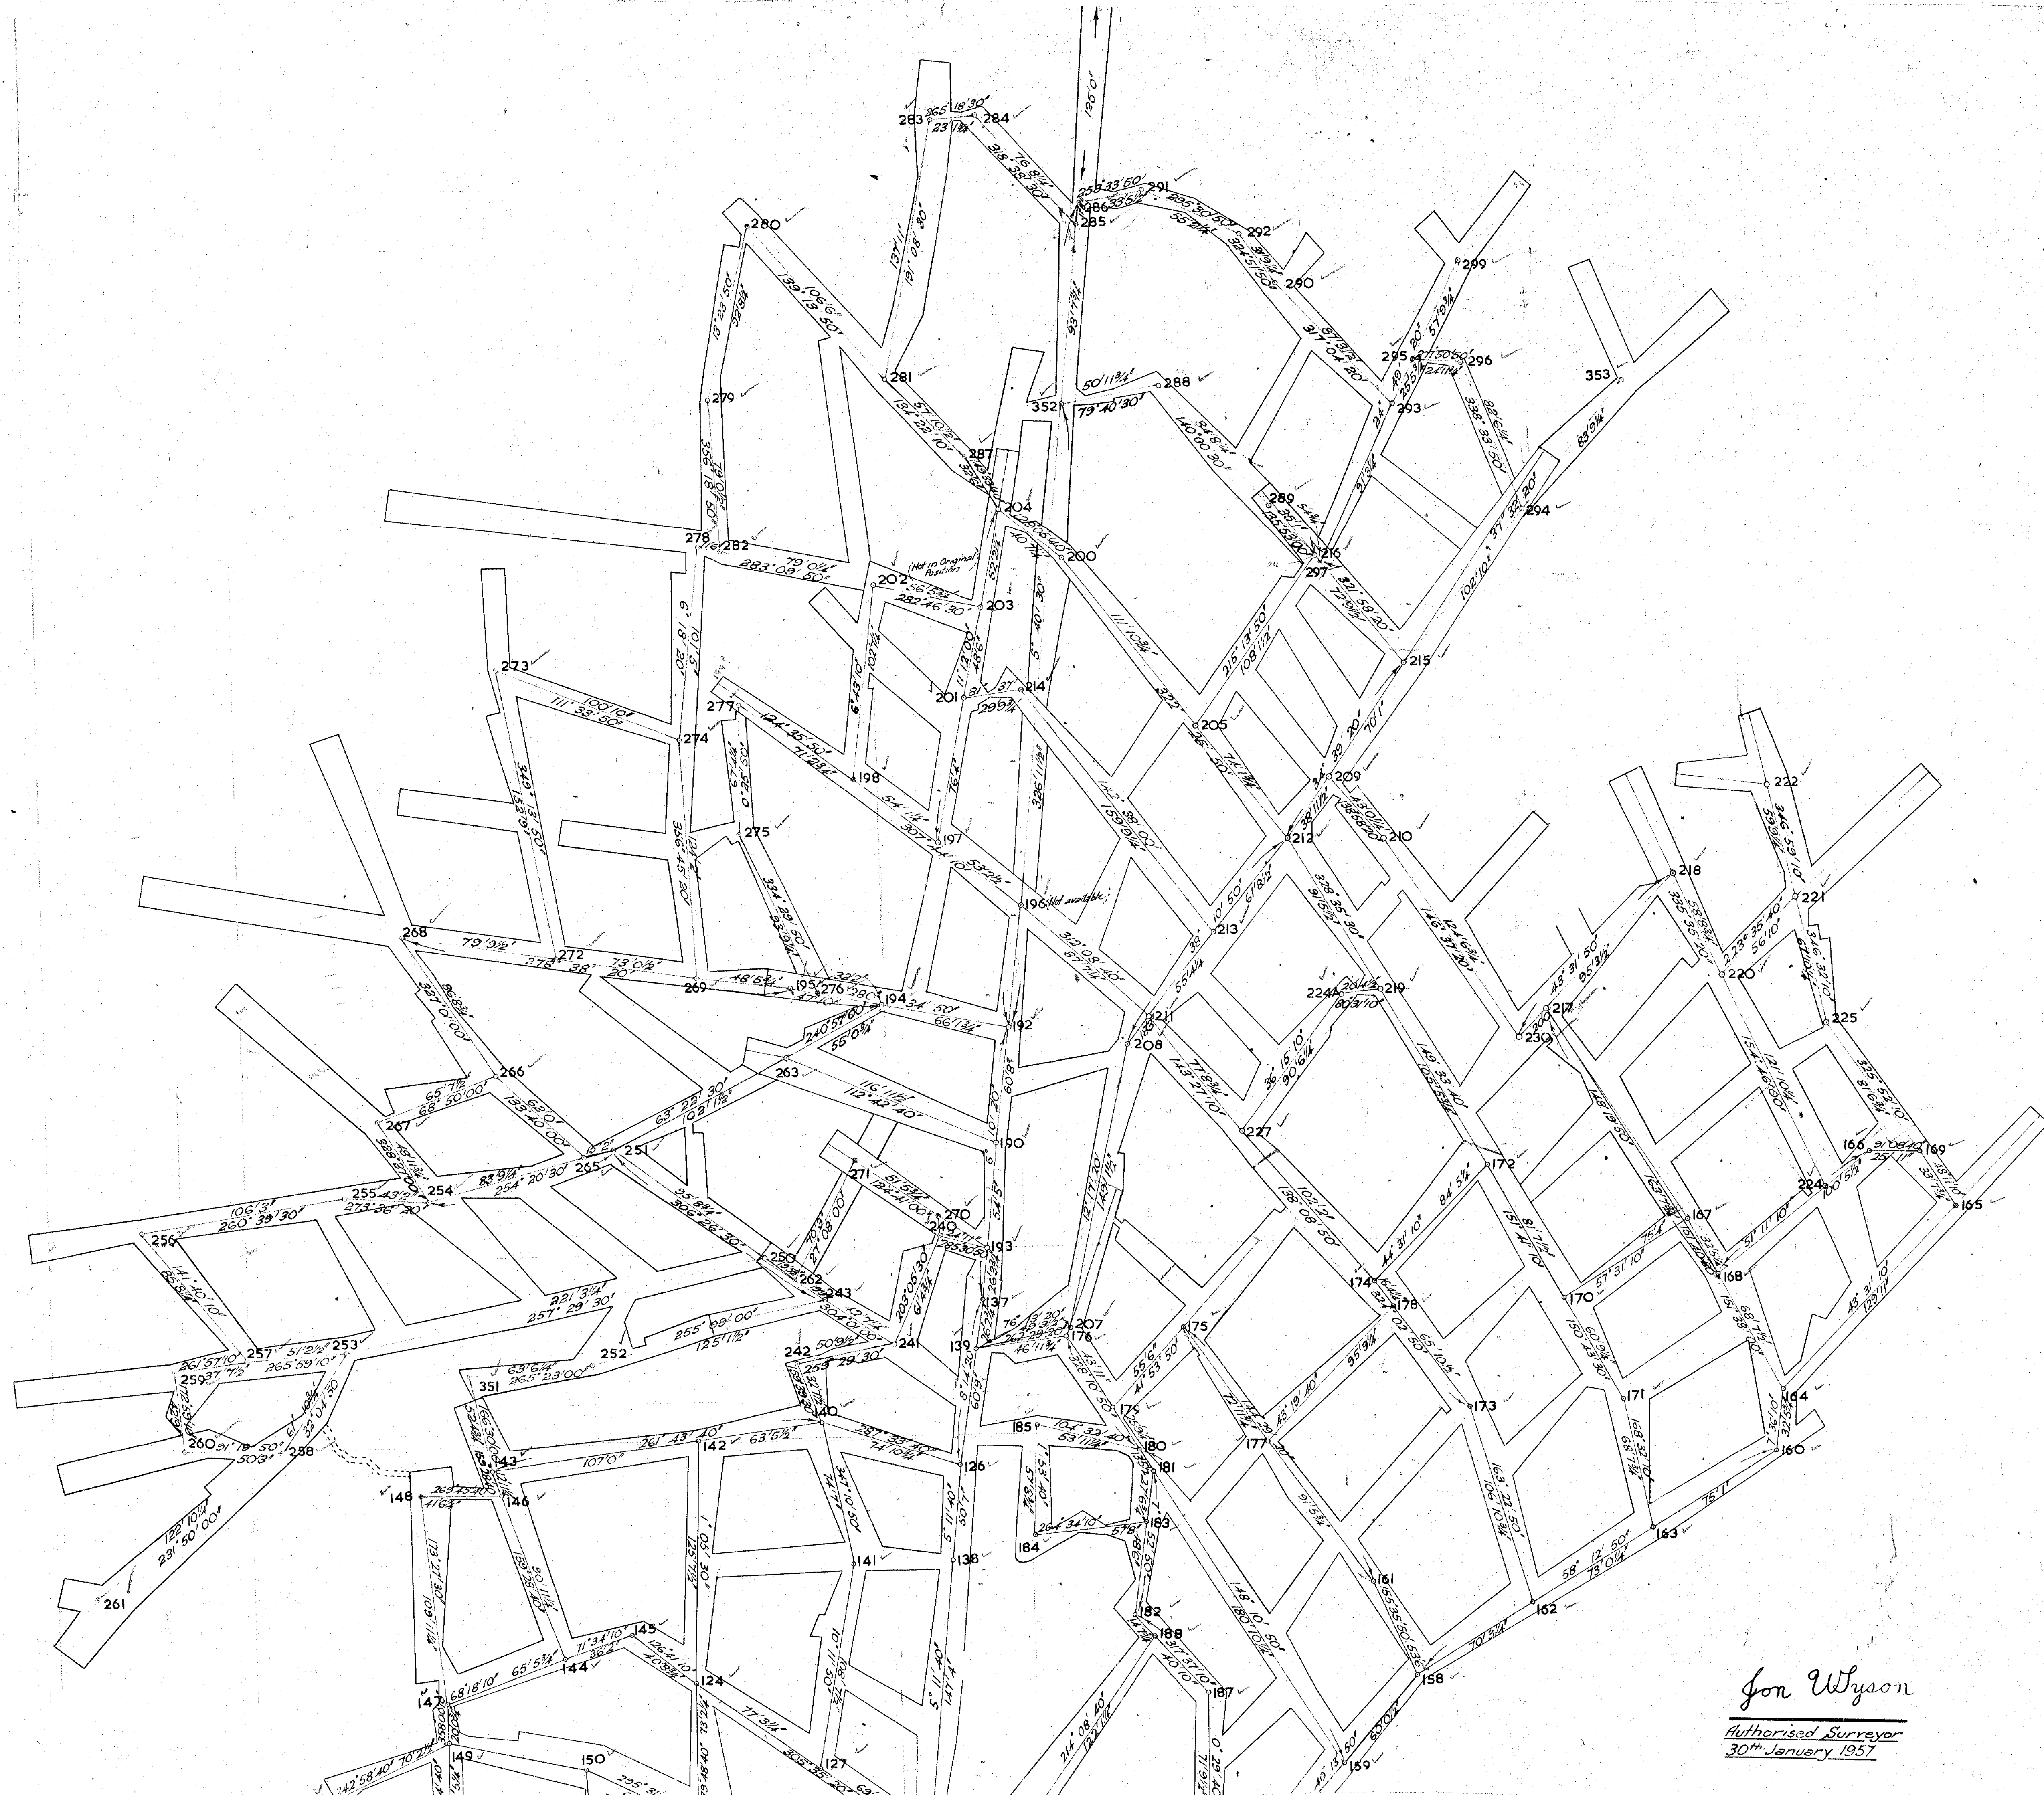

Jon Wyson
Authorised Surveyor
30th January 1957