


5 cm

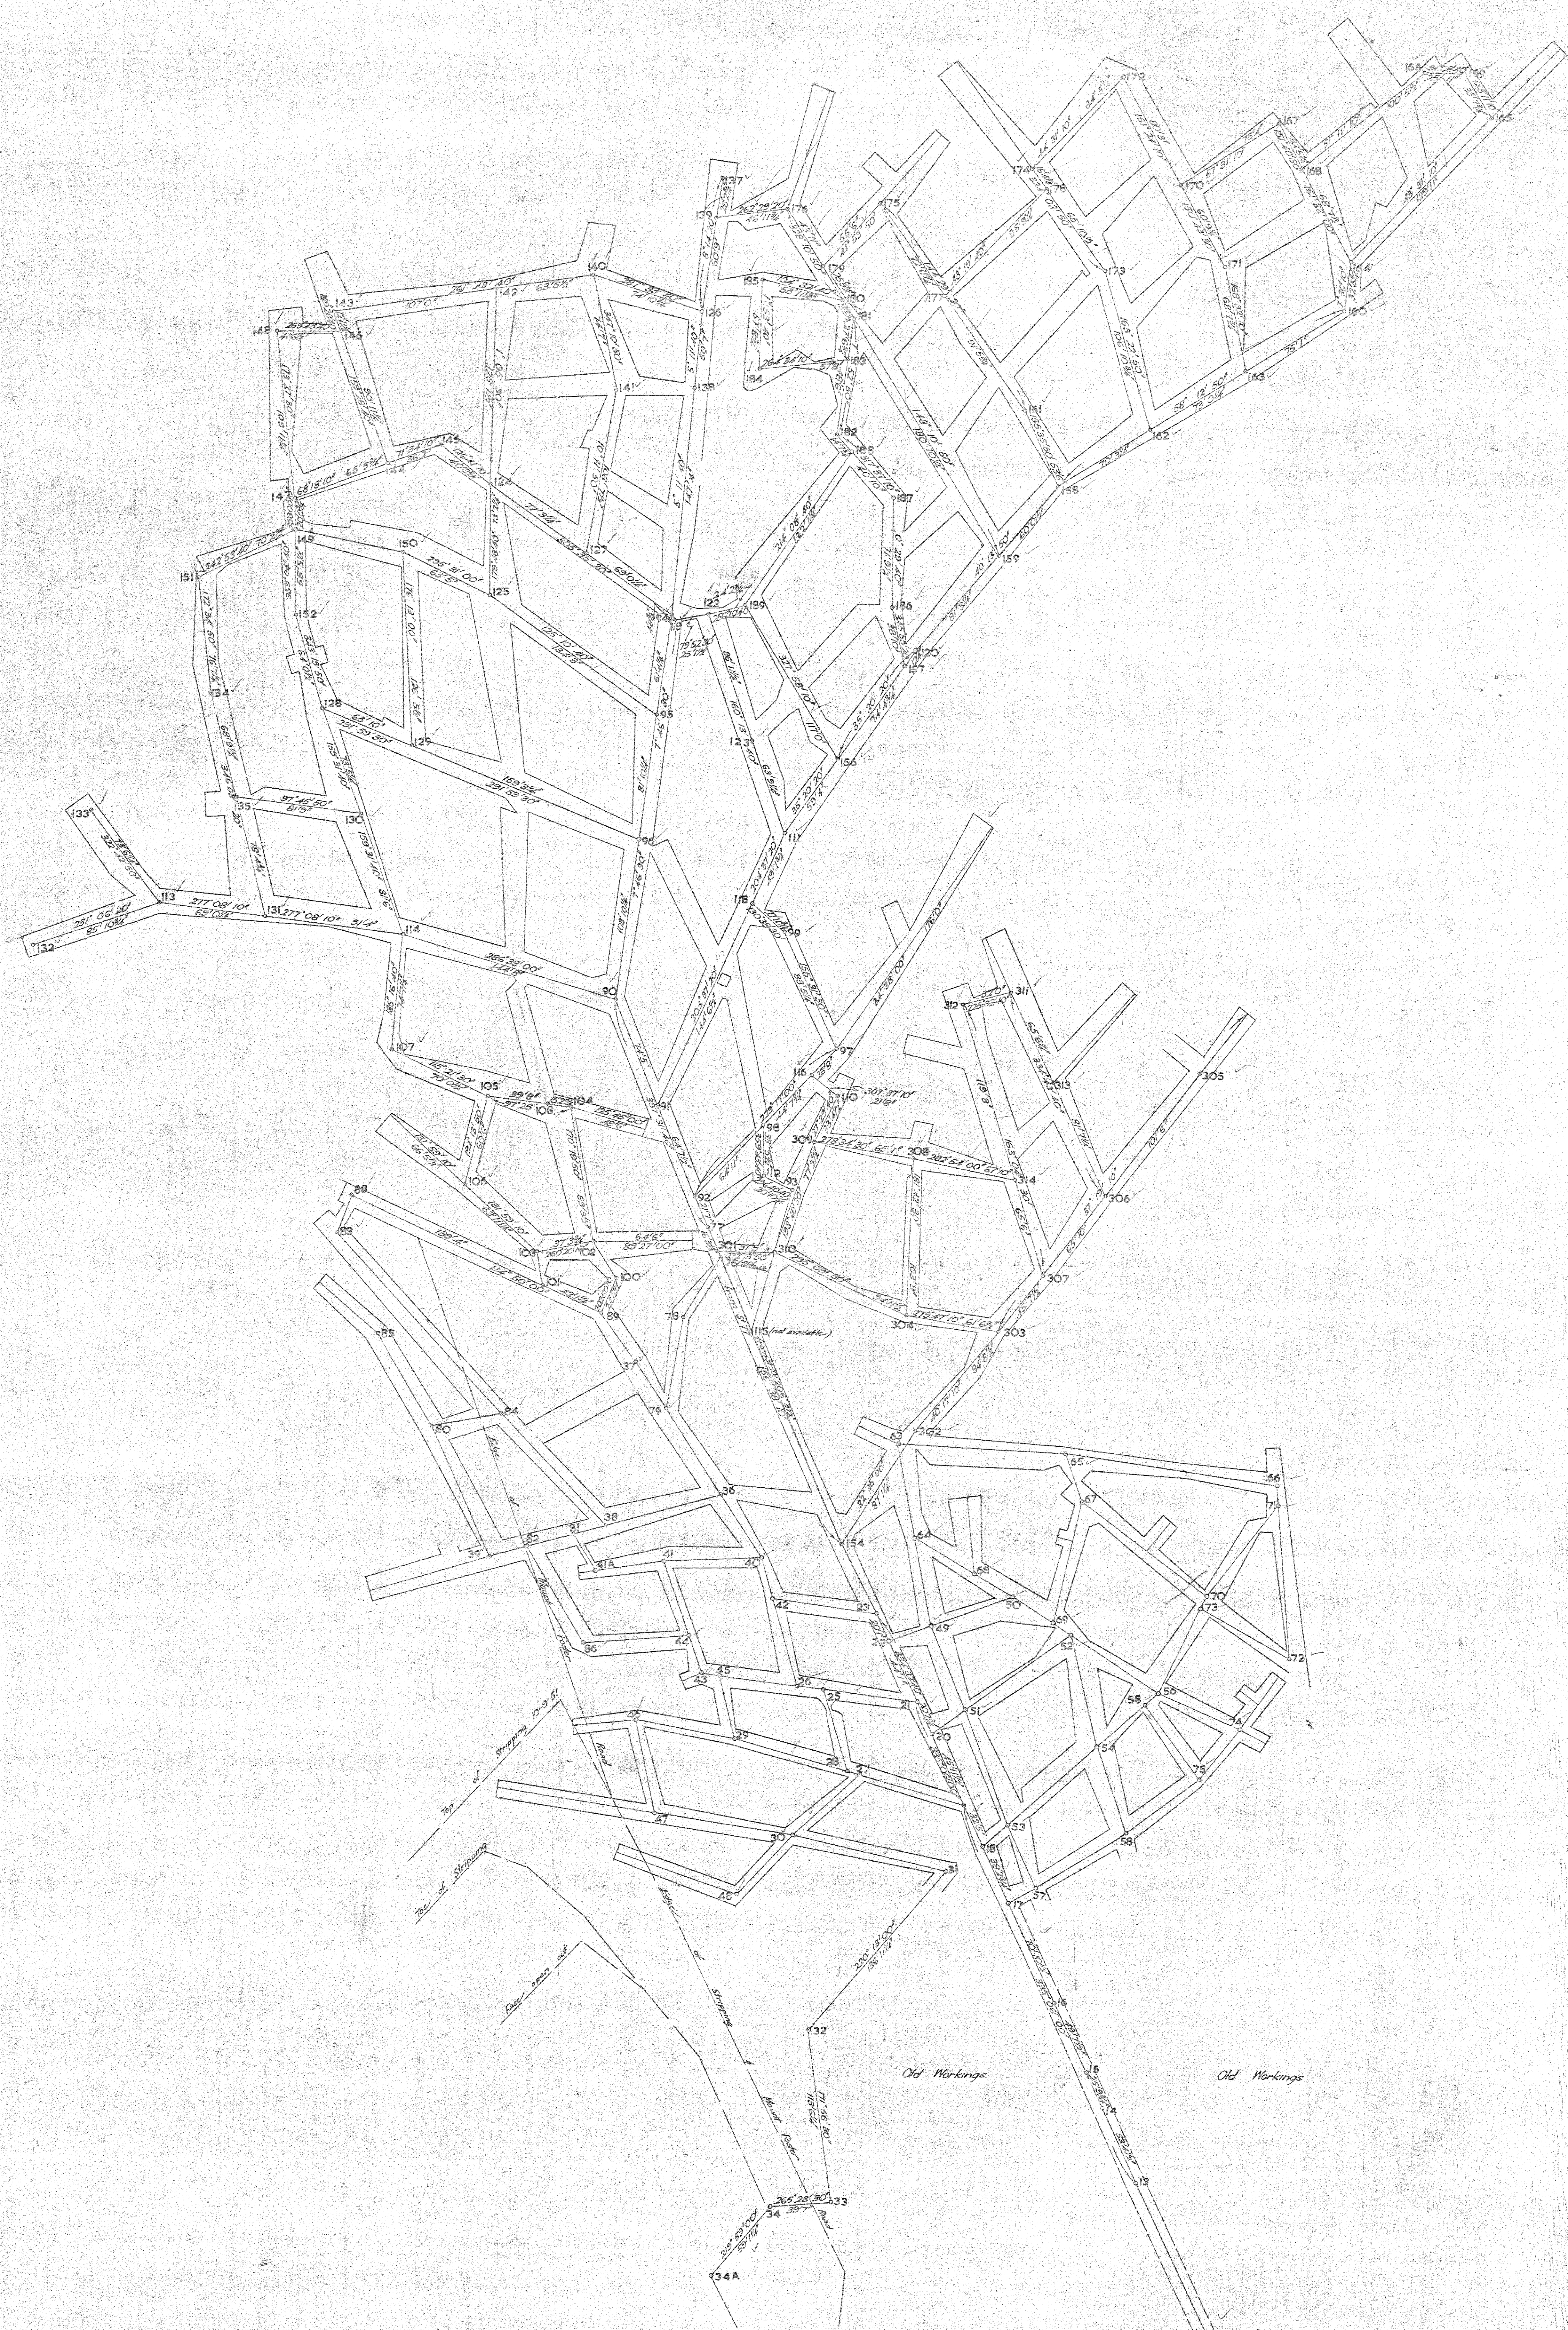

MERRYWOOD COAL MINE

VICINITY OF ST. PAULS

MINING LEASE 33M-44

A. J. NEWMAN & ORS. LESSEES

SCALE 40 FEET TO AN INCH

Office Examination by
26-4-56

Southern

Boundary

1955-56
(to south west corner)
of Lease

for Wyson
Authorised Surveyor
8th November 1954

48-04