


5 cm



MERRYWOOD COAL MINE

0 80 160 240 320 FT.

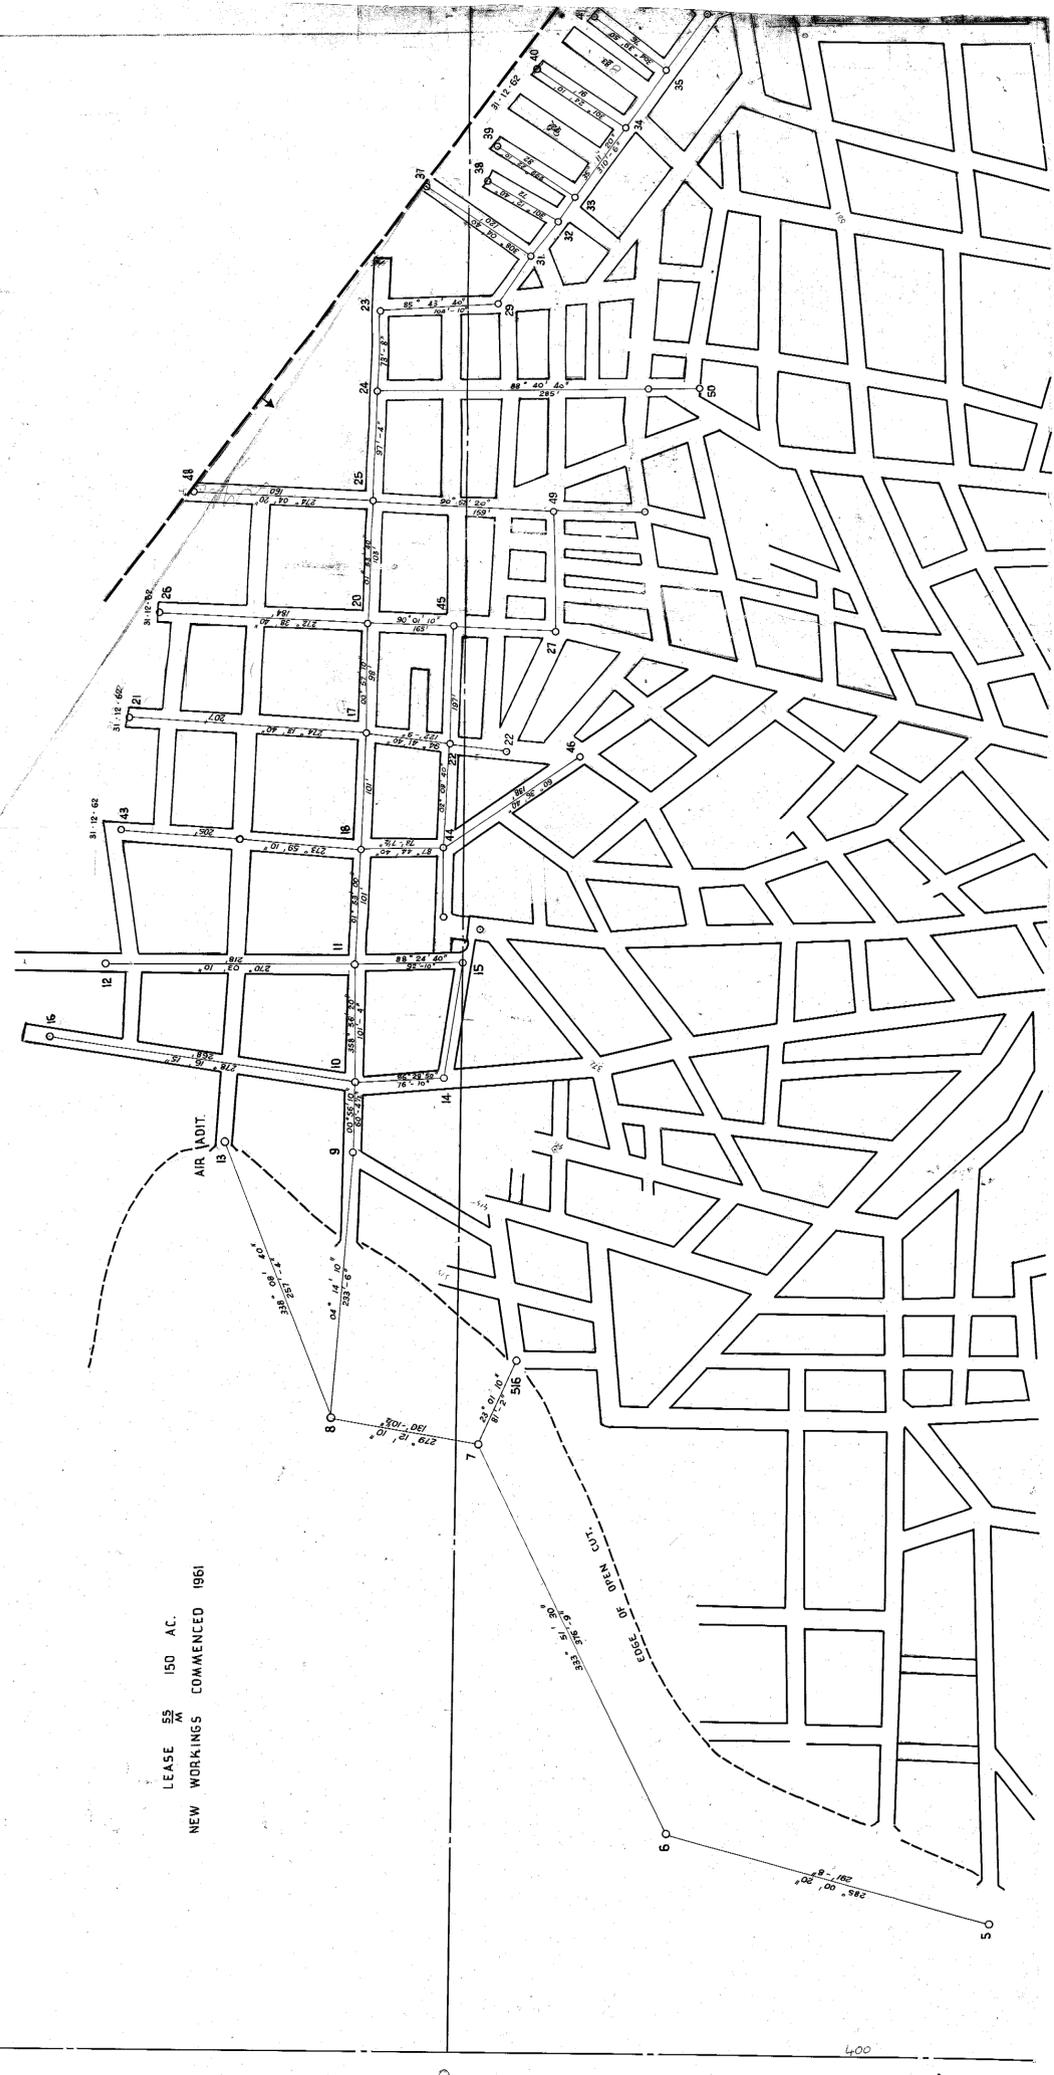

LEASE 53 AC.
NEW WORKINGS COMMENCED 1961

43-09