


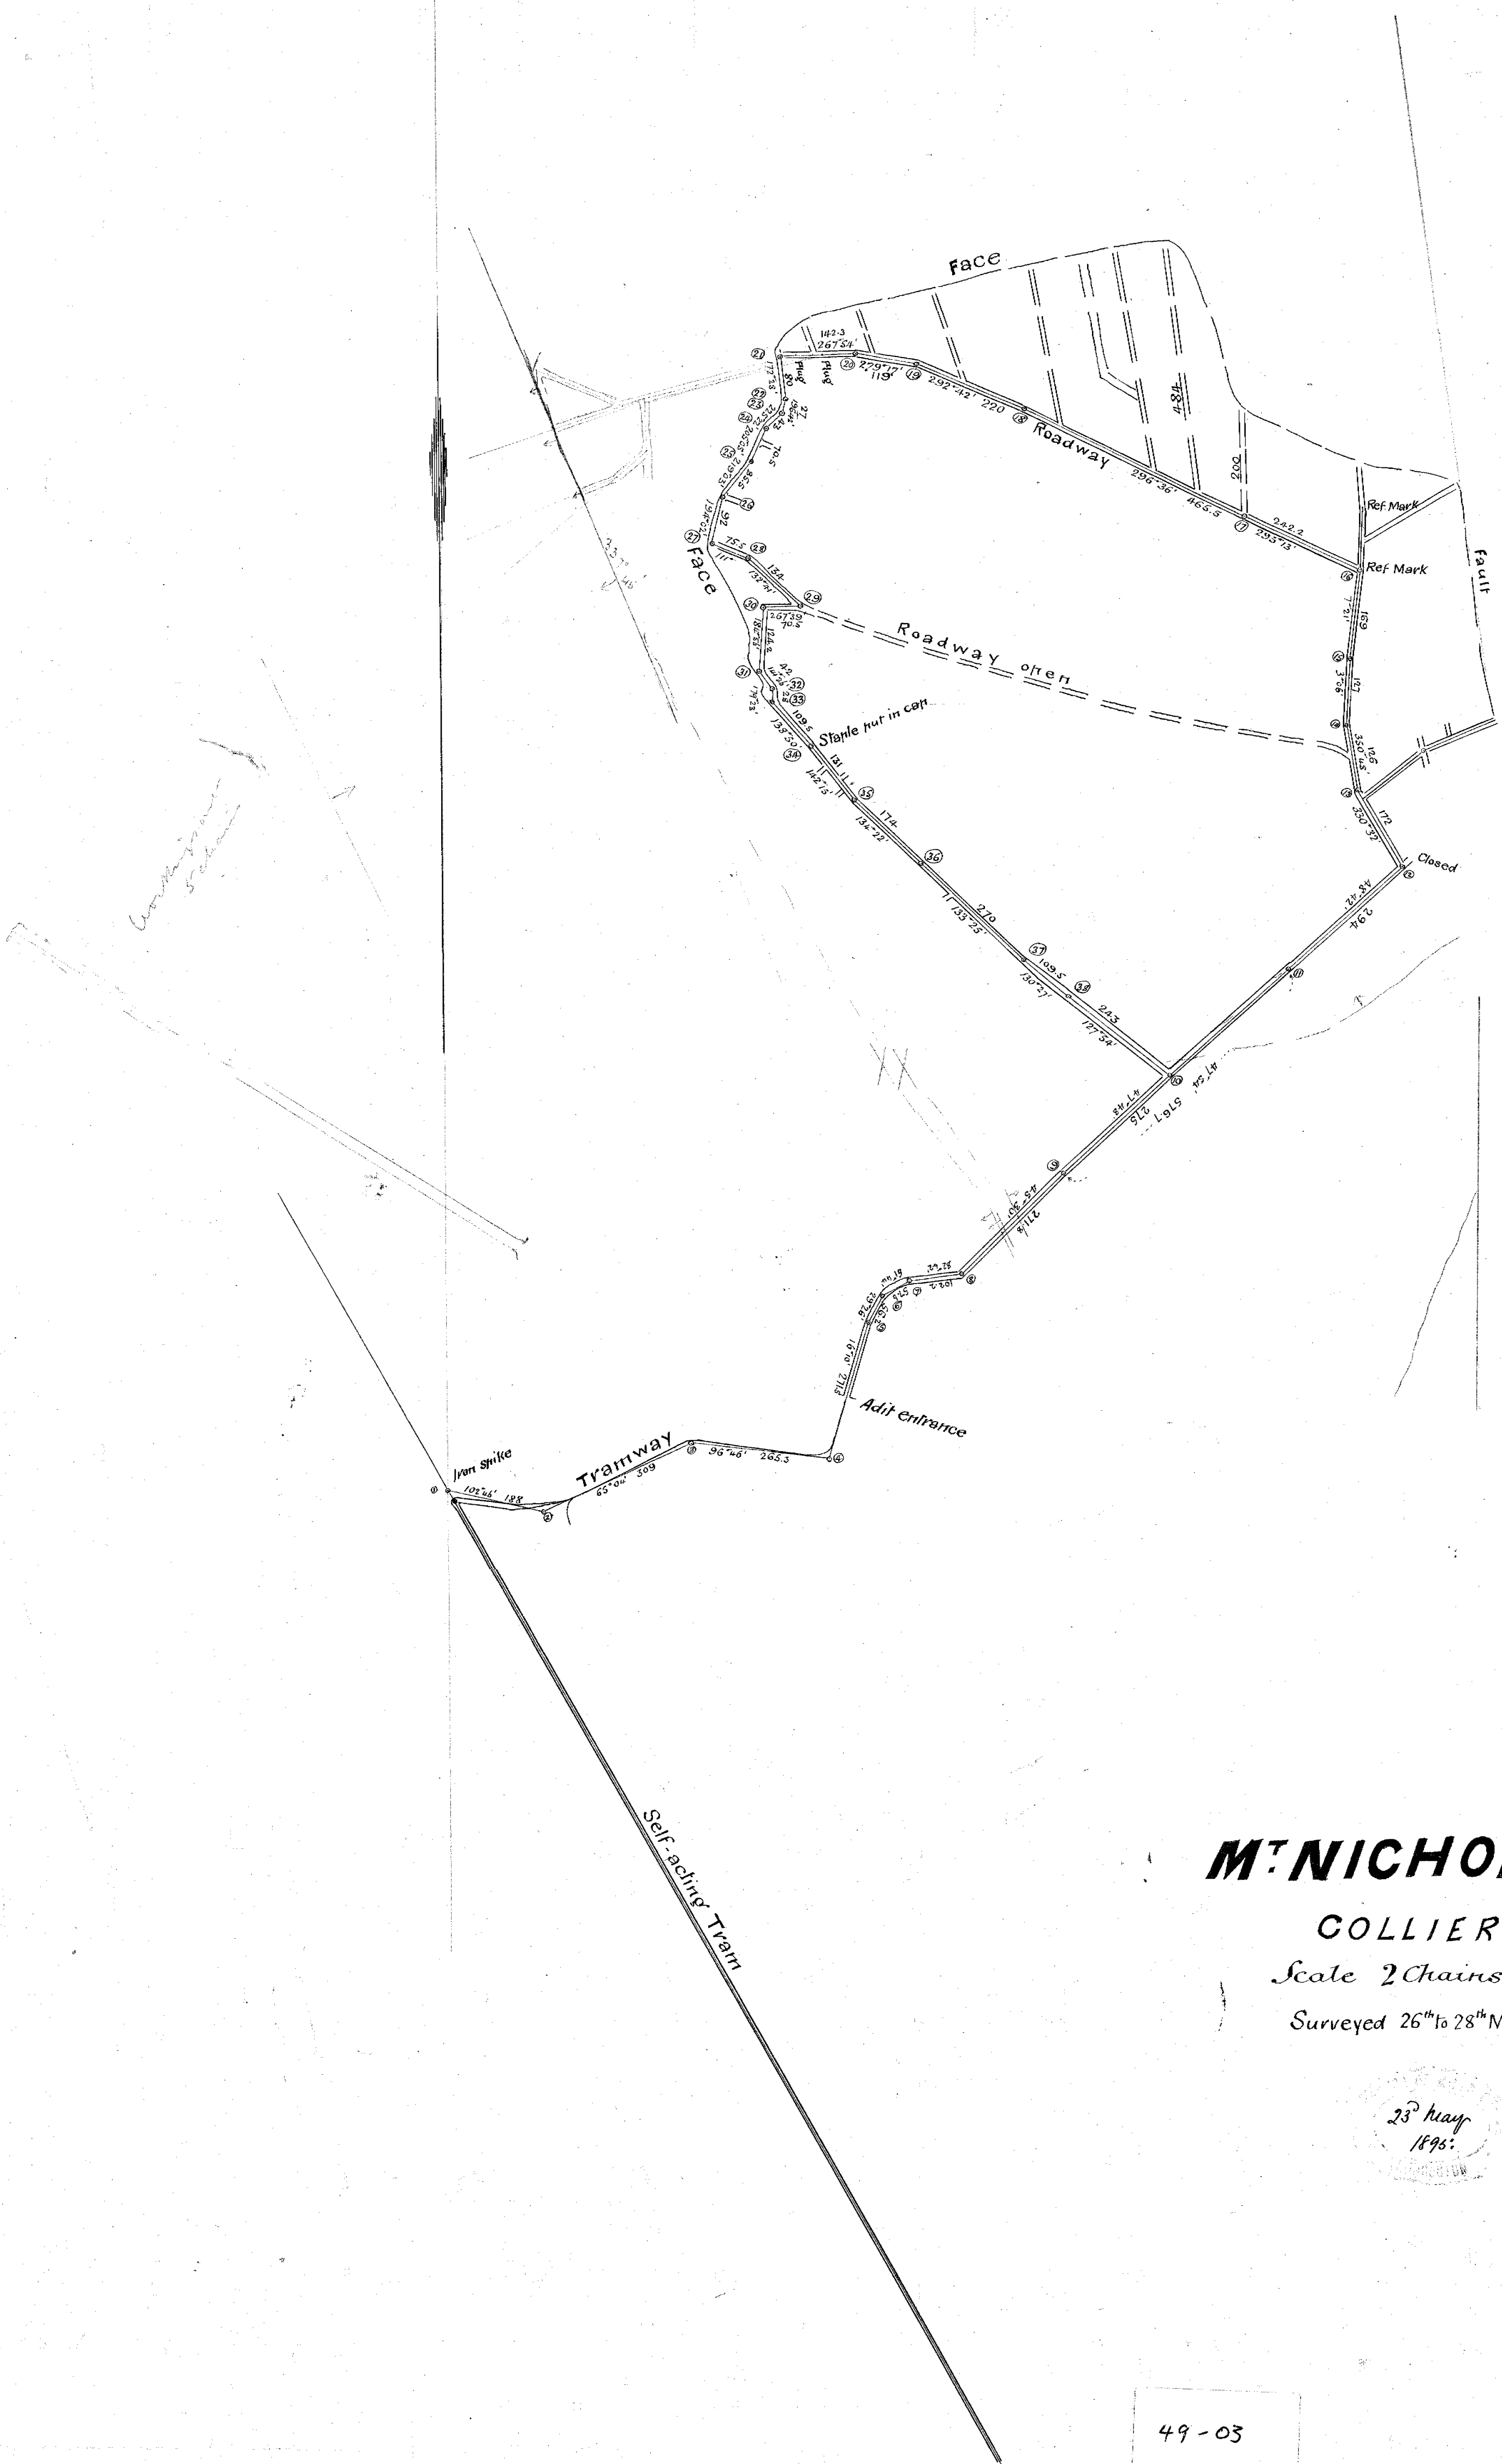

Mt NICHOLAS

COLLIERY

Scale 2 Chains to 1 inch

Surveyed 26th to 28th Mar: 1895

John Laidi
18th May 1895

23rd May
1895