


JUBILEE COAL MINE

PLAN OF WORKINGS

Scale - 40 ft to an inch

Survey made with 4" Transit Theodolite.

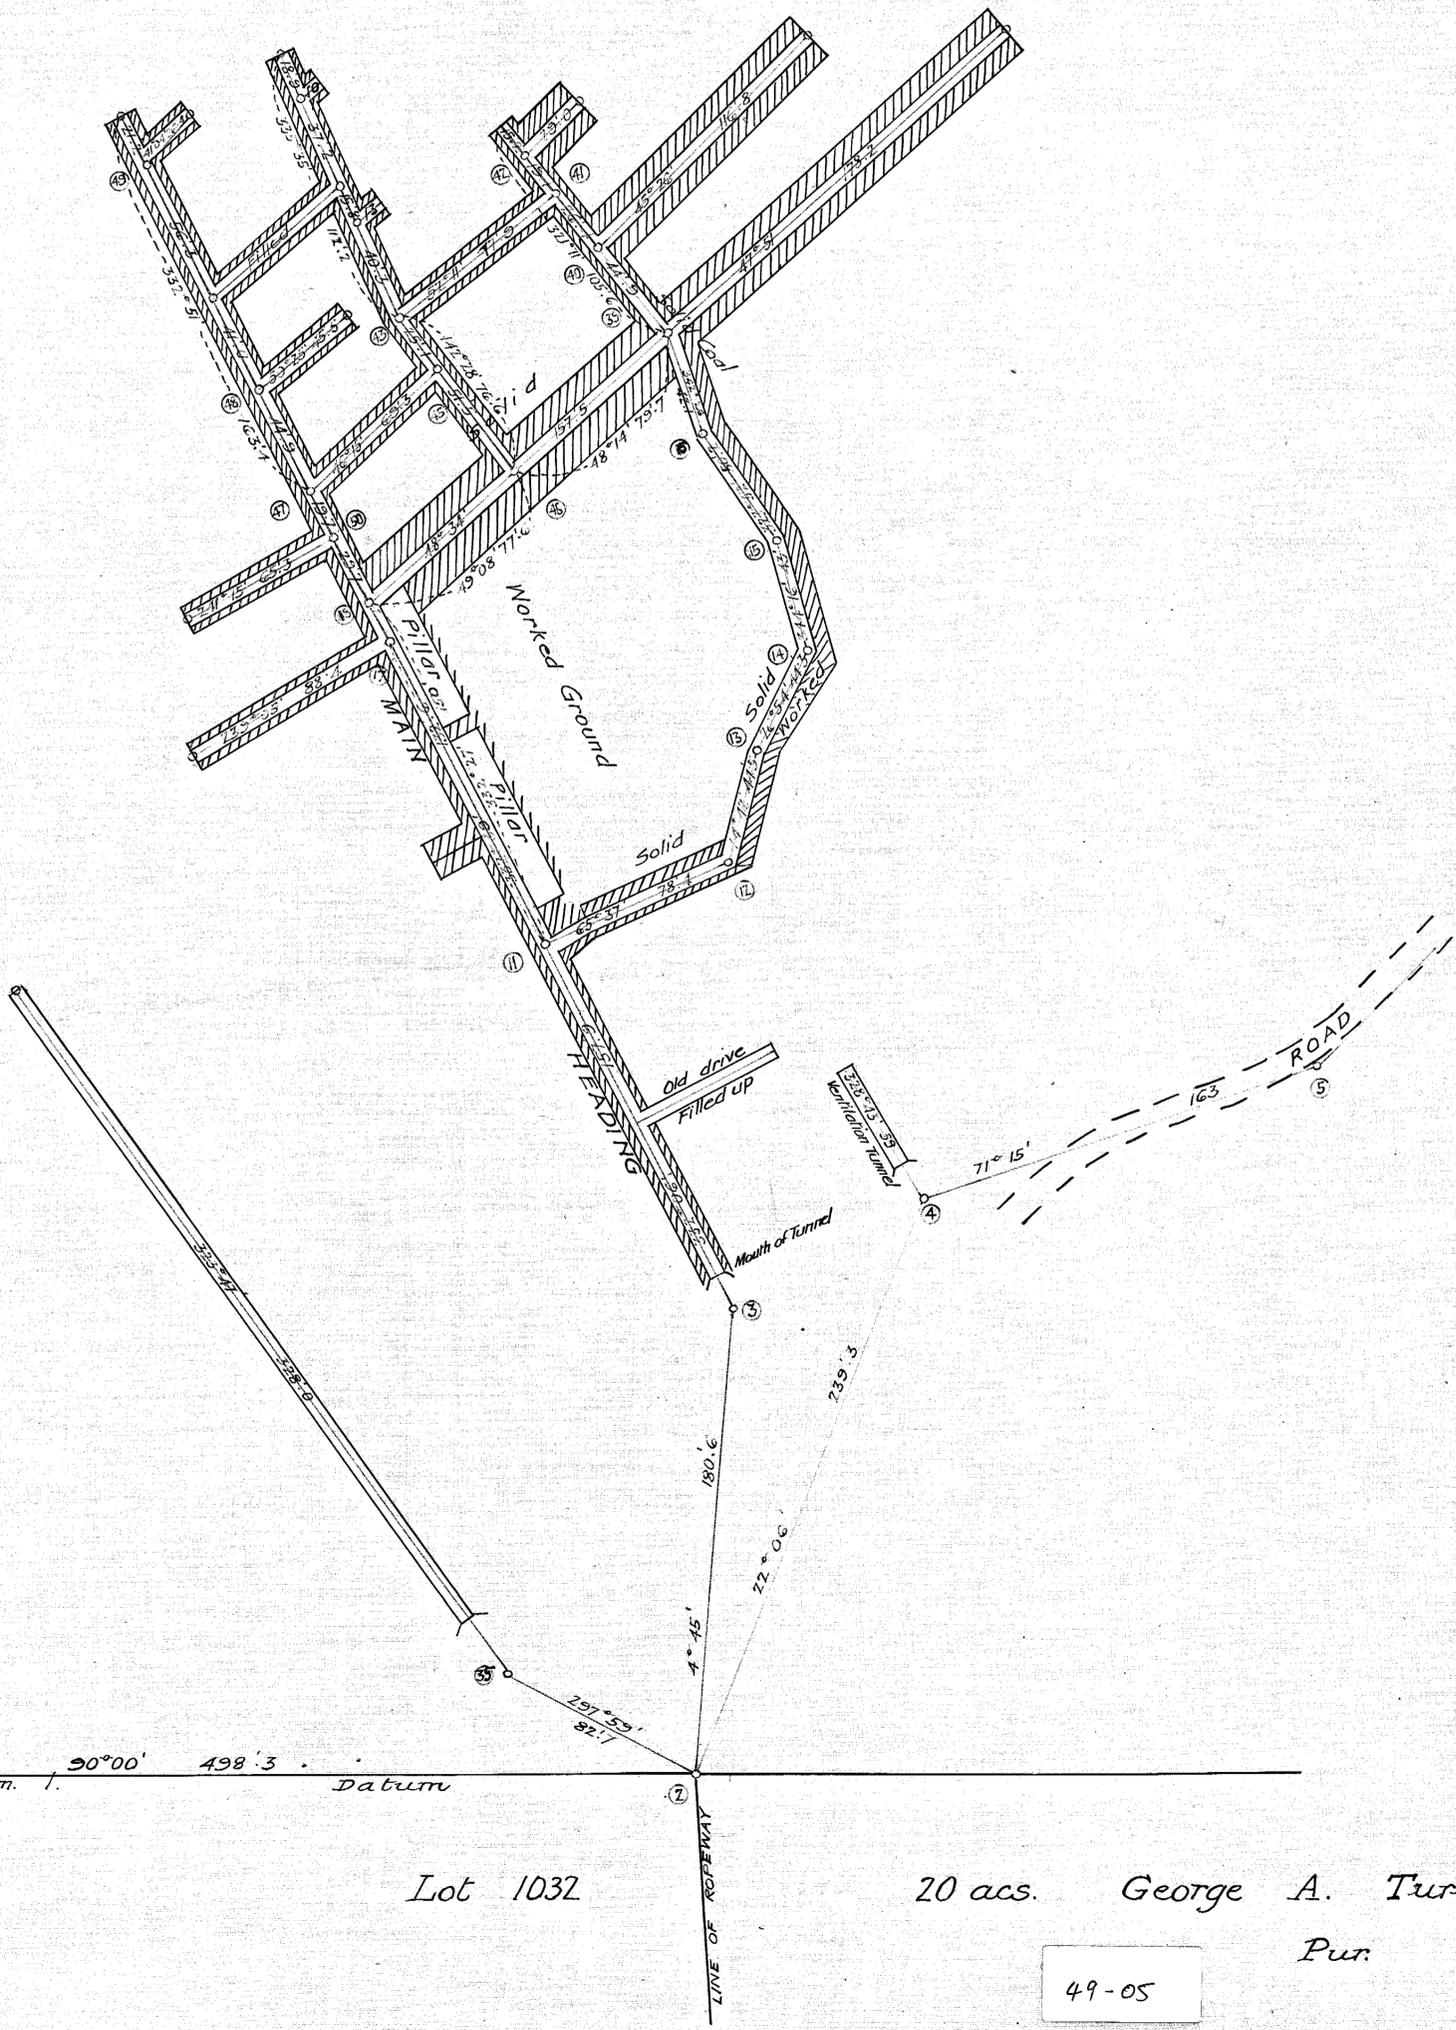

J. Adams
 Authorized Planner
 20/12/24

Lot 1032

20 acs. George A. Turner
Pur.