


CARDIFF COAL MINE

Scale 40ft to 1 inch

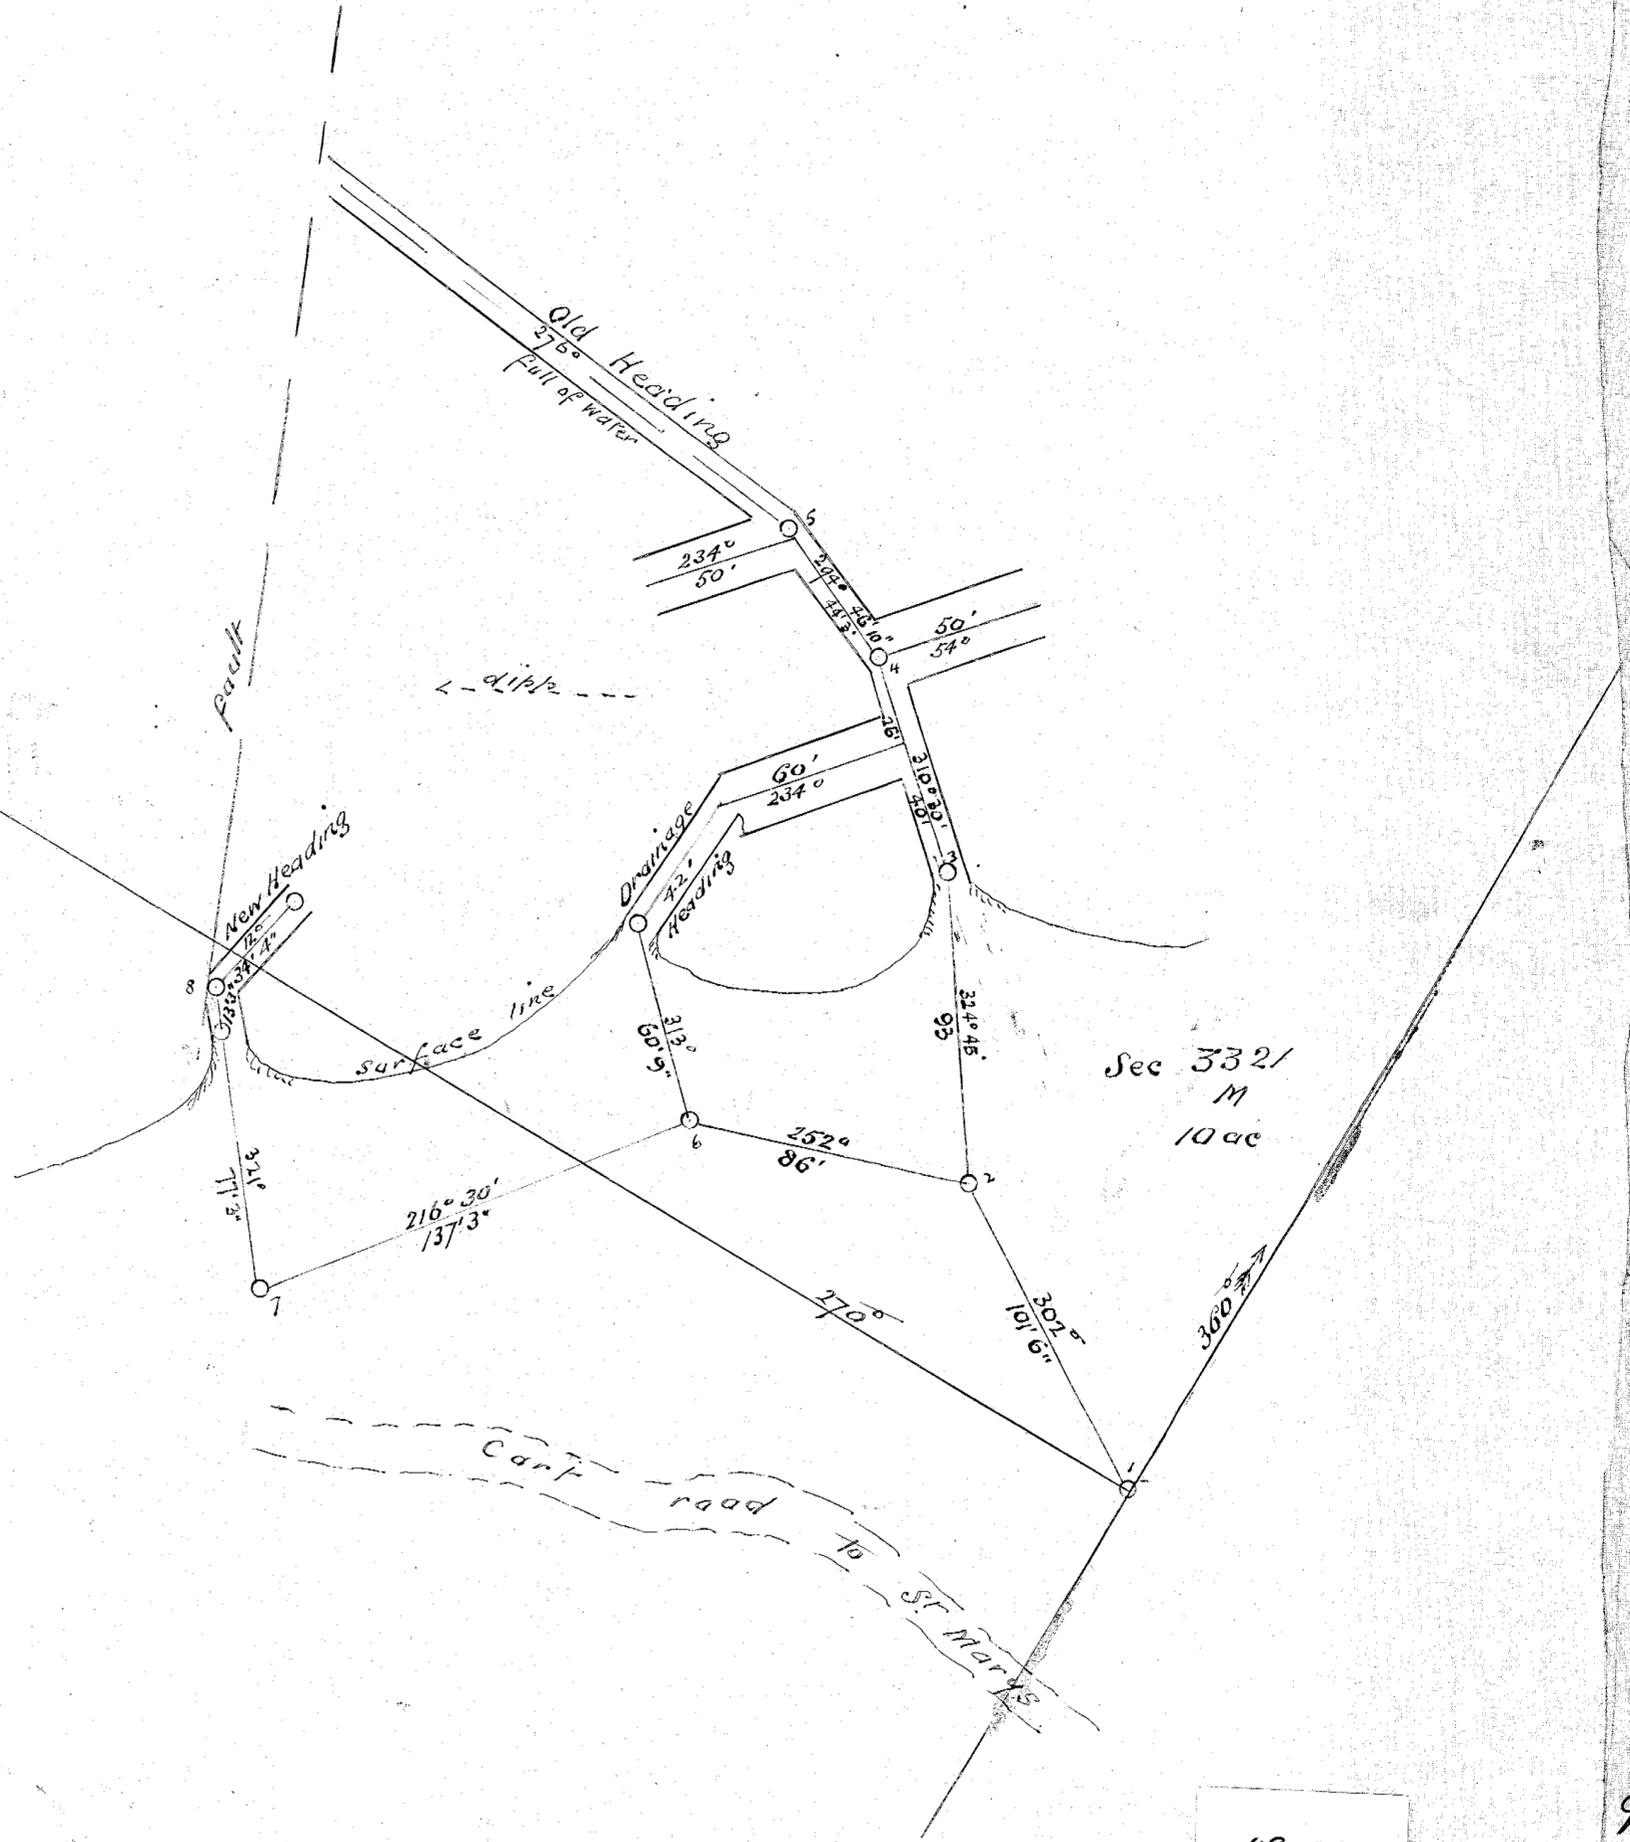

Work done to July 1916
 C. Binley Waterman
 Auth. Surveyor
 Survey with Compass