


200 BIRCH CO. 3/20/32

5 cm

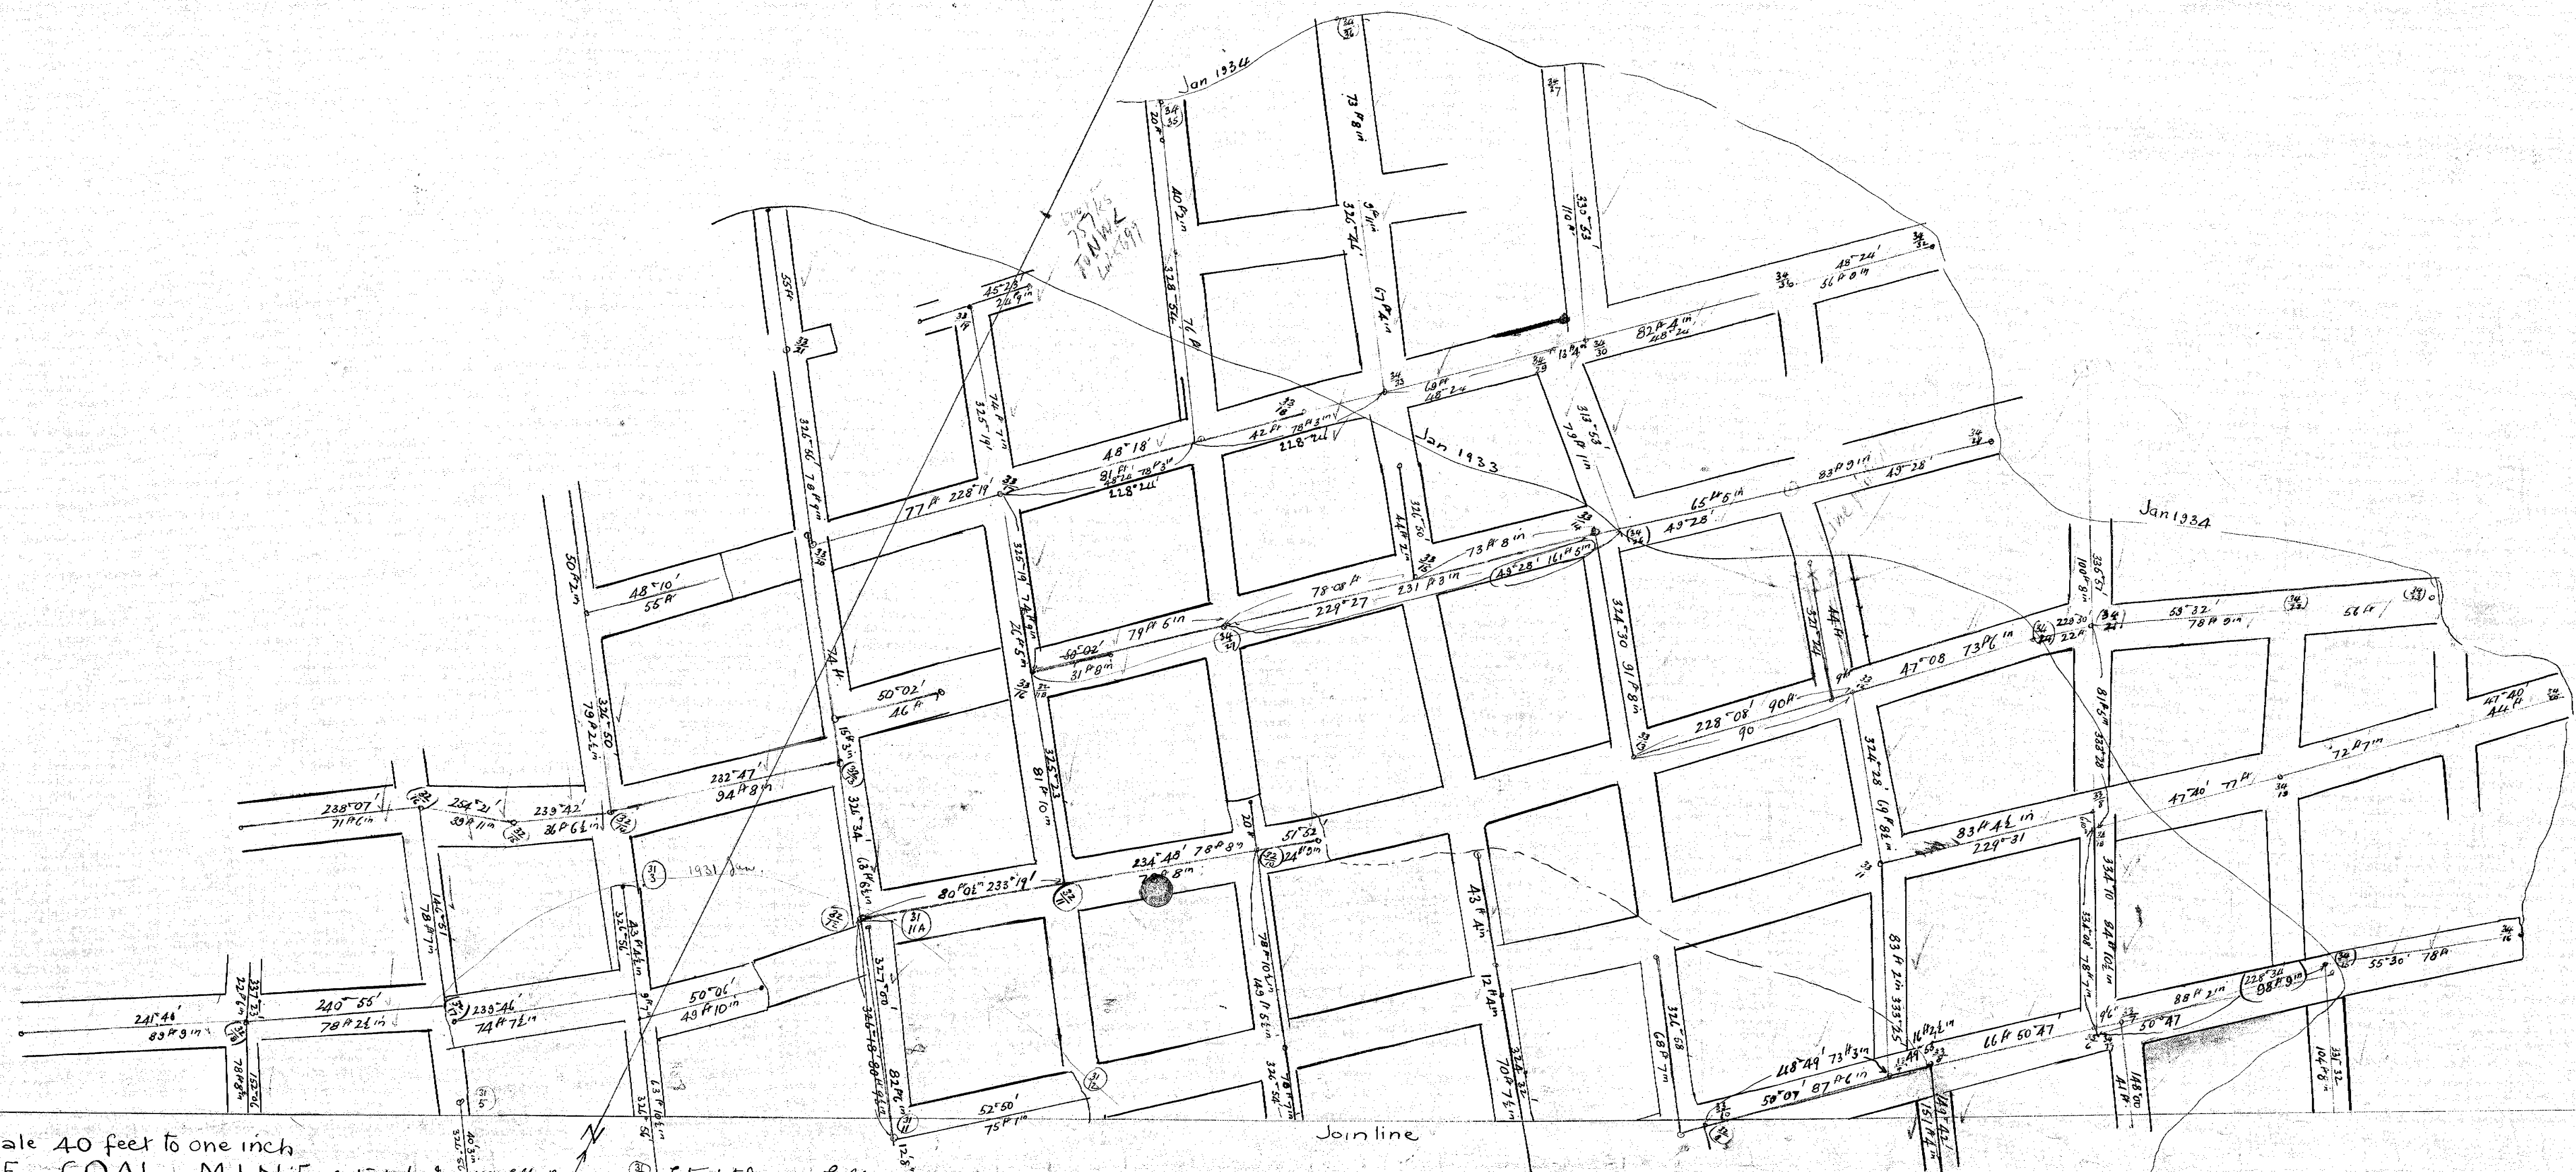

49-09

E. J. Blackwood
Jan 1932