


10662
M
Jubilee Coal Mining Co: No L
M L
(61)

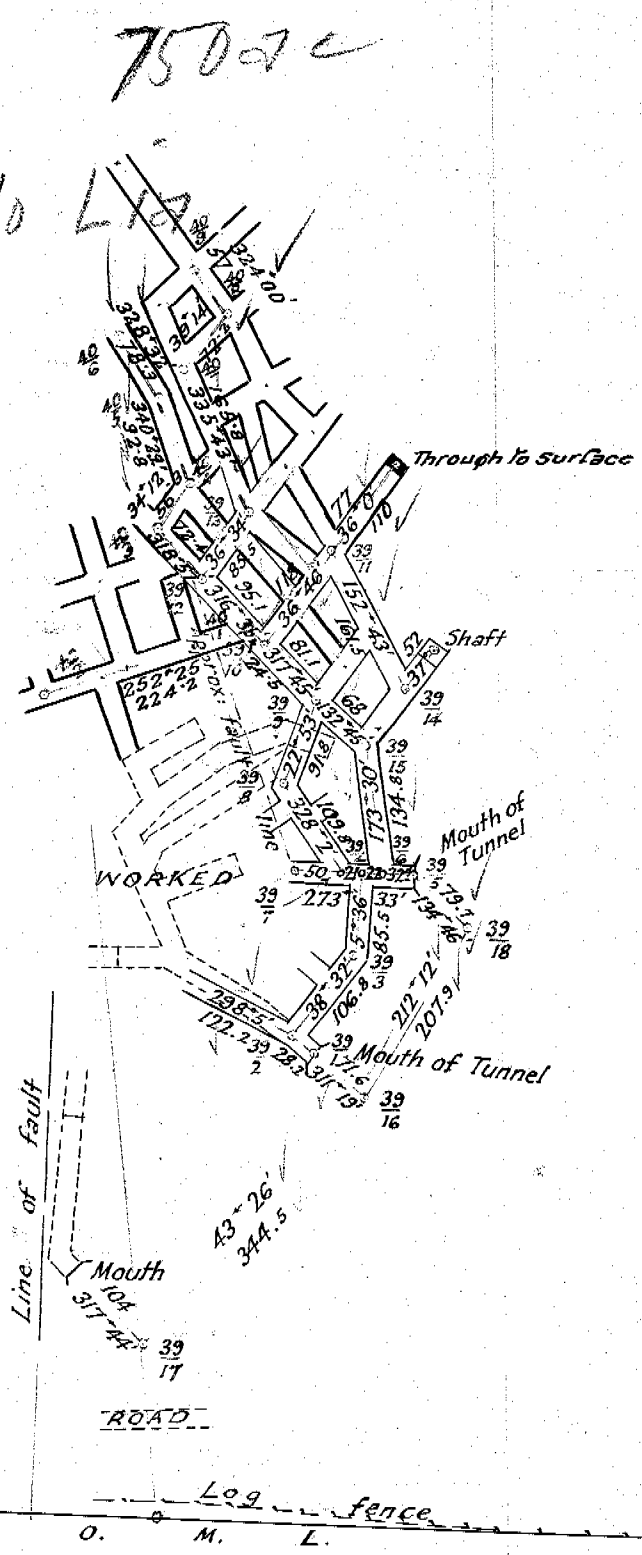

Approx. Position only

CARDIFF WORKINGS

Scale 2 chains to an inch.

Exd. Ato
7/3/39
AKO 25/1/40

Exp. Blackwood
Ant's Surveyor
Jan 1839.
(old survey by Ch. Adams)
31. m. limit road.
J. W. H. Weaver
Ant's Surveyor
Jan 1940

Lot 5699 A 39 - 1 - 11
Stephen Harvey Pur