


111111  
HUNTSMANS  
MINE CAP

SOUTH  
SISTEE

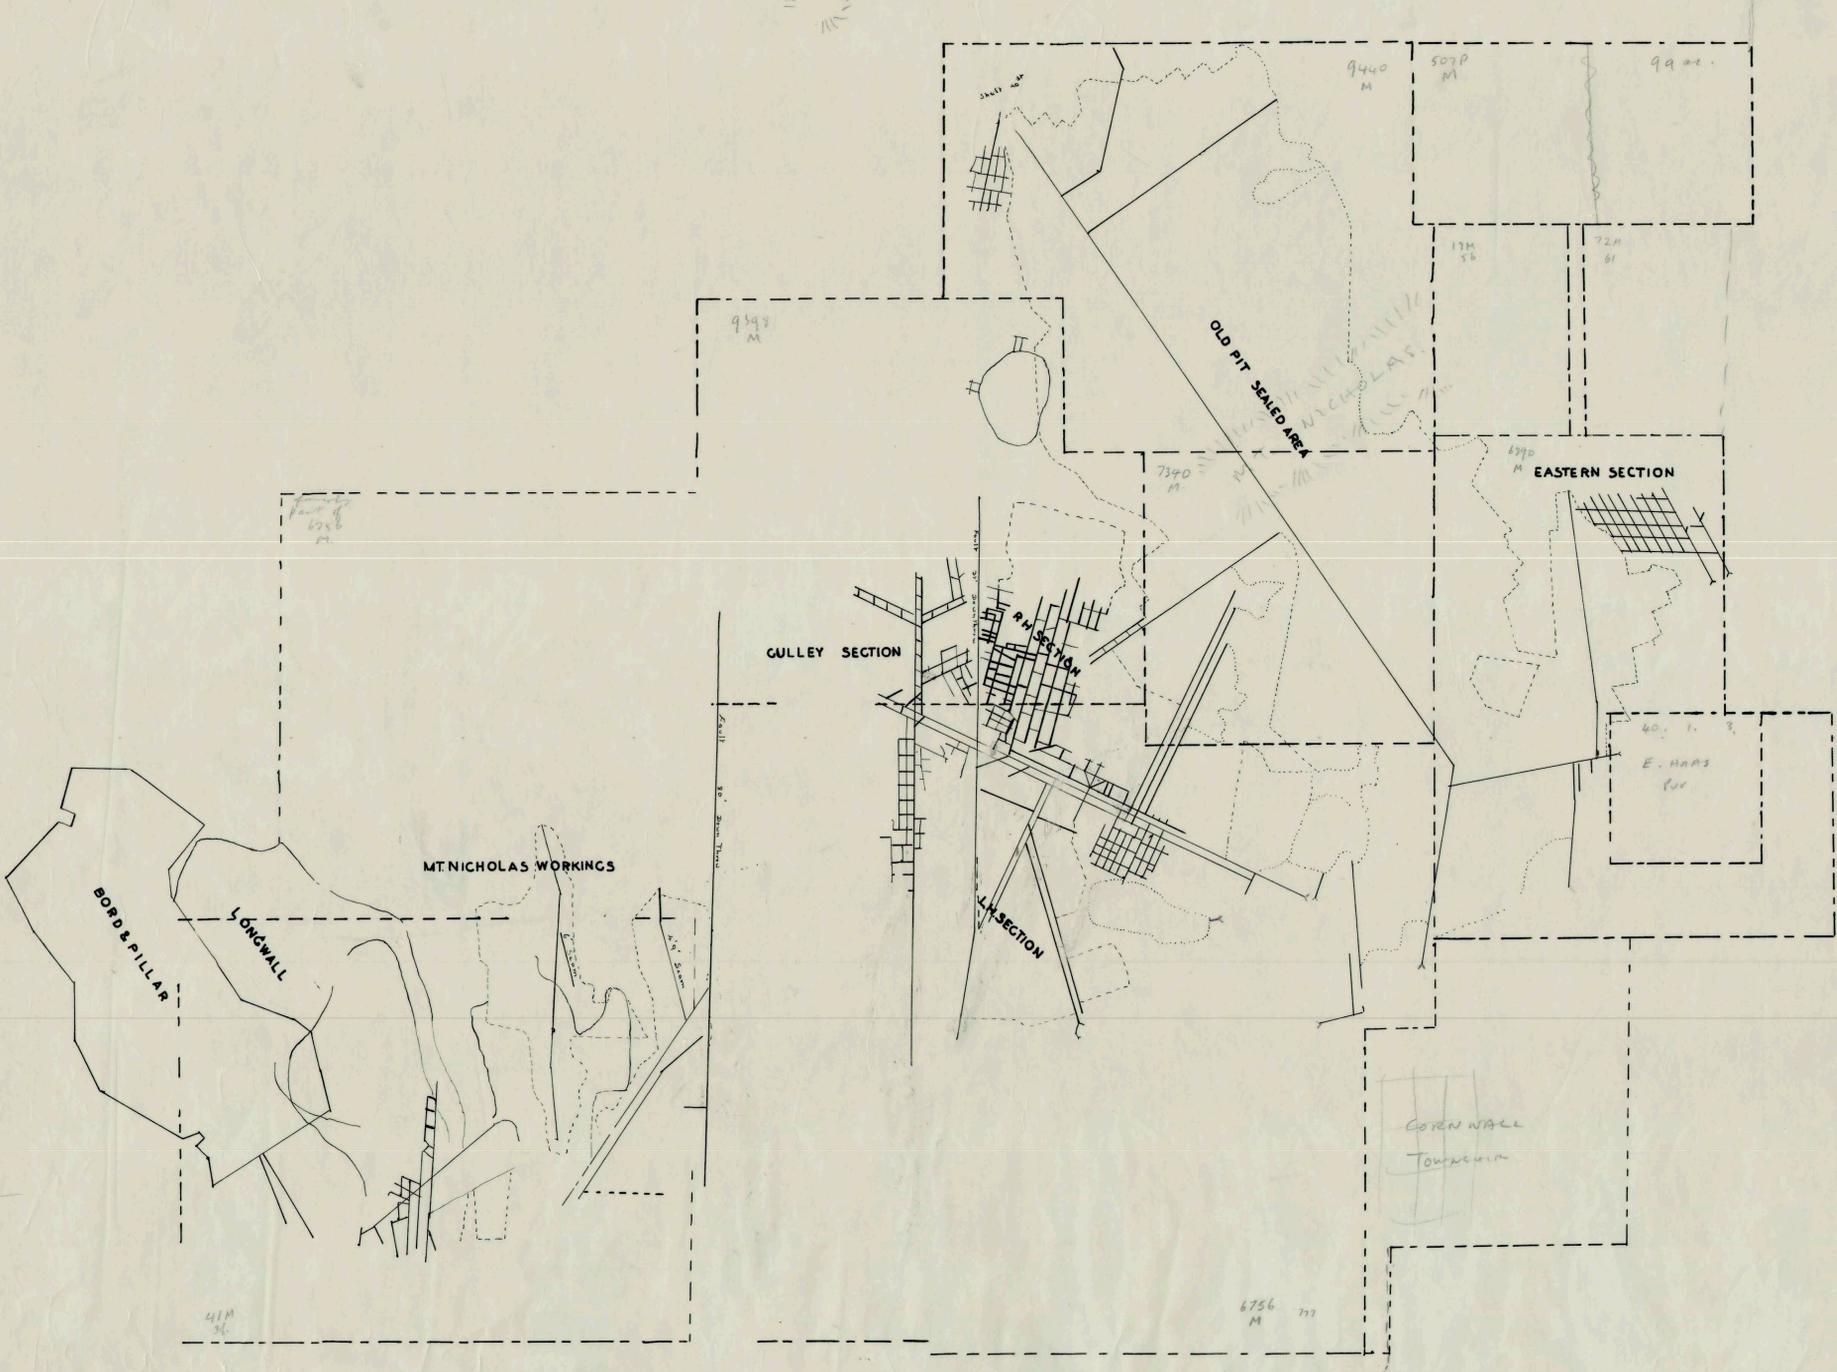

**THE CORNWALL COAL CO. N. L.**

SCALE 10 CHAINS TO AN INCH

