

PLAN OF UNDERGROUND SURVEY

RINGAROOMA UNITED GOLD MINING COMPANY

NO LIABILITY

ALBERTON

Scale 40 feet to an inch.

Survey made with 5 inch transit theodolite.

Donald Fraser
Auth. & Surveyor
26th October 1923

1551
G

10ac

1260
G

20ac

J. W. Mitchell

G. L.

0.039'
332' 41"

263° 26'

1443
G

10ac


Ringarooma United Gold Mining Company N. L.

HANNAH'S
TUNNEL

G. L.

J. W. Mitchell

G. L.

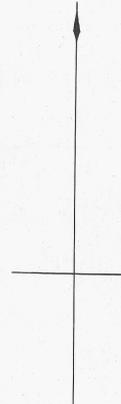

Scale bar with 50m markings

Ringarooma United Gold Mining Company

Handwritten signature and date