

RINGAROOMA UNITED GOLD MINING COMPANY NO LIA

North Mount Victoria

SECTION OF MAIN TUNNEL

Scale Forty Feet to One Inch

Donald Fraser
Auth^g Surveyor
29th February 1924

1590
G

8

1551
G

10

1260
G

20

J. C. Matthews


J. W. Mitchell

J. W. Mitchell

G.L.

G.L.

G.L.

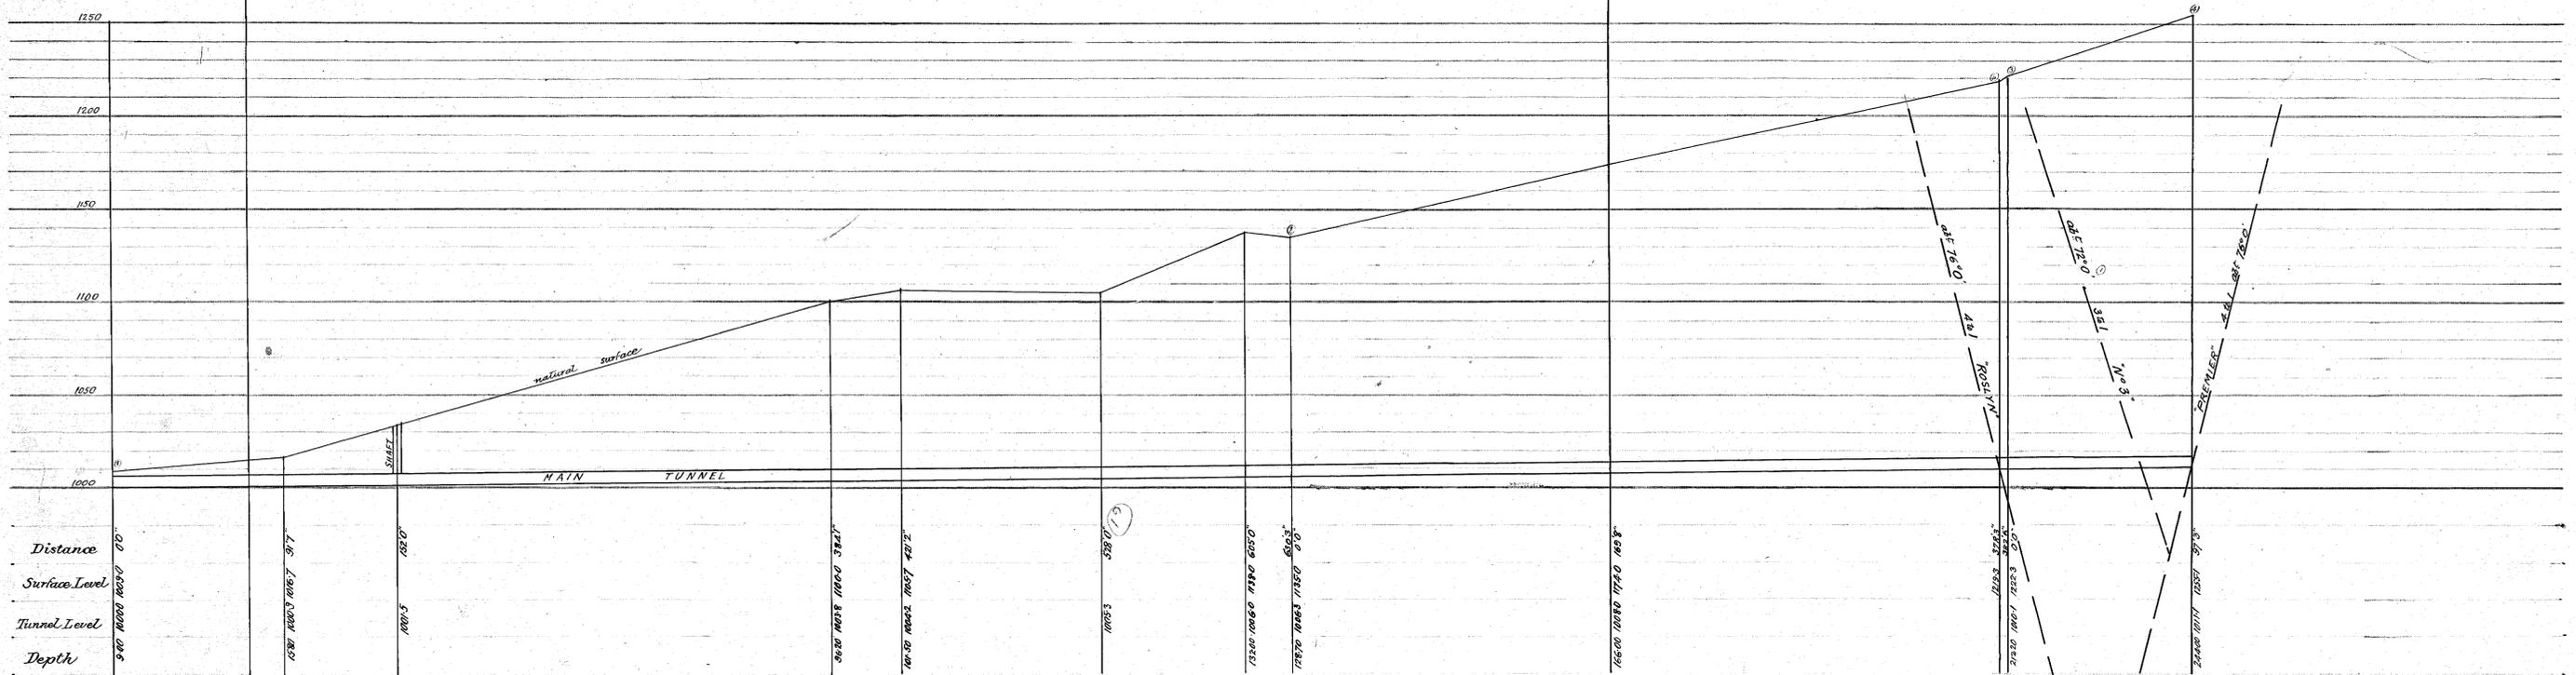

Probable Junction about 200 feet below Tunnel

