
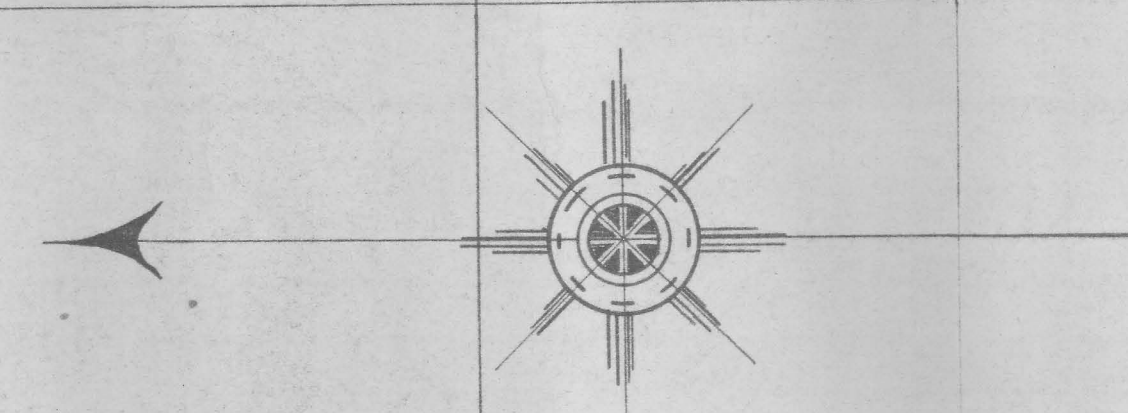


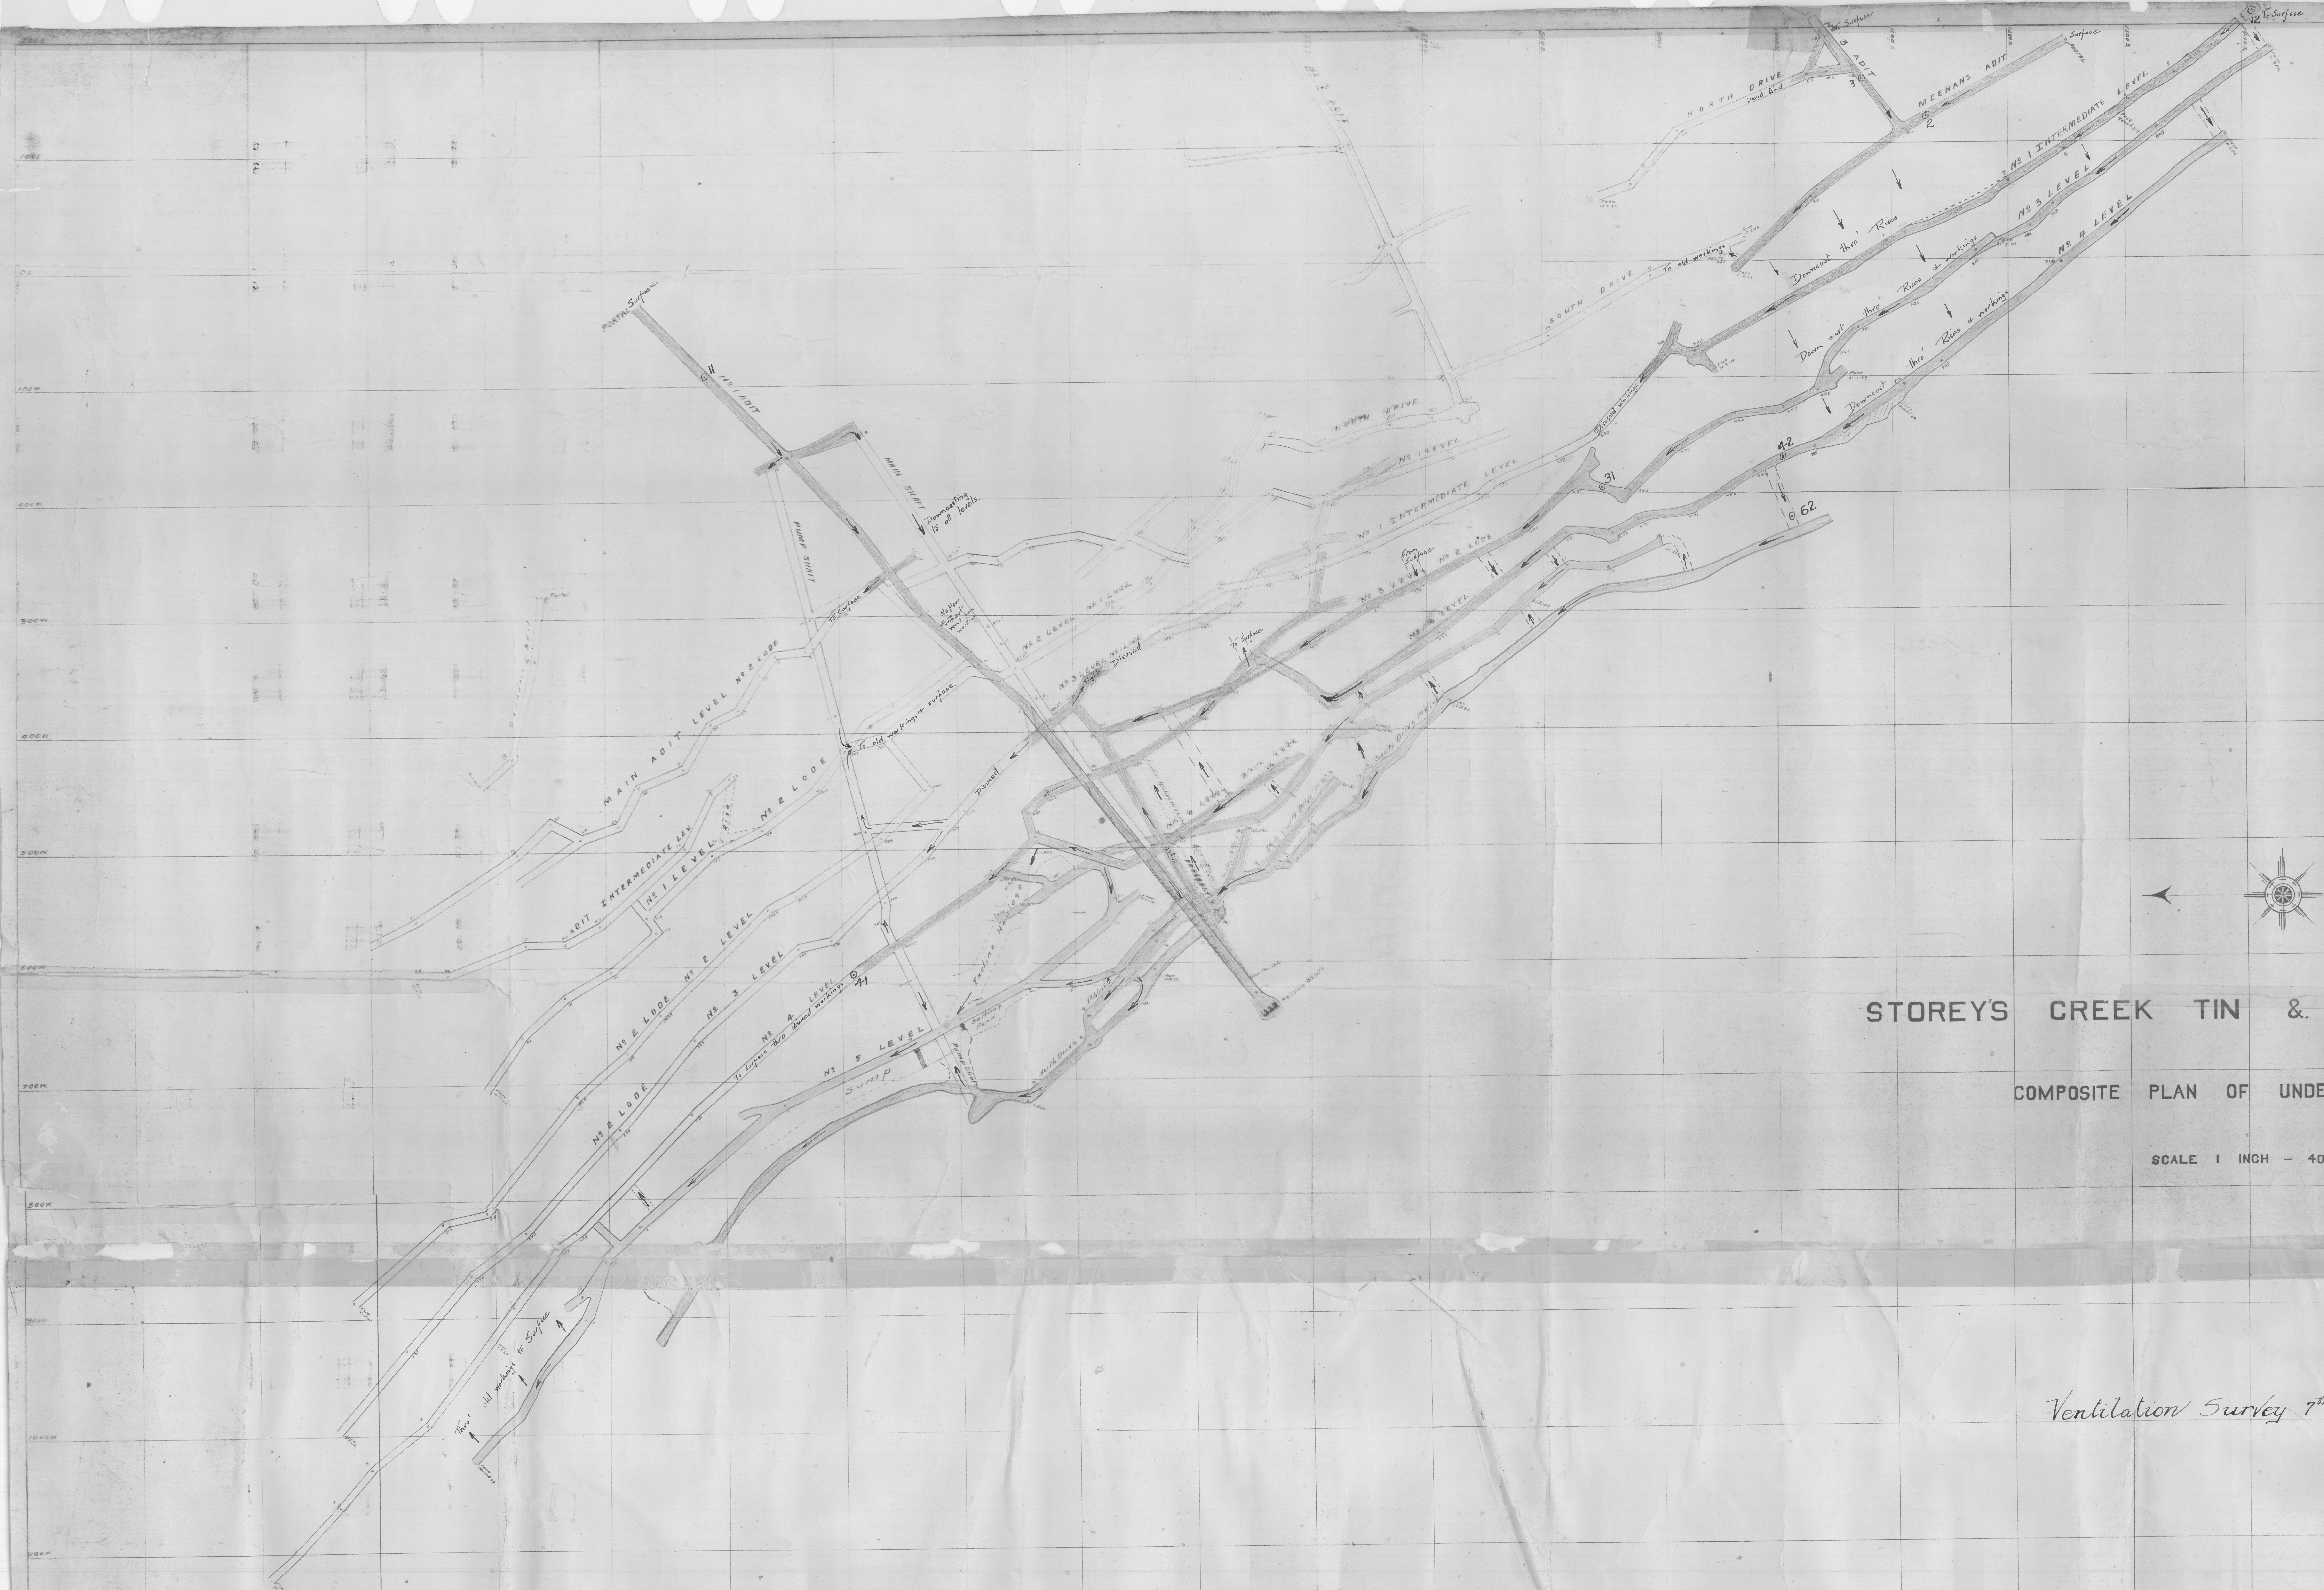


STOREY'S CREEK TIN & WOLFRAM MINE N.L.

COMPOSITE PLAN OF UNDERGROUND WORKINGS.

SCALE 1 INCH = 40 FEET.

Ventilation Survey 7th + 8th July 1953

Handwritten signature and date:
J.T. Harnsey
12.8.53

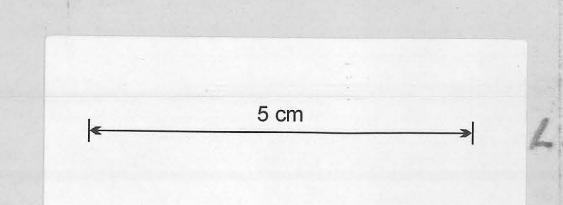

Surveys to 1942 L.F. Egors.
Later Surveys by J.T. Harnsey.
Plotted by J.T. Harnsey.
12.8.53

52-01