


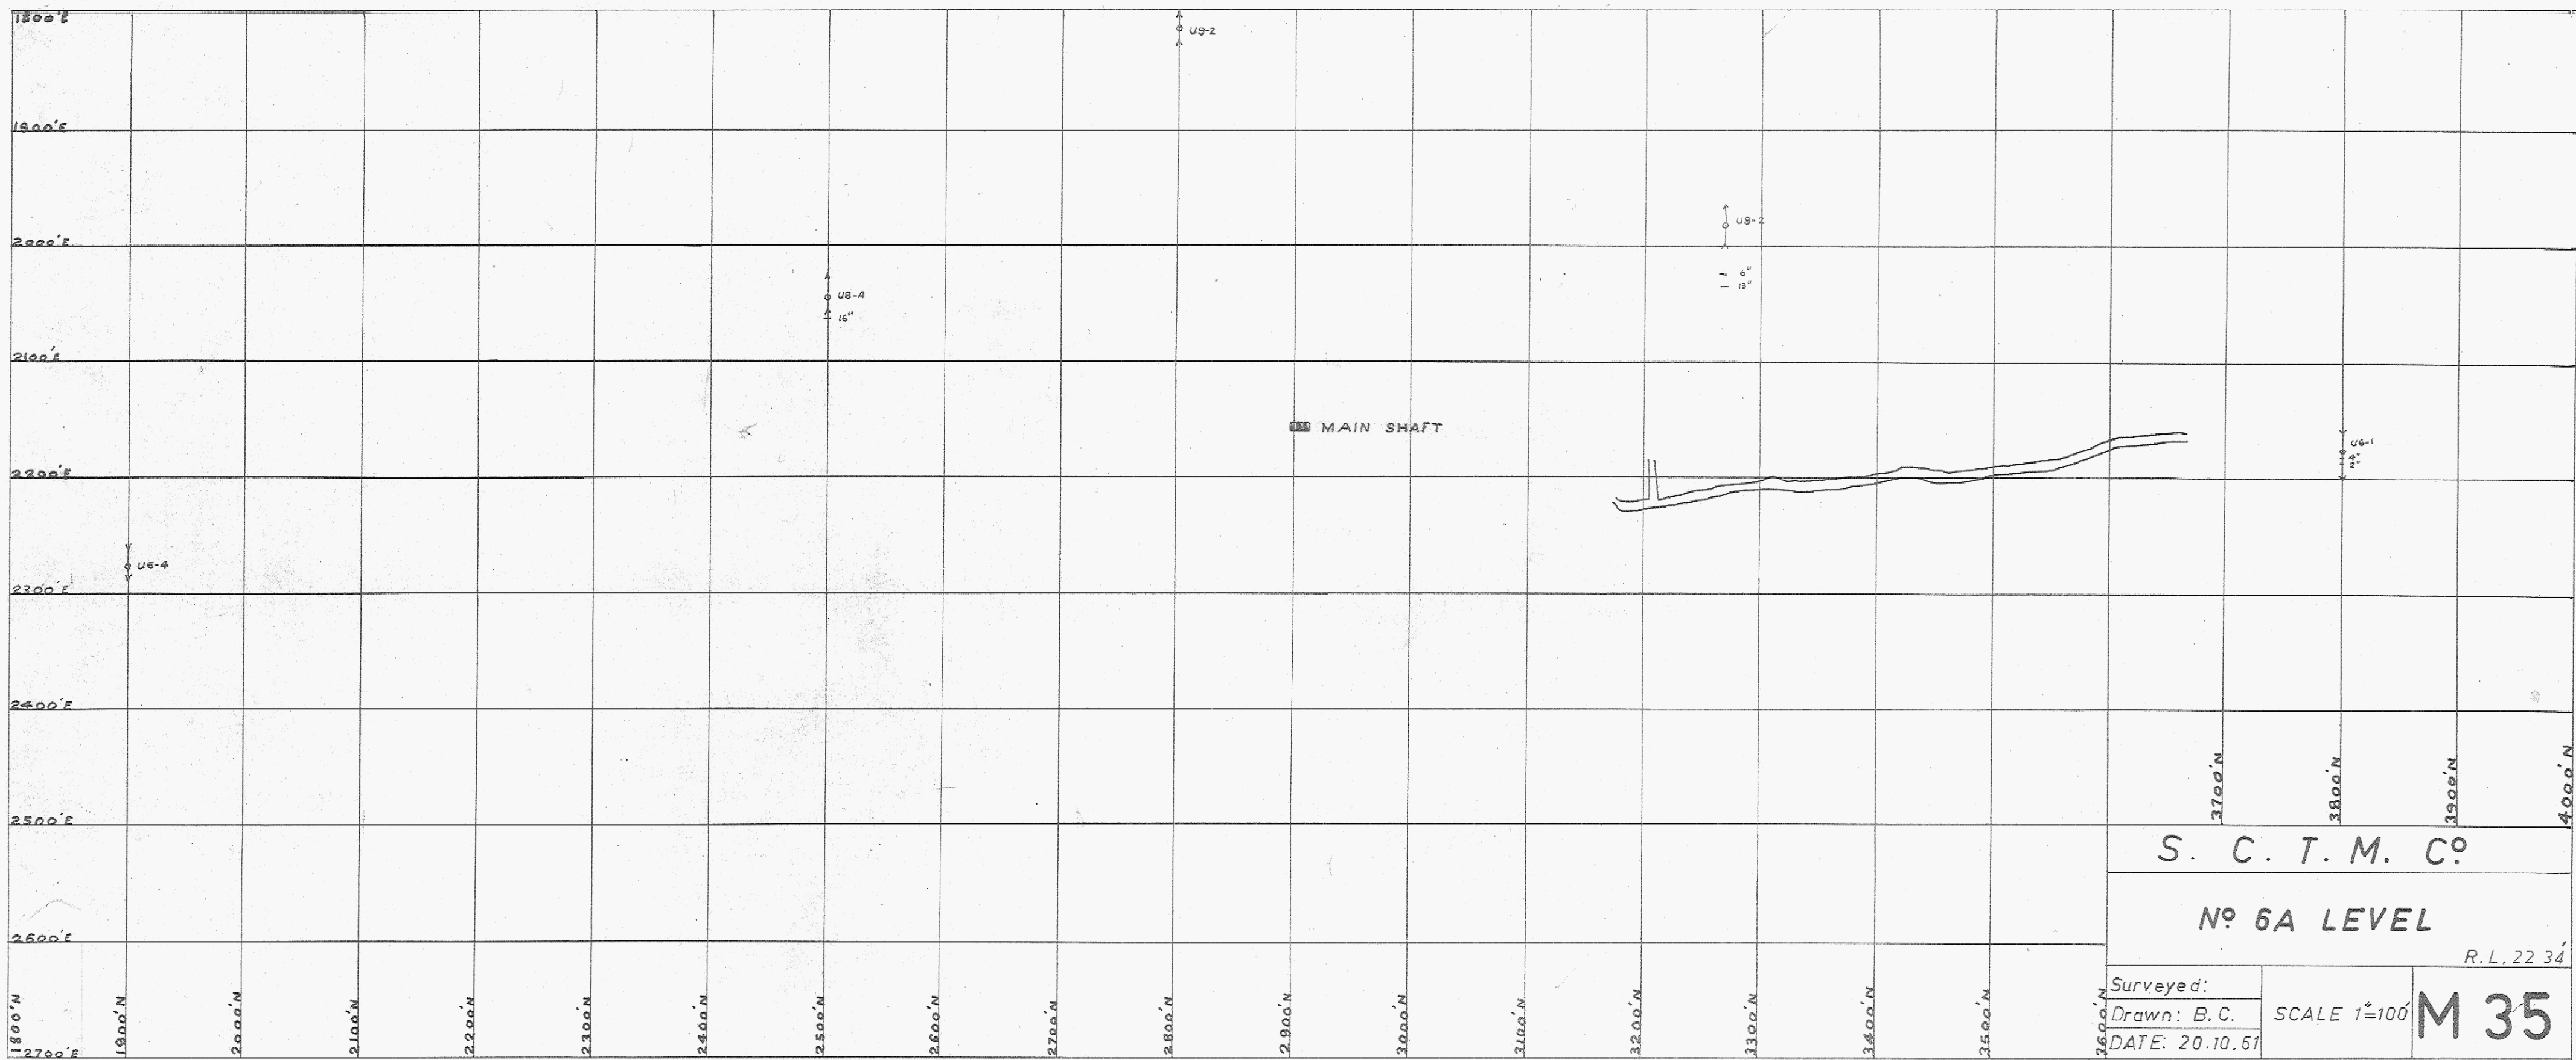

S. C. T. M. Cº

Nº 6A LEVEL

R.L. 22 34'

Surveyed:
Drawn: B. C.
DATE: 20.10.51

SCALE 1"=100'

M 35