


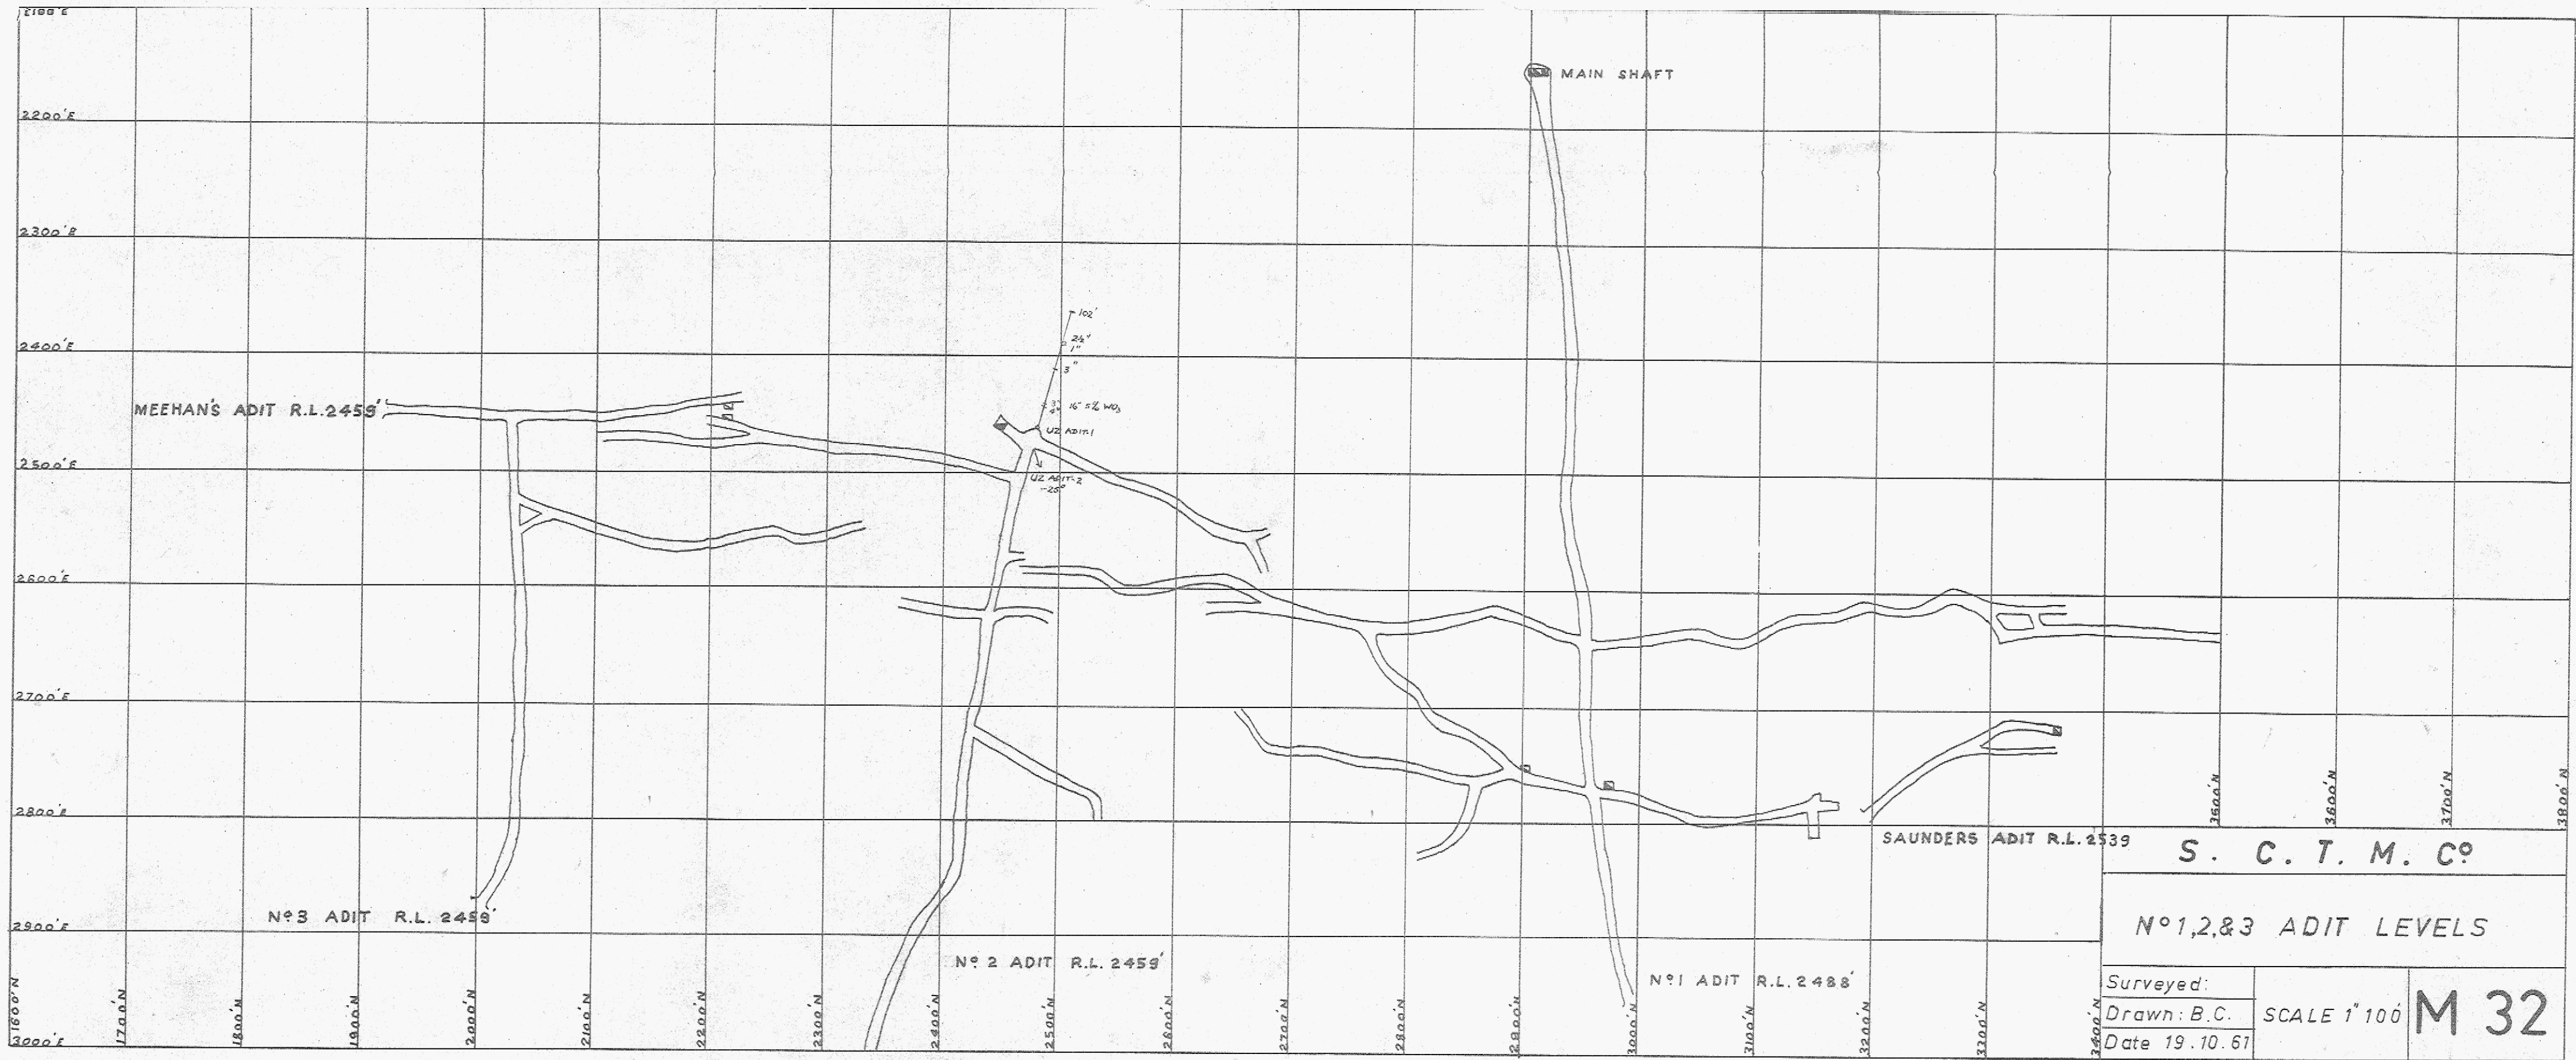

S. C. T. M. C ^o		
N°1,2,&3 ADIT LEVELS		
Surveyed:	SCALE 1" 100'	M 32
Drawn: B.C.		
Date 19.10.61		