


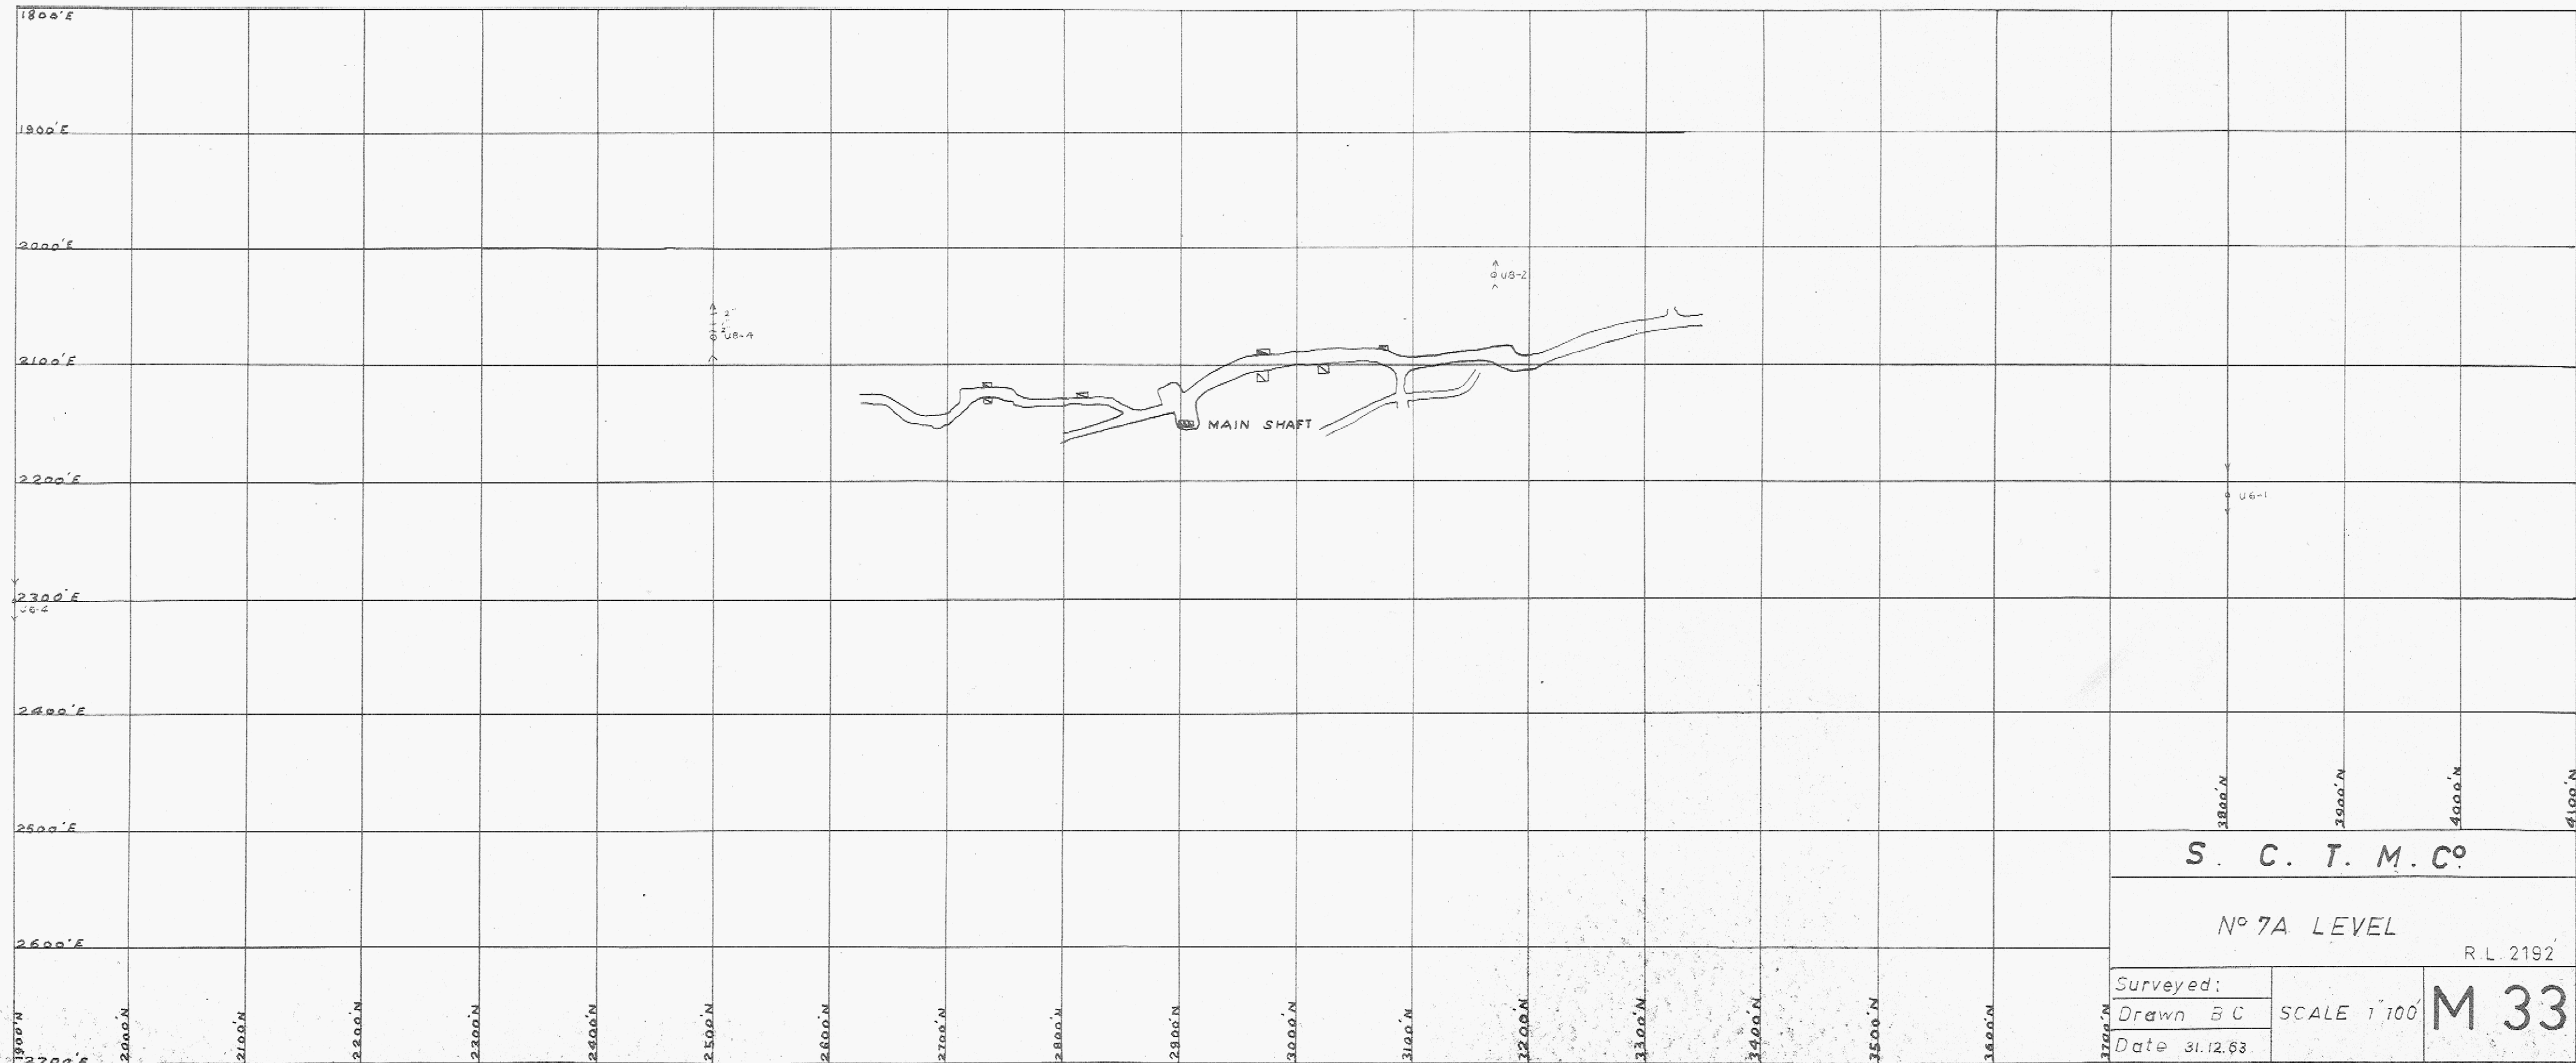

S. C. T. M. CO.

N° 7A LEVEL

R.L. 2192

Surveyed:
Drawn B.C.
Date 31.12.63

SCALE 1"=100'

M 33