


52-04

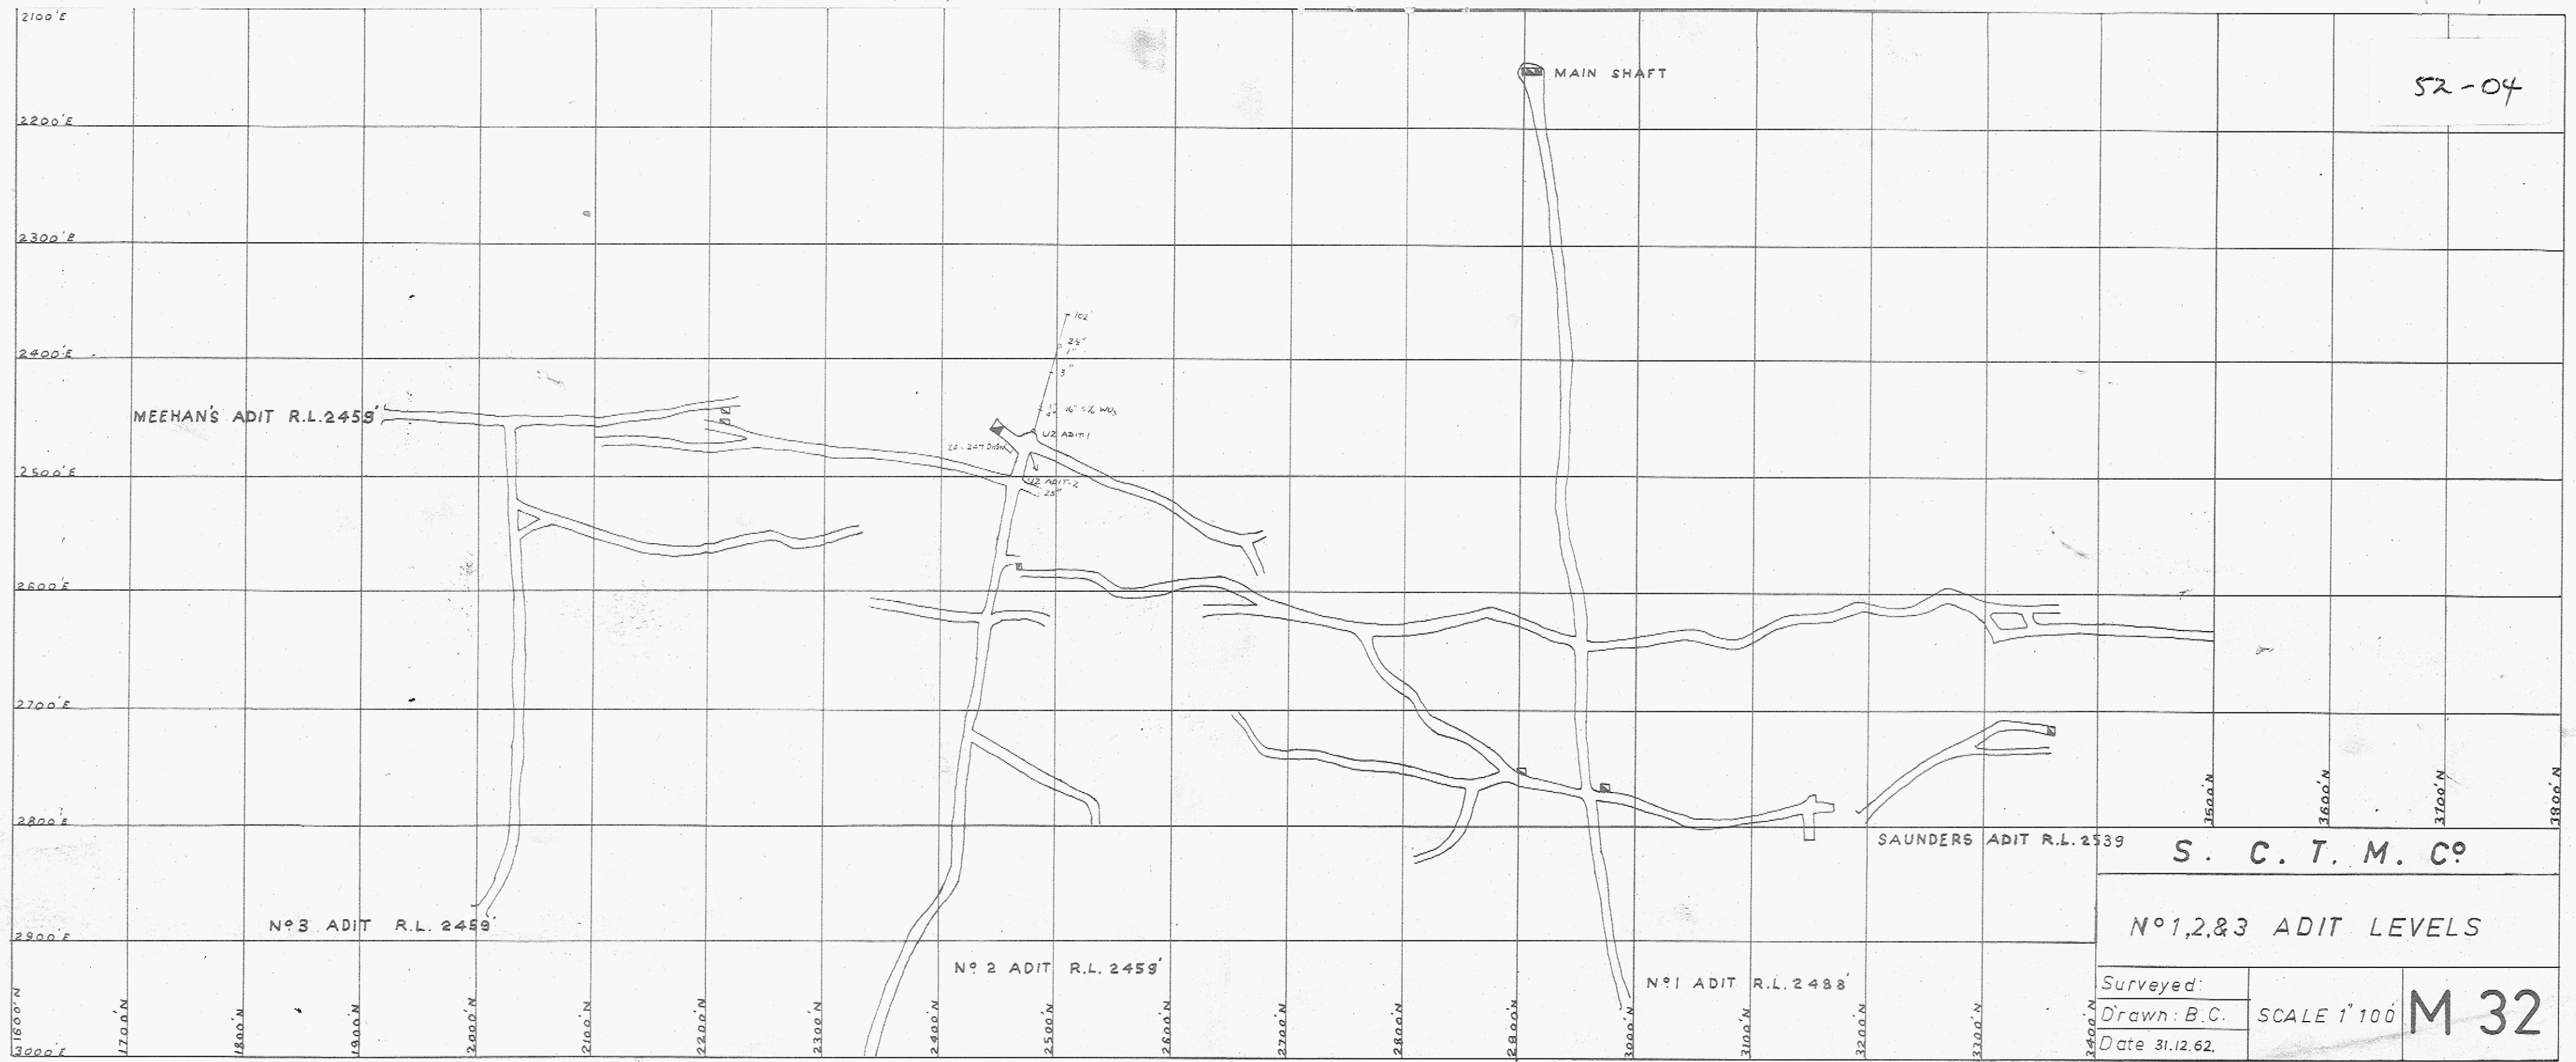

S. C. T. M. CO

Nº 1, 2, & 3 ADIT LEVELS

Surveyed:
Drawn: B.C.
Date 31.12.62.

SCALE 1" 100'

M 32