


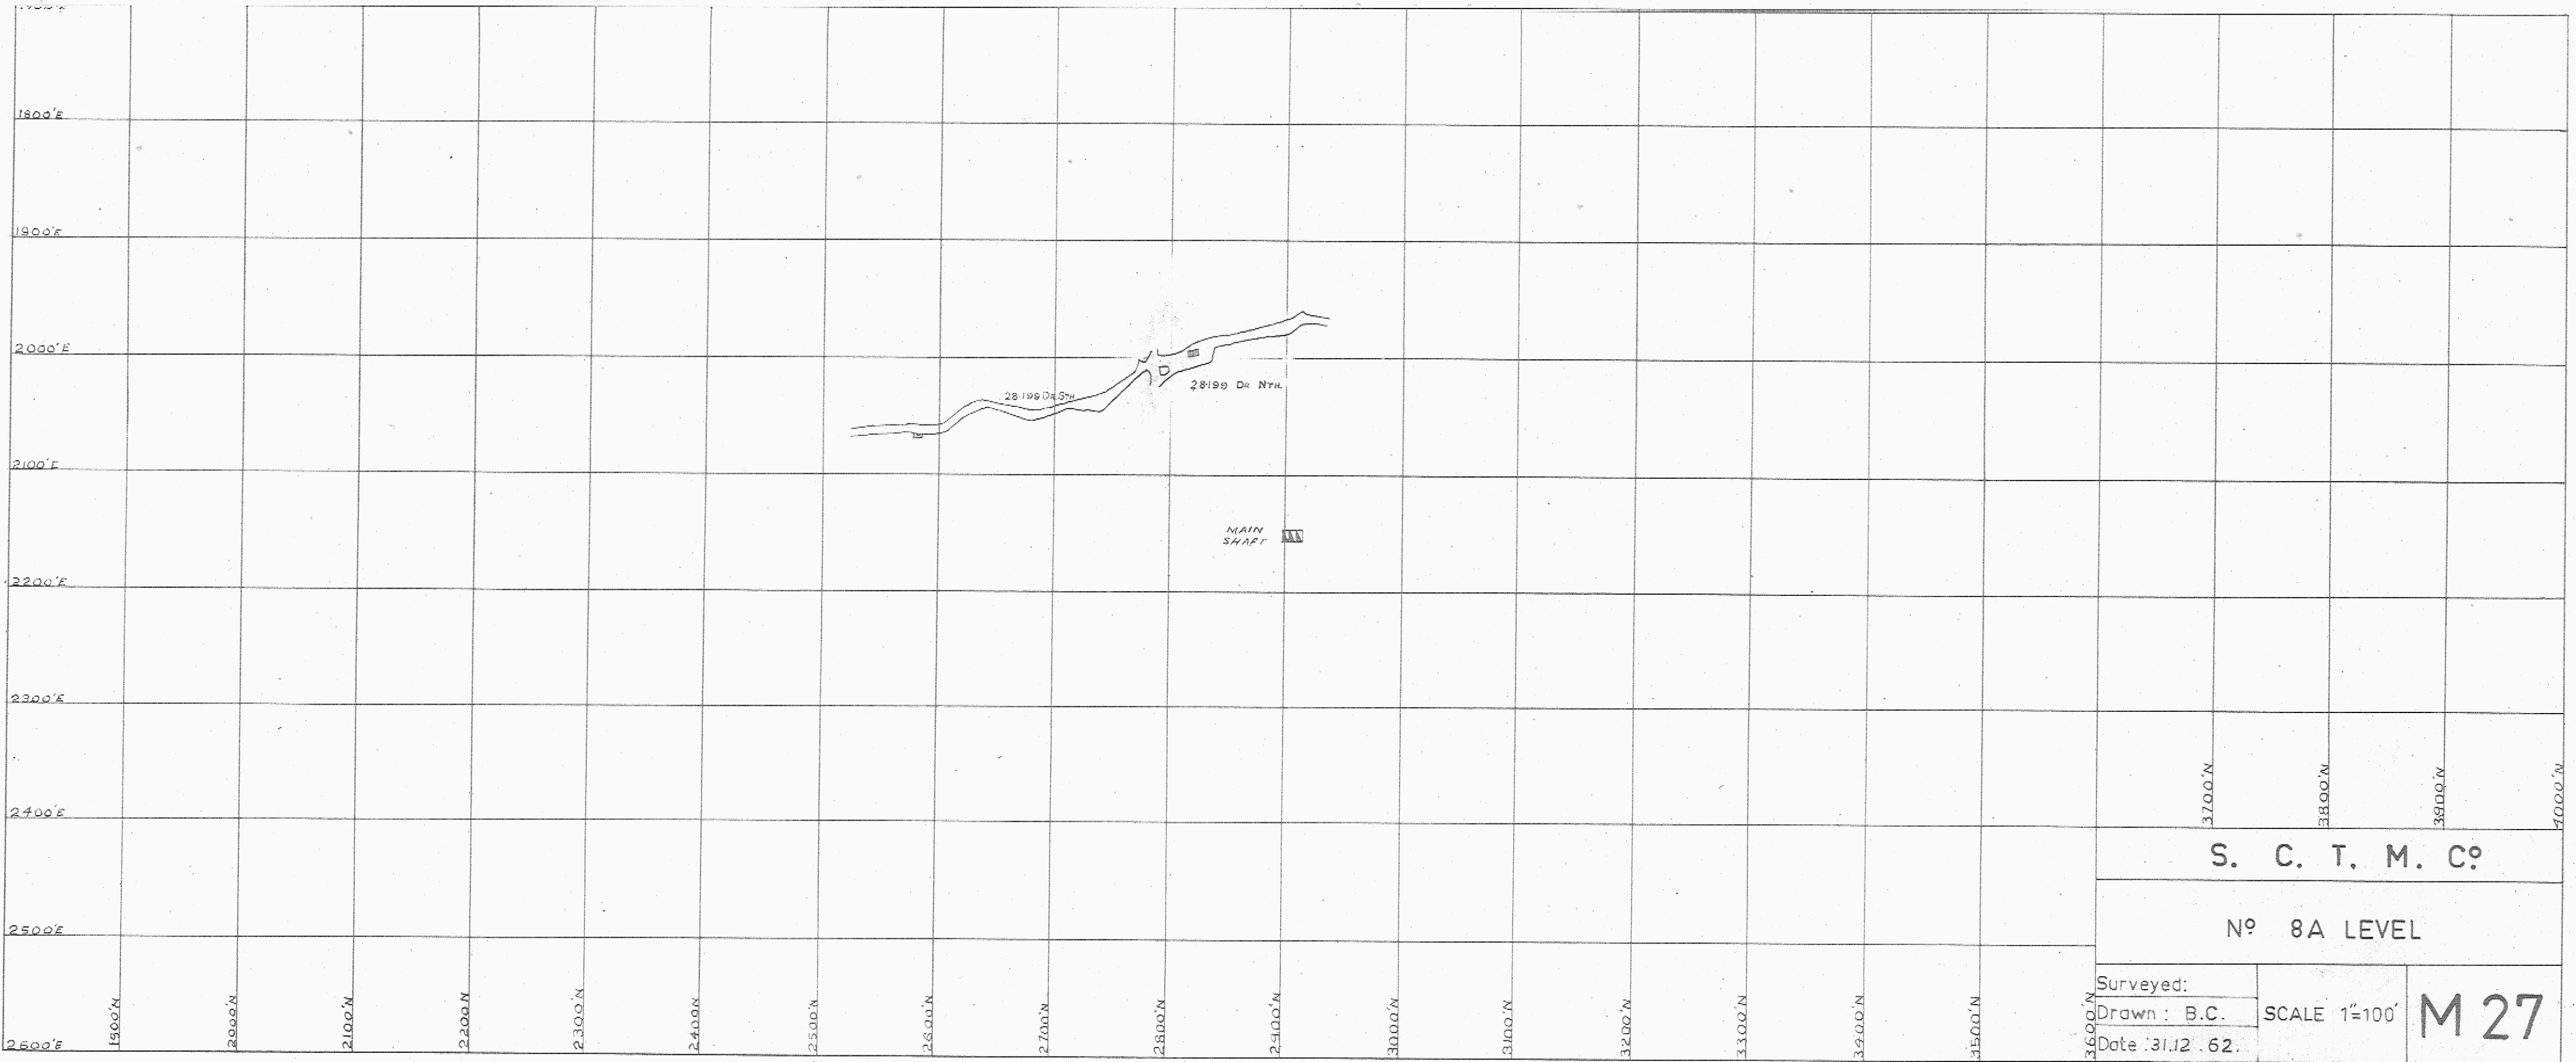

S. C. T. M. C.

Nº 8A LEVEL

Surveyed:
Drawn: B.C.
Date: 31.12.62.

SCALE 1"=100'

M 27