


SECTION through No 1 ADIT
Looking North West

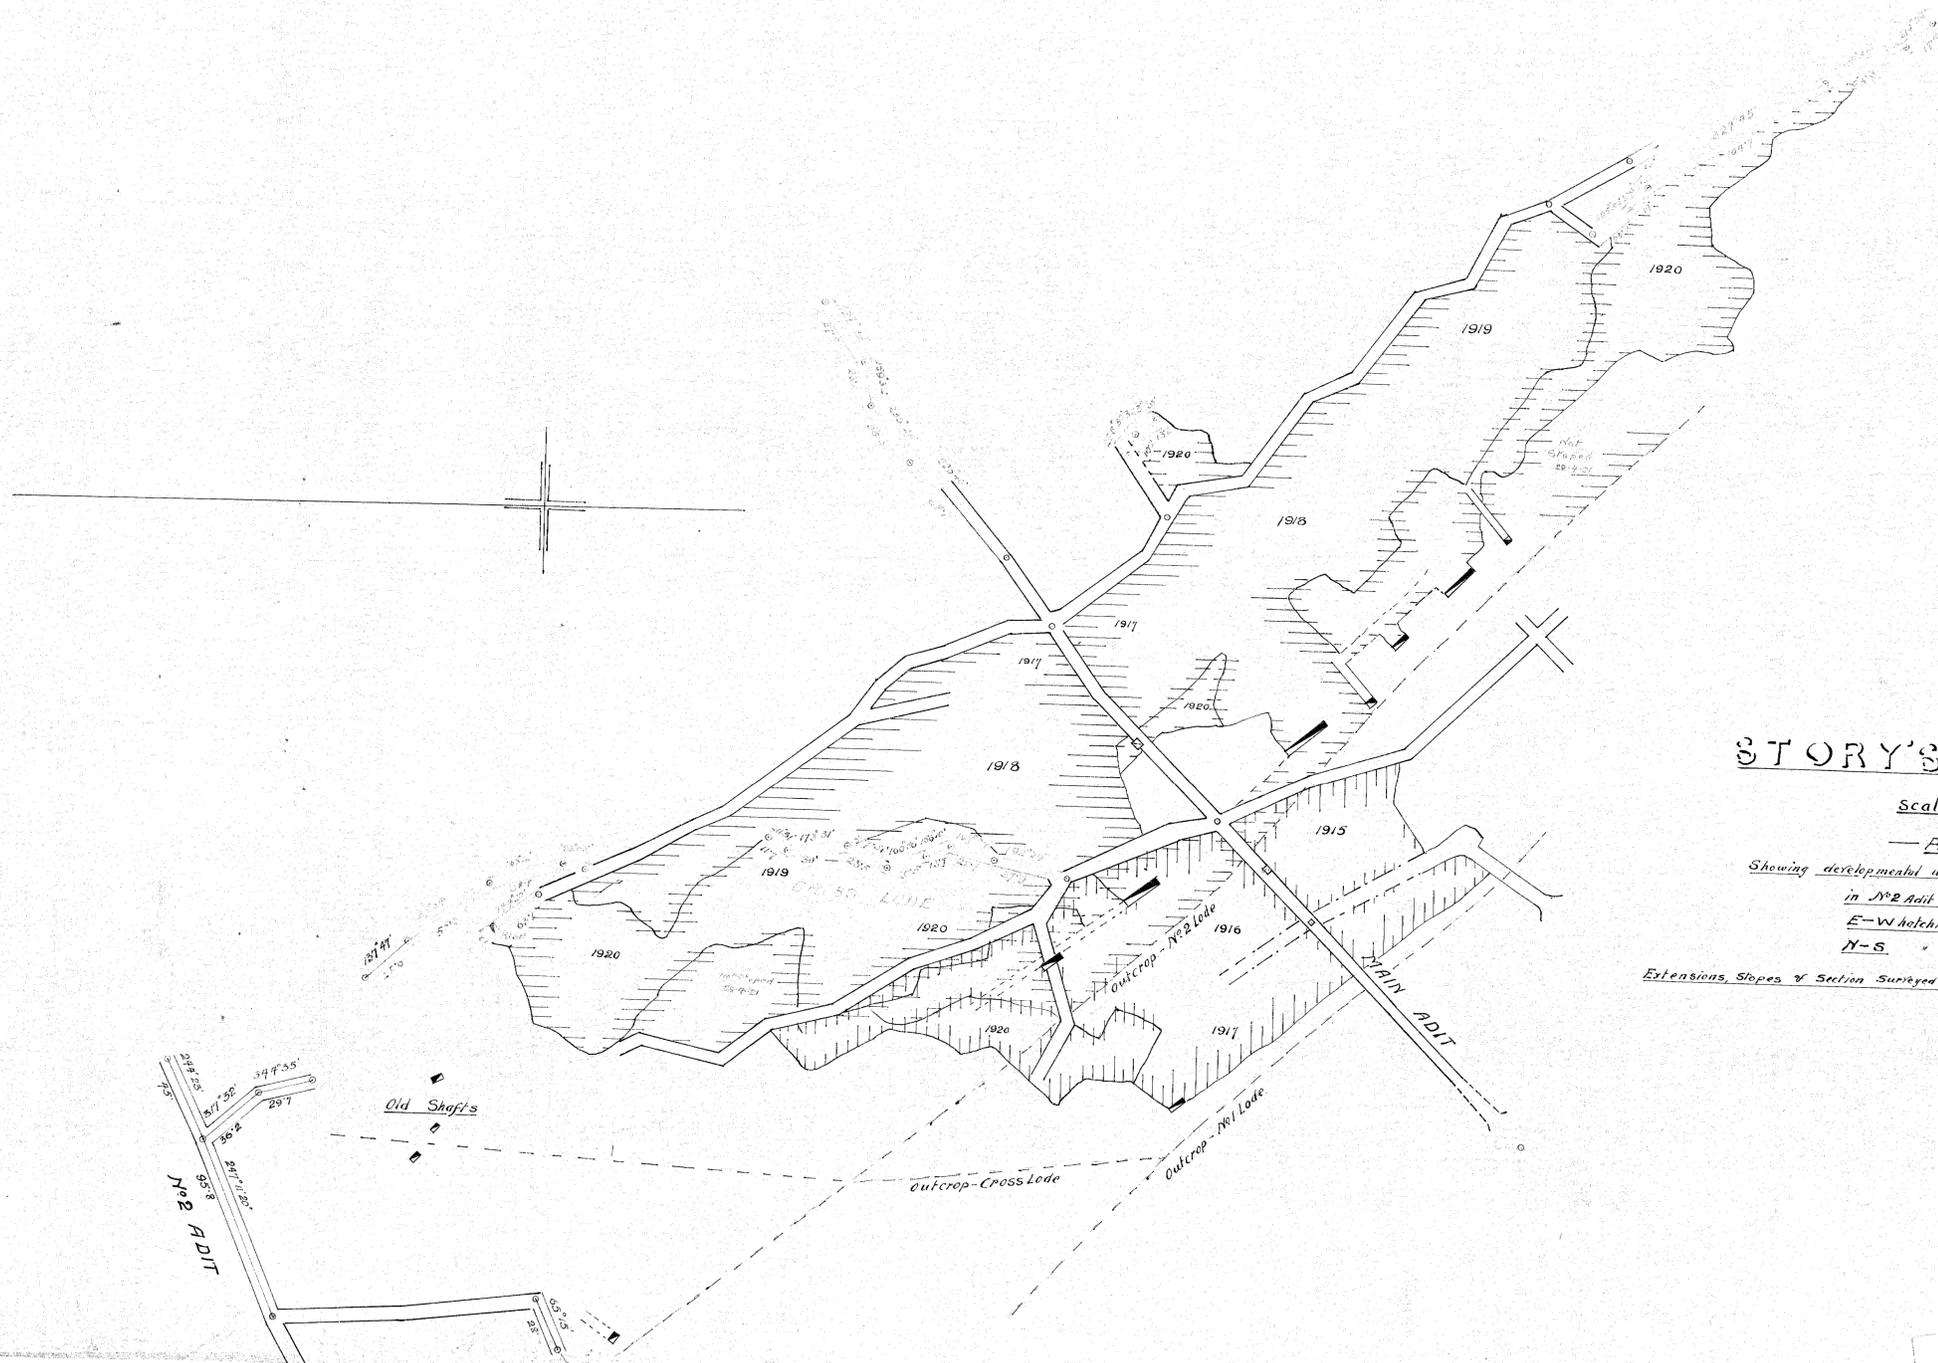

STORY'S CREEK MINE

Scale 40 ft to 1 inch.

PROVISIONAL PLAN

Showing developmental work in Main Adit workings (green) and
in No 2 Adit workings (red) for 1919-20.

E-W hatching = Sloping on No 1 lode

N-S " " " " No 2 lode

Extensions, Slopes & Section Surveyed with Zeiss theodolite and a prismatic compass by

John H. Hillis
Planner
April 1921