




STORY'S CREEK TIN MINE, AVOCA.

SHEET 2 N^o 1 LEVEL

PLAN

SCALE-40 FEET TO 1 INCH

N^o 1 LEVEL Jan. 16th 1925
(Datum Line, A-B on Ground Level)

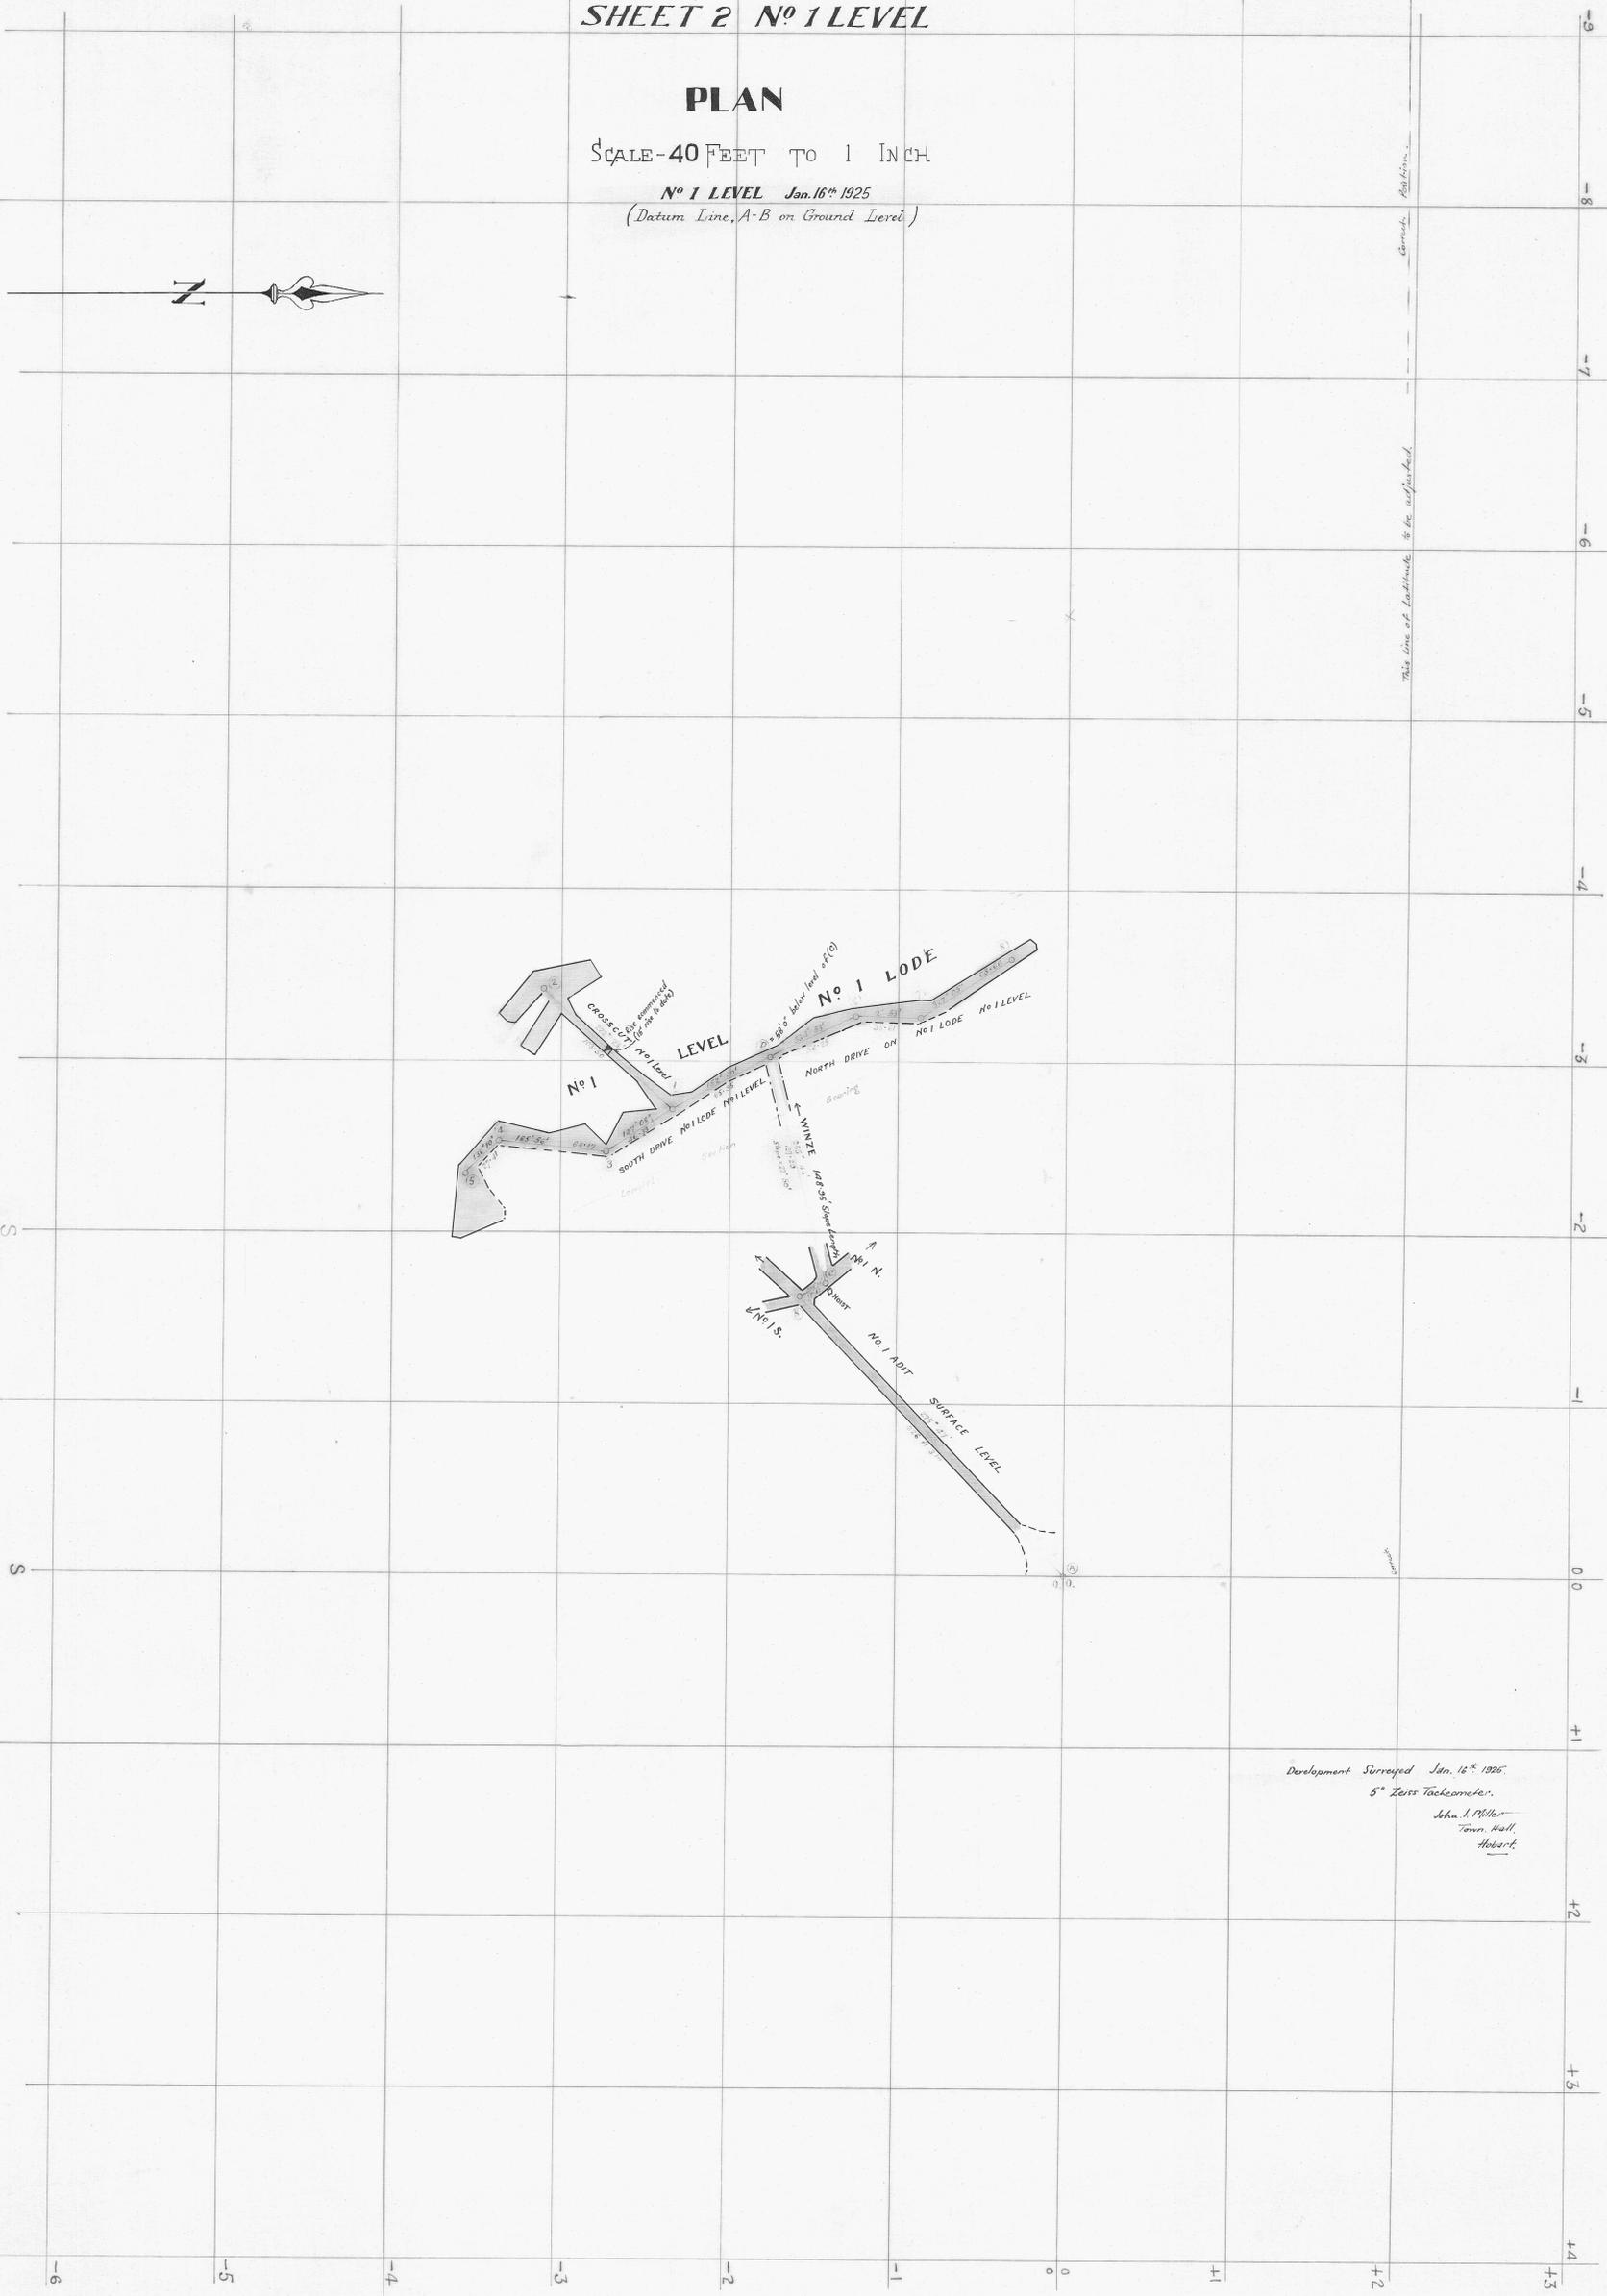

Development Surveyed Jan. 16th 1925.
5" Zeiss Tachometer.
John J. Miller
Tenn. Hall,
Hobart.

12-A-15