

STORY'S CREEK TIN MINE, AVOCA.

SHEET N° 1: SURFACE LEVEL

PLAN

SCALE-40 FEET TO 1 INCH
DEVELOPMENT TO DATE APRIL 1ST 1923

N° 0. SURFACE LEVEL



Surveyed by John S. Miller
April 1st 1923

Instrument
= 5" Zeiss theodolite.


Datum = Line A-B
from A. Mcintosh Ridge
31st March 1917 Survey.

Development Added:—
Surface level Jan. 1st 1923. J.M.
N° 1 level Jan. 15th 1925. J.M.

LONGITUDINAL SECTION

SCALE-40 FEET TO 1 INCH

DRIVE ON N° 2 LODE, MAIN LEVEL

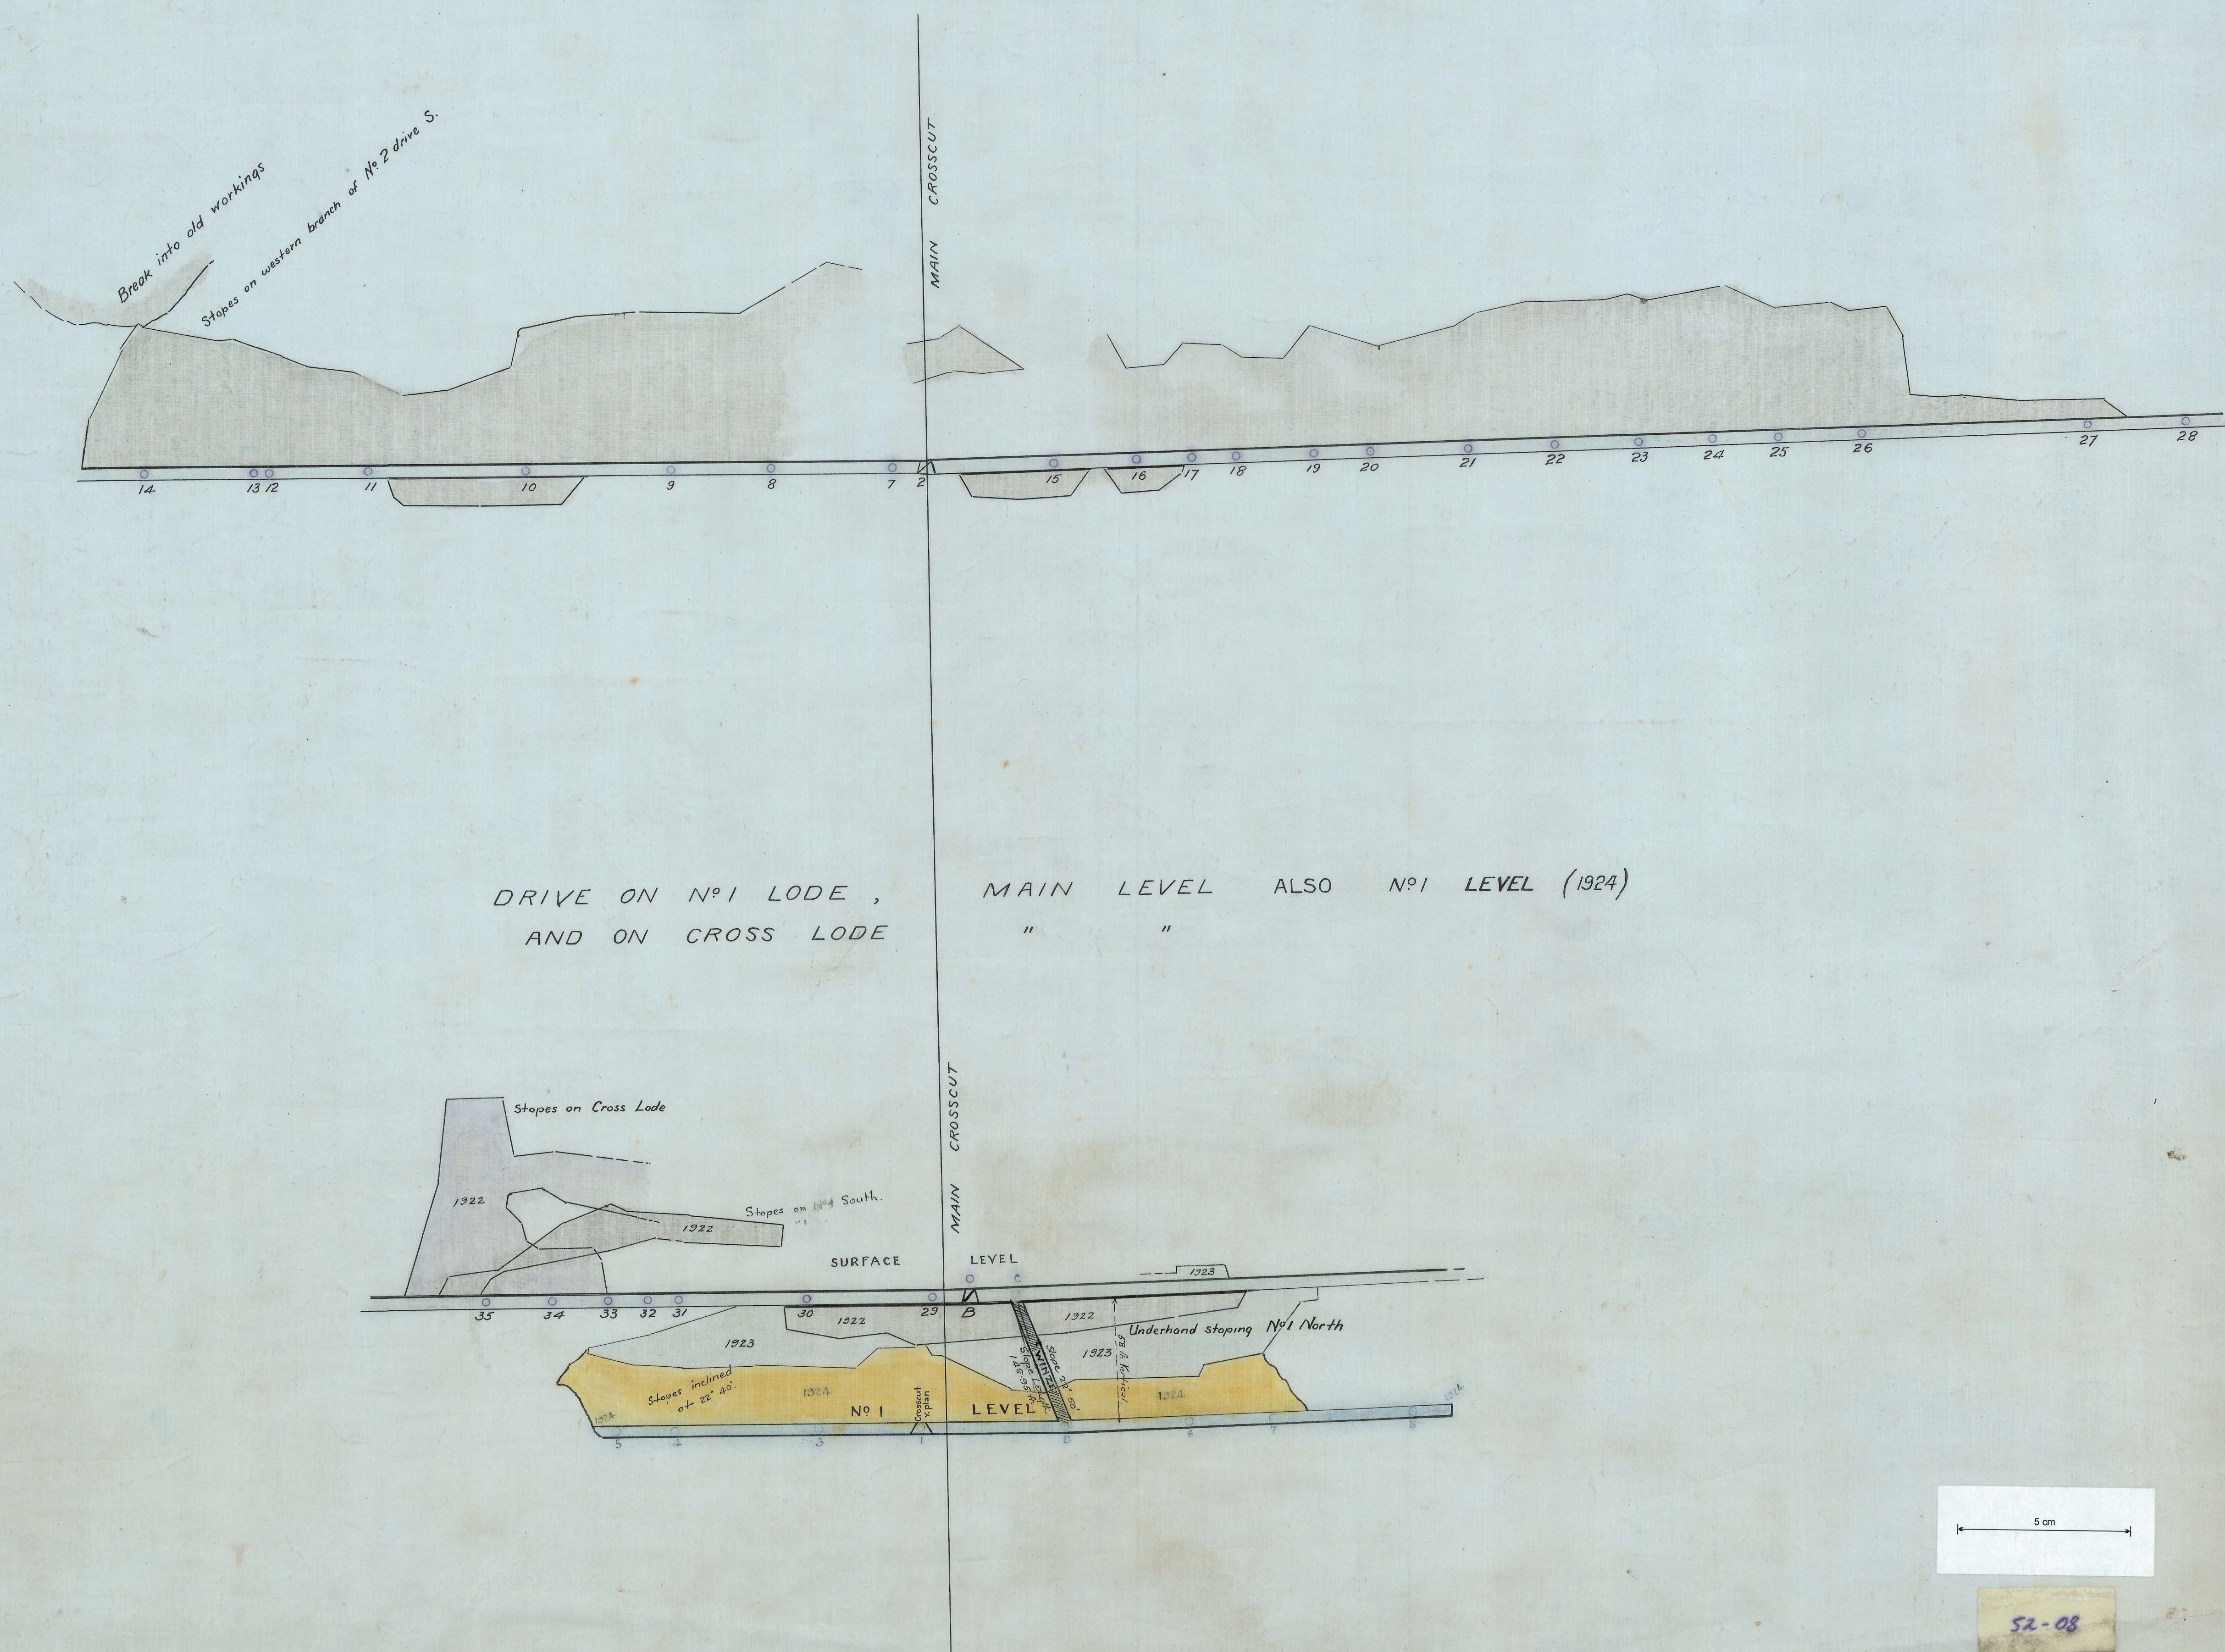

50m

52-08

80
19-9-23