


LONGITUDINAL SECTION

SCALE-40 FEET TO 1 INCH

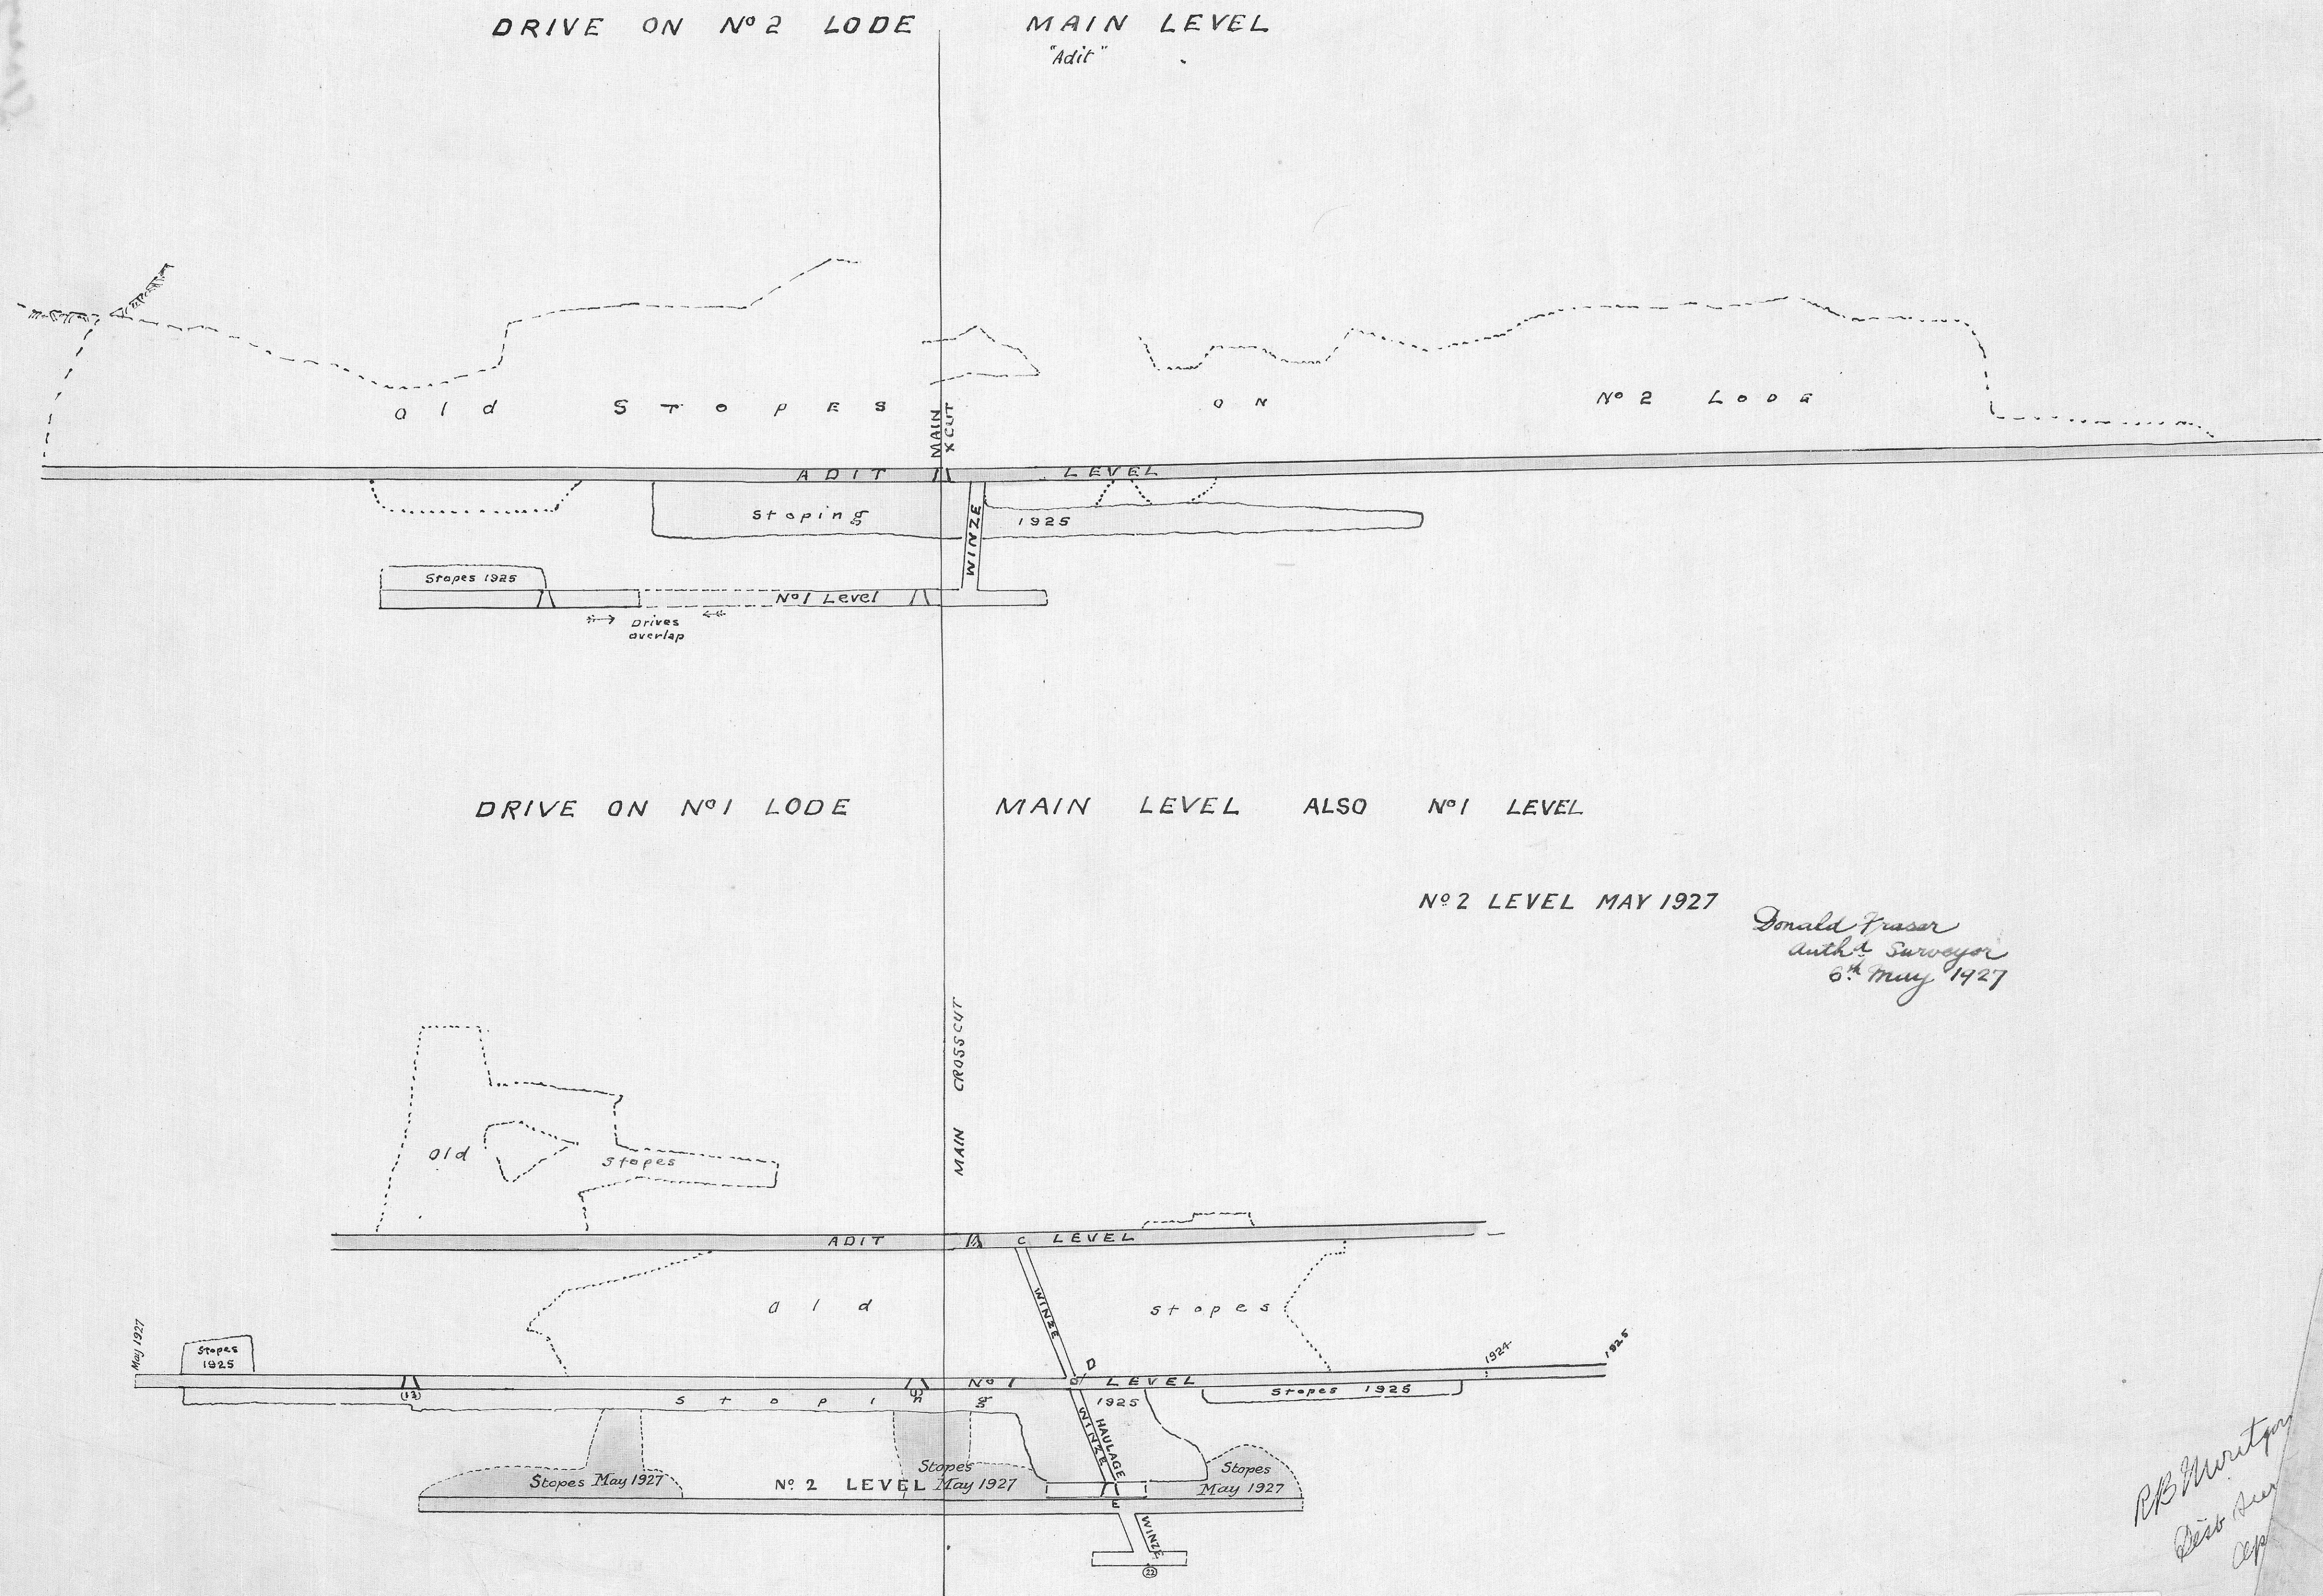

Donald Fraser
Auth. & Surveyor
6.4 May 1927

RB Muntz
Dist Sec
Cep